

COUNTY OF LYON S.S.  
 STATE OF NEVADA S.S.  
 I, WYATT J. OWENS, BEING FIRST DULY SWORN, DEPOSE AND SAY THAT THIS MAP, CONSISTING OF ONE SHEET, HAS BEEN CORRECTLY DRAWN TO THE DESIGNATED SCALE FROM FIELD NOTES OF A SURVEY MADE UNDER MY SUPERVISION AND DIRECTION ON THE SECOND DAY OF MAY, 1977 AND THAT IT TRULY AND CORRECTLY REPRESENTS THE LOCATION AND EXTENT OF THE WORKS USED TO DIVERT WATER FROM AN UNDERGROUND SOURCE IN LYON COUNTY BY LYON COUNTY FOR IRRIGATION PURPOSES. THAT THE POINT OF DIVERSION, THE LOCATION OF THE DIVERTING CHANNELS, ALL RESERVOIRS AND BASINS, THE LOCATIONS AND NAMES OF ALL OTHER WORKS WHICH CROSS OR CONNECT WITH THE WORKS, AND THE BOUNDARY OF ALL LANDS, SHOWING BY 40-ACRE SUBDIVISION THE ACRES IRRIGATED ARE FULLY AND CORRECTLY DESIGNATED THEREON.


*Wyatt J. Owens*  
 STATE WATER RIGHT SURVEYOR

SUBSCRIBED AND SWORN TO BEFORE ME THIS 5th DAY OF May, 1977.

*Yvonne Marie Owens*



SCALE 1"=100'

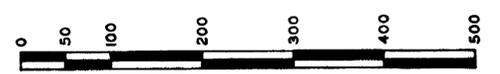

**LEGEND**  
 --- IRRIGATION DITCH  
 - - - - - PIPE LINE

SECTION	SUBDIVISION	TOWNSHIP	RANGE	CULTIVATED ACREAGE	DESCRIPTION OF CULTURE	DATE OF FIRST CULTURE
30	NW1/4 SE1/4	11N	24E	9.16	TREES AND SHRUBS	

**FILED**  
 MAY 6 1977  
 STATE ENGINEER'S OFFICE

OFFICE  
 STATE ENGINEER

BASIS OF BEARINGS IS STATE HIGHWAY 3

CERTIFICATE NO. ~~26937~~ ISSUED ~~1977~~

MAP  
 TO ACCOMPANY PROOF OF BENEFICIAL USE  
 UNDER APPLICATION 26937  
 FOR IRRIGATION USE  
 FROM UNDERGROUND SOURCE  
 BY LYON COUNTY

26937