


CULTURAL TABULATION						
PERMIT	SEC.	SUBDIVISION	ACRES	USE	ADJACENT	OWNER
4144	10	SW1/4 SW1/4	37.5	ALFALFA	SW1/4	WRIGHT
39599	3	NW1/4 NW1/4	20.36	GRAIN	NW1/4	WRIGHT
39599	10	SW1/4 SW1/4	37.5	ALFALFA	SW1/4	WRIGHT

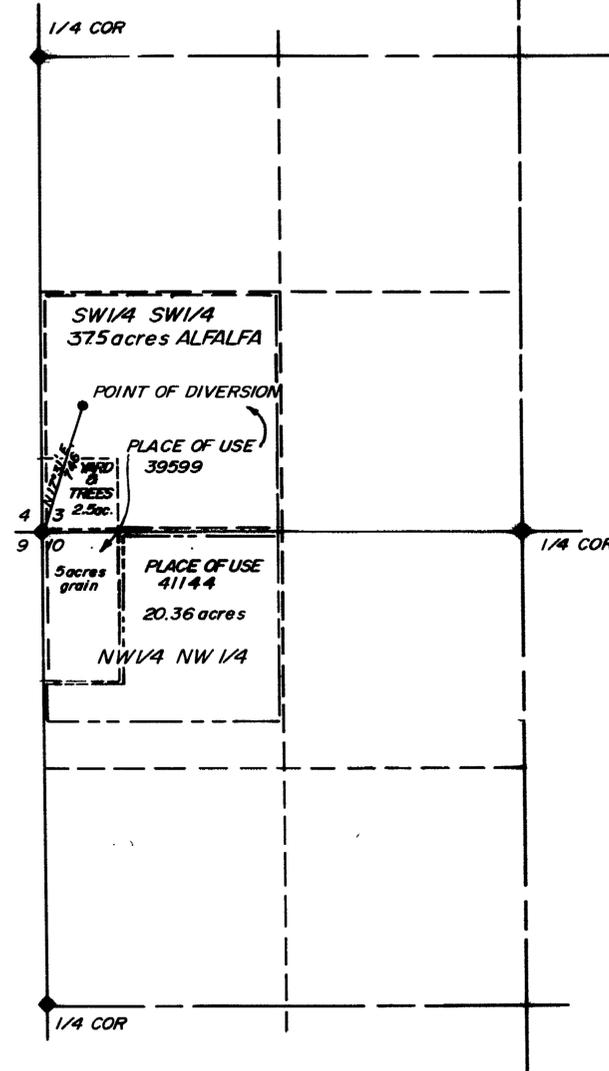

T. 4 S., R. 36 E.


STATE OF California
COUNTY OF Merced

I, BRUCE L. RICE, BEING FIRST FULLY SWORN, DEPOSE AND SAY THAT THIS MAP, CONSISTING OF ONE SHEET, HAS BEEN CORRECTLY DRAWN TO THE DESIGNATED SCALE FROM FIELD NOTES OF A SURVEY MADE BY ME ON AUGUST 12, 1961, THAT IT TRULY AND CORRECTLY REPRESENTS THE PROPOSED LOCATION AND EXTENT OF THE WORKS USED TO DIVERT WATER FROM AN UNDERGROUND SOURCE IN CONERALFA COUNTY (WILLIAM S. WRIGHT PERMIT FOR IRRIGATION UNDER PERMITS 41144) THAT THE POINT OF DIVERSION, THE LOCATION, SIZE OF THE DIVERTING CHANNEL, LOCATION AND DESCRIPTION OF ALL MEASURING DEVICES, THE LOCATION AND EXTENT OF LANDS OWNED OR CONTROLLED BY THE APPLICANT UPON WHICH WATER APPLIED FOR UNDER PERMIT 41144 IS USED, TOGETHER WITH THE AREA AND KIND OF CULTURE IN EACH 40-ACRE SUBDIVISION, AND THE LOCATION AND NAMES OF ALL OTHER WORKS OR STREAMS WHICH ARE CROSSED BY OR CONNECTED WITH SAID WORKS ARE FULLY AND CORRECTLY DESIGNATED THEREON.

Bruce L. Rice
STATE WATER RIGHT SURVEYOR

SUBSCRIBED AND SWORN TO BEFORE ME
THIS 24 DAY OF August 1961
NOTARY PUBLIC IN AND FOR

W. Meade

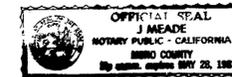

BASIS OF BEARING:
MAGNETIC NORTH
V = 16° 30' EAST

◆ FOUND USBLM BRASS CAP

SCALE: 1" = 400'



FILED
AUG 24 1961
STATE ENGINEER'S OFFICE

MAP
TO ACCOMPANY PROOF OF BENEFICIAL
USE UNDER PERMITS 41144 & 39599
FROM: AN UNDERGROUND SOURCE
FOR: IRRIGATION & DOMESTIC
BY: WILLIAM S. WRIGHT, JR. &
PATRICIA M. WRIGHT

~~39599~~ CERTIFICATE NO. ~~41144~~ ISSUED ~~7/24/61~~

~~41144~~ CERTIFICATE NO. ~~39599~~ ISSUED ~~7/24/61~~

BRUCE L. RICE
CIVIL ENGINEER & SURVEYOR
STATE ENGINEER'S OFFICE

41144 39599