



**HIGH DESERT ENGINEERING LLC**  
 CONSULTING ENGINEERING & SURVEYING  
 640 IDAHO STREET  
 ELKO, NEVADA 89801  
 (775) 738-4053

W208027

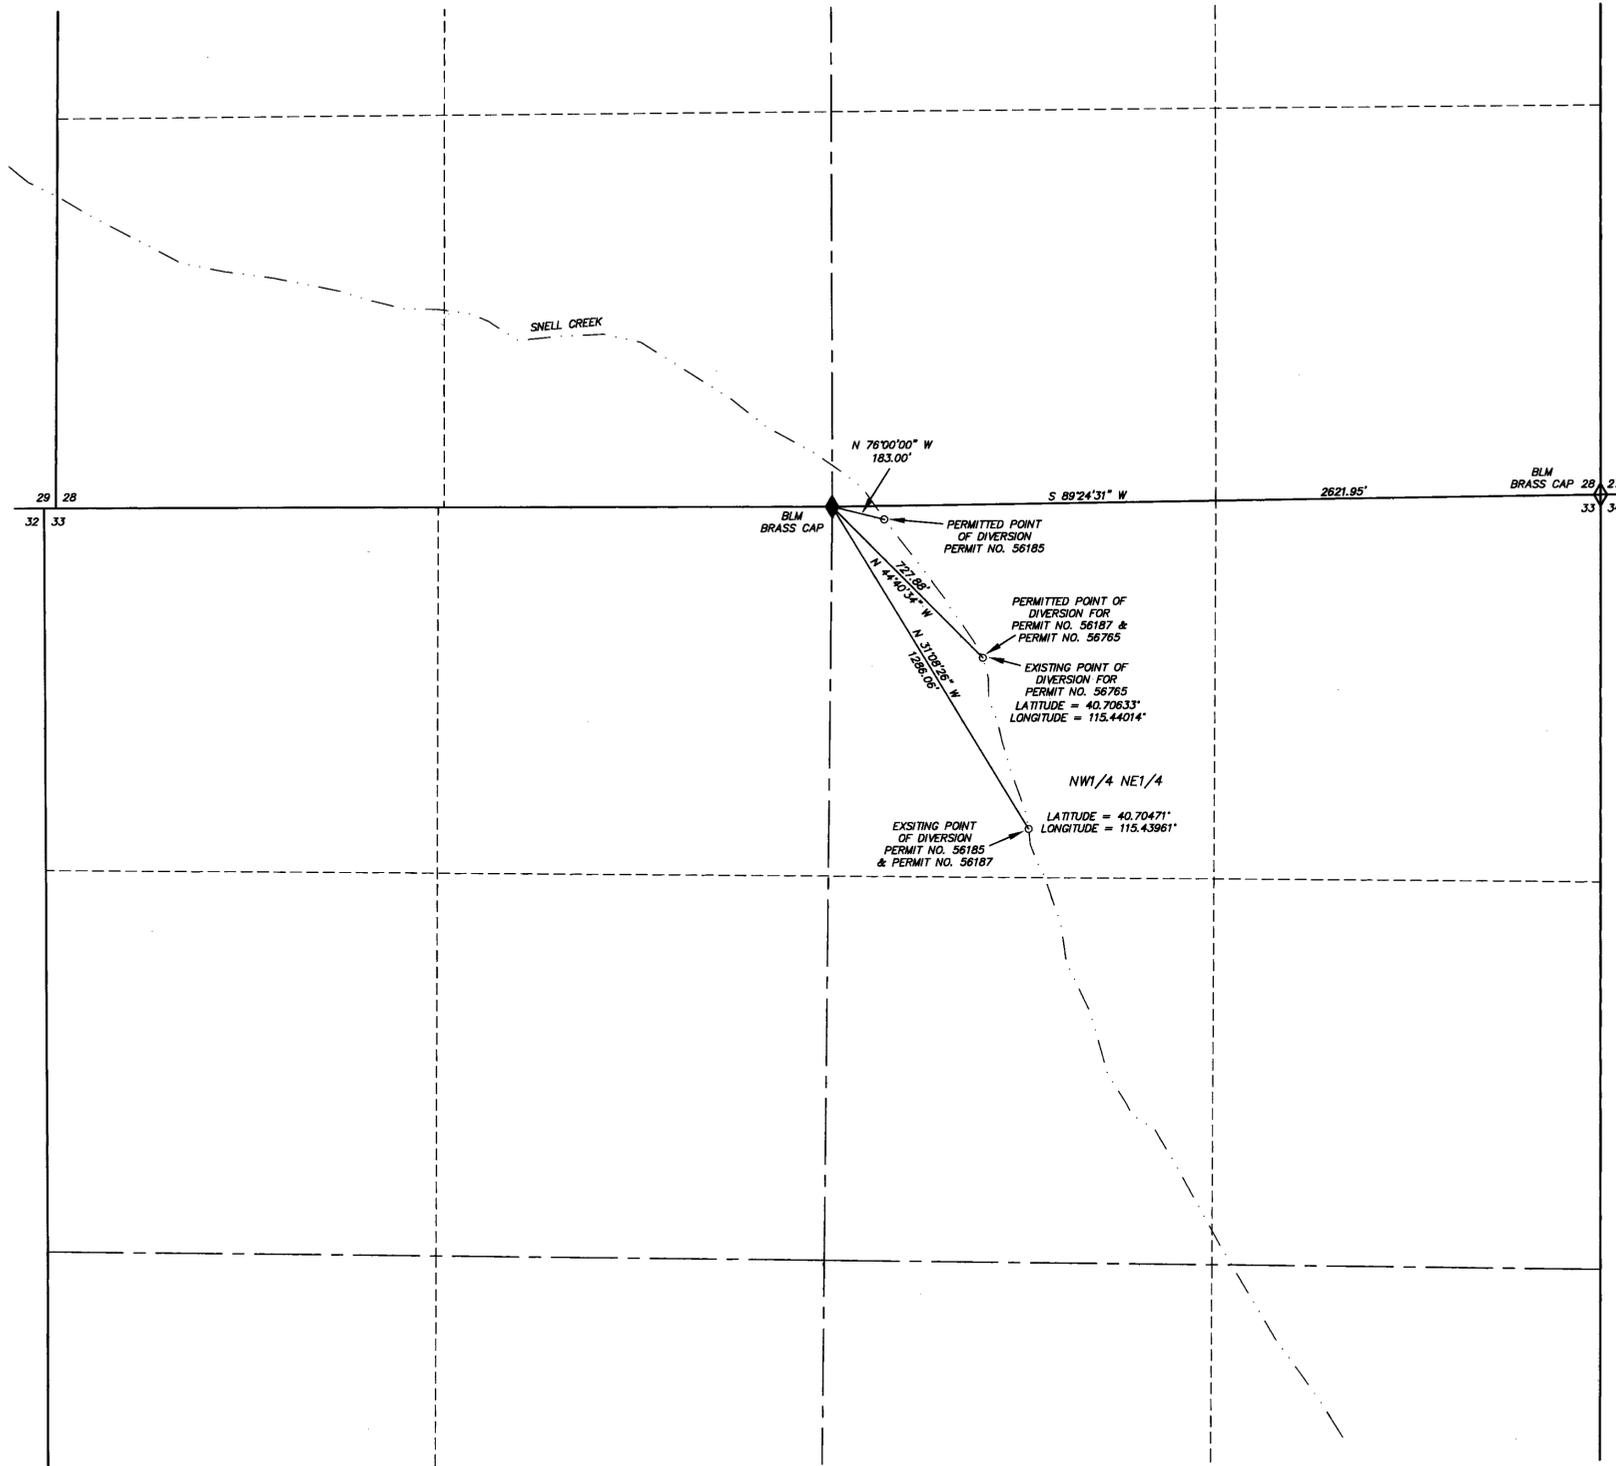

STATE OF NEVADA } SS.  
 COUNTY OF ELKO }

I, ROBERT E. MORLEY, BEING FIRST DULY SWORN, DEPOSE AND SAY THAT THIS MAP, CONSISTING OF 1 SHEET, NUMBERED FROM 1 TO 1, INCLUSIVE, HAS BEEN CORRECTLY DRAWN TO THE DESIGNATED SCALE FROM SURVEYING CALCULATION NOTES PREPARED BY ME, OR UNDER MY SUPERVISION AND DIRECTION, RELYING UPON ANALYSIS OF RECORDED SURVEY MAPS AND OTHER RECORDED SURVEYING DOCUMENTS IN THE OFFICE OF THE STATE ENGINEER AND THE BUREAU OF LAND MANAGEMENT, BETWEEN THE 12TH DAY OF NOVEMBER, 2008, AND THE 13TH DAY OF NOVEMBER, 2008; THAT THIS MAP TRULY AND CORRECTLY REPRESENTS THE PROPOSED LOCATION AND EXTENT OF THE WORKS USED TO DIVERT WATER FROM SNELL CREEK, IN ELKO COUNTY, NEVADA, BY TOMERA RANCHES, INC. AND DELL R. NIELSON FAMILY TRUST, FOR IRRIGATION AND DOMESTIC PURPOSES. THAT THE PROPOSED POINT OF DIVERSION, THE APPROXIMATE LOCATION AND SIZE OF THE DIVERTING CHANNEL OR OTHER CONDUIT, THE PLACE AND MANNER OF USE, AND THE LOCATION AND NAMES OF ALL OTHER WORKS OR STREAMS WHICH ARE CROSSED BY, OR CONNECTED WITH THE SAID WORKS, ARE FULLY AND CORRECTLY DESIGNATED THEREON.

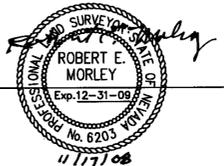

STATE WATER RIGHT SURVEYOR NO. 668

SUBSCRIBED AND SWORN TO BEFORE ME  
 THIS 17th DAY OF November, 2008.

*Charlene A. Jones*


NOTARY PUBLIC IN AND FOR ELKO COUNTY, NEVADA.  
 MY COMMISSION EXPIRES Feb. 8, 2010



BASIS OF BEARINGS: THE LINE BETWEEN THE FOUND NORTH 1/4 CORNER AND NORTHEAST CORNER OF SECTION 33, T.33 N., R.58 E., M.D.B. & M., AS SHOWN ON THE PARCEL MAP FOR TOMERA RANCHES, INC., LAND ILLI DISTRICT, ON FILE IN THE OFFICE OF THE ELKO COUNTY RECORDER, ELKO, NEVADA, FILE NO. 522085, TAKEN AS S 89° 24' 31" W.

LEGEND

- ◇ = FOUND SECTION CORNER AS NOTED.
- ◆ = FOUND 1/4 CORNER AS NOTED.

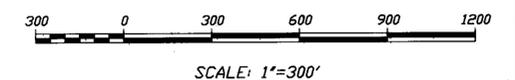

T.33 N., R.58 E.  
 M.D.B. & M.

56185 CERTIFICATE NO. 17792 ISSUED 12-29-10

56187 CERTIFICATE NO. 17793 ISSUED 12-29-10

STATE ENGINEERS USE

10/5/2010 THIS MAP IS FILED IN SUPPORT OF ACTUAL AS-BUILT LOCATION OF THE POINT OF DIVERSION FOR PERMITS 56185 AND 56187, ONLY! S. CLARK

SHEET 1 OF 2

SEE MAP 2 OF 2 IN SUPPORT OF THE PLACE OF USE IN CULTURE AS ISSUED UNDER PERMITS 56185 AND 56187.

56185, 56187, 56765

**FILED**  
 NOV 19 2008  
 STATE ENGINEER'S OFFICE

STATE ENGINEER'S OFFICE  
 12-11-10 61 NOV 0007

MAP TO ACCOMPANY PROOF OF BENEFICIAL USE  
 UNDER PERMIT NO. 56185, PERMIT NO. 56187  
 AND PERMIT NO. 56765  
 FOR IRRIGATION AND DOMESTIC USE  
 BY JULIAN TOMERA RANCHES, INC. AND  
 DELL R. NIELSON FAMILY TRUST  
 FROM SNELL CREEK  
 IN ELKO COUNTY, NEVADA

56187 56185

