

PLACE OF BENEFICIAL USE SURVEY RESULTS
SECTION 23, TOWNSHIP 4 SOUTH, RANGE 36 EAST
MOUNT DIABLO MERIDIAN, STATE OF NEVADA

CULTURAL MAP TABULATION

SECTION	SUBDIVISION	TOWNSHIP	RANGE	CULTIVATED ACREAGE	DESCRIPTION OF CULTURE	DATE OF 1ST CULTURE
23	SW1/4 NW1/4	4S	36E	30.64	ALFALFA	
23	SE1/4 NW1/4	4S	36E	30.42	ALFALFA	
23	NW1/4 SW1/4	4S	36E	30.57	ALFALFA	
23	NE1/4 SW1/4	4S	36E	30.29	ALFALFA	
23	SW1/4 SW1/4	4S	36E	6.16	ALFALFA	
23	SE1/4 SW1/4	4S	36E	27.57	ALFALFA	
TOTAL ACRES				155.65		

CONVENTIONAL MAP SYMBOLS

- RIVERS OR PERPETUAL STREAMS
- MAIN SUPPLY DITCHES OR CANALS
- SECONDARY OR LATERAL DITCHES
- DAMS, BRIDGES
- INTERSECTING DITCHES OR CANALS
- TRAVERSE LINES
- TIE LINES
- PLACE OF BENEFICIAL USE
- PROTRACTED SECTION LINES (NO BLM SURVEY)
- ROADS
- FENCES
- RAILROADS
- BUILDINGS

MONUMENTATION & RELATED MAP SYMBOLS

- FOUND 1953 BLM BRASS MONUMENT SECTION CORNER
- FOUND 1953 BLM BRASS MONUMENT 1/4 SECTION CORNER, OR AS NOTED
- POINT OF DIVERSION

BASIS OF BEARINGS

BASIS OF BEARINGS FOR THIS MAP IS S89°55'31"E, THE MEASURED LINE BETWEEN THE FOUND SOUTHWEST SECTION CORNER AND THE SOUTH ONE-QUARTER CORNER AS SHOWN HEREON USING GLOBAL POSITIONING MEASUREMENT METHODS. THE RETRACEMENT BEARING THEREFORE DEPICTS A GEODETIC AZIMUTH BETWEEN THE MONUMENTS SHOWN HEREON IN THE IN THE DIRECTION SHOWN.


THE MEASUREMENTS CONFORM TO "GPS, 5-METERS OR LESS PRECISION".

REFERENCES


- GUIDELINES AND RULES FOR THE PREPARATION OF WATER RIGHTS MAPS (REVISED SEPTEMBER 2003).
- NRS 240.167, 327, 329, 533, 625 (ALSO NAC, AS APPLICABLE).
- RECORD OF SURVEY PREPARED BY BRUCE L. RICE, PLS., WRSFILE NO. 75191, APRIL 7, 1980.
- MAP TO ACCOMPANY PROOF OF BENEFICIAL USE UNDER PERMIT 27060 BY FRED MAURER, DTD. 9 JAN 1980.
- BUREAU OF LAND MANAGEMENT CADASTRAL PLAT APPROVED 14 APR. 1955 BY EARL C. HARRINGTON, CADASTRAL ENGINEERING STAFF OFFICER.
- QUITCLAIM DEED FROM FREDERICK SIGURD MAURER AND ELIZABETH LUCY MAURER AS HUSBAND AND WIFE TO HAROLD MAURER, FILE 105935 NOV 18, 1985.
- QUITCLAIM DEED FROM HAROLD WILLIAM MAURER TO HILLSIDE HAY COMPANY FILE 153076, MAY 9, 2000.
- QUIT CLAIM DEED FROM HILLSIDE HAY COMPANY TO HILLSIDE HAY COMPANY LLC, FILE161377, OCT. 13, 2004.

NOTES

- ORIGINAL AREA PERMITTED UNDER ORIGINAL APPROPRIATION OF PERMIT NO. 27060 IS 155.56 ACRE FEET. AREA HEREON SHOW AS BENEFICIAL USE IS 155.66 ACRES. NET CHANGE IS ZERO.
- BOUNDARY DELINEATION HEREON WAS PERFORMED USING DUAL FREQUENCY GPS EQUIPMENT TO RELIABLE STANDARDS PURSUANT TO NRS. 625.
- ALL RECORDS DELINEATED AS FILED AT LEFT ARE LOCATED IN THE ESMERALDA COUNTY, RECORDER'S OFFICE, GOLDFIELD, NEVADA.
- THIS MAP CORRECTS AN INCORRECTLY ANNOTATED LINE ON SECTION 23 BETWEEN THE EAST QUARTER AND THE NORTHEAST SECTION CORNER.

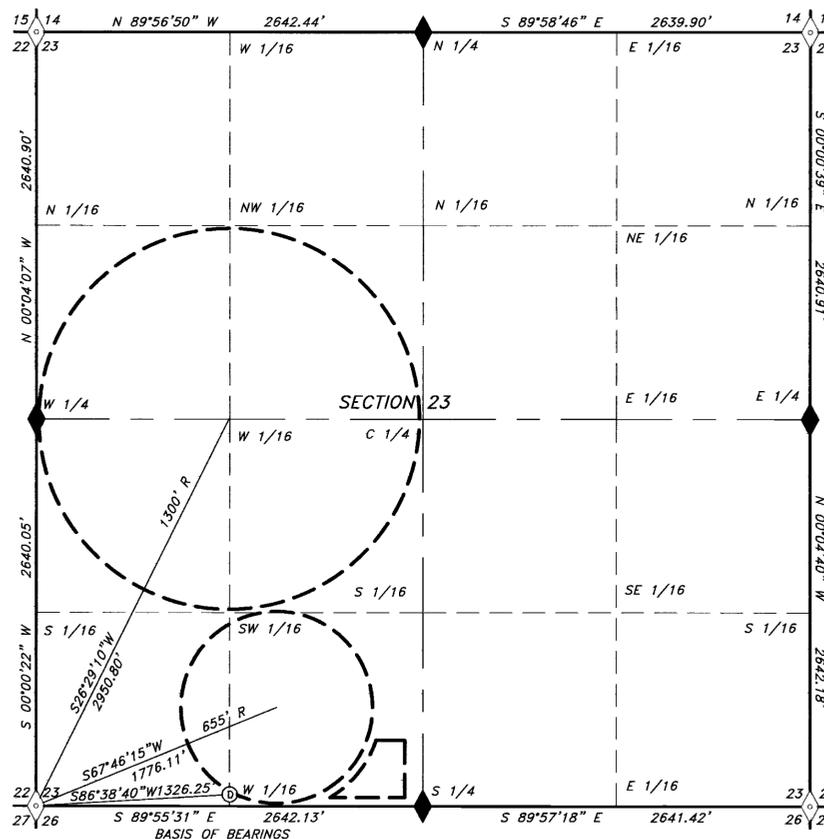

PORTIONS OF
T. 4 S.
R. 36 E.
M.D.M.

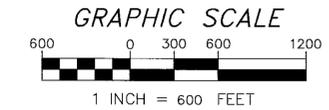

STATE WATER RIGHT SURVEYOR'S CERTIFICATE

I, TIMOTHY J. WOLF, BEING FIRST DULY SWORN, DEPOSE AND SAY THAT THIS MAP, CONSISTING OF ONE SHEET, HAS BEEN CORRECTLY DRAWN TO THE DESIGNATED SCALE FROM FIELD NOTES OF A SURVEY MADE UNDER MY DIRECT SUPERVISION AND DIRECTION, ON THE 1ST DAY OF MAY, 2011; THAT IT TRULY AND CORRECTLY REPRESENTS THE PLACE OF BENEFICIAL USE AND THE LOCATION AND EXTENT OF THE WORKS USED TO DIVERT WATER FROM THE POINT OF DIVERSION HEREON, BY HILLSIDE HAY COMPANY LLC FOR IRRIGATION AND DOMESTIC PURPOSES UNDER PERMIT NO. 73249. THAT THE POINT OF DIVERSION, THE LOCATION AND SIZE OF THE DIVERTING CHANNEL OR OTHER CONDUIT, LOCATION AND DESCRIPTION OF ALL MEASURING DEVICES, THE LOCATION AND EXTENT OF THE LAND OWNED OR CONTROLLED BY THE APPLICANT UPON WHICH WATER APPLIED FOR UNDER PERMIT NO. 73249 IS USED, TOGETHER WITH THE AREA AND KIND OF CULTURE IN EACH 40-ACRE SUBDIVISION, AND THE LOCATION AND NAMES OF ALL OTHER WORKS OR STREAMS WHICH ARE CROSSED BY OR CONNECTED WITH SAID WORKS ARE FULLY AND CORRECTLY DESIGNATED HEREON.

Timothy J. Wolf
TIMOTHY J. WOLF
STATE WATER RIGHT SURVEYOR
NEVADA CERTIFICATE NO. 954
AGENT, ARTISAN SPATIAL TECHNOLOGY, LLC



ATTEST:
STATE OF NEVADA } S.S.
COUNTY OF CLARK }

SIGNED OR ATTESTED BEFORE ME ON May 6, 2011 BY TIMOTHY J. WOLF.



SIGNATURE: *E. Ruecker*
PRINTED NAME: Eric Ruecker
MY COMMISSION EXPIRES: Nov 24, 13

73249 CERTIFICATE NO. 18699 ISSUED 5-23-12



Artisan Spatial Technology, LLC "Where Art & Measurement Science Converge" P.O. 35381, LAS VEGAS, NV. 89133 (702) 233-3451 http://www.ArtisanGroupUSA.com		CONTRACT: ART-HILLSIDE HAY CO. LOCATION: FISH LAKE VALLEY NAME: P73249PBU SHEET REV. DATE: 5/1/11 DRAWN: T. WOLF REVIEWED: J. WOLF H. SCALE: 1"=600' V. SCALE: N/A
--------------------------------------------------------------------------------------------------------------------------------------------------------------------------------------------------------------------	--	-----------------------------------------------------------------------------------------------------------------------------------------------------------------------------------------

MAP TO ACCOMPANY
PROOF OF BENEFICIAL USE
UNDER PERMIT NO. 73249

FOR: IRRIGATION AND DOMESTIC
BY: HILLSIDE HAY COMPANY LLC
FROM: AN UNDERGROUND SOURCE
IN: ESMERALDA COUNTY, NEVADA