


Note: Bearings shown are related to a geodetic azimuth carried into the WC. M.C. of sections 9 and 10 from 2nd order triangulation station ZEPHER (Nev. Highway Dept.) Bearings true at WC. M.C.
 Course and distance to point of diversion is approximate due to inability to accurately locate end of intake pipe. Tie to pump is precise; obtained by transit and tape traverse.

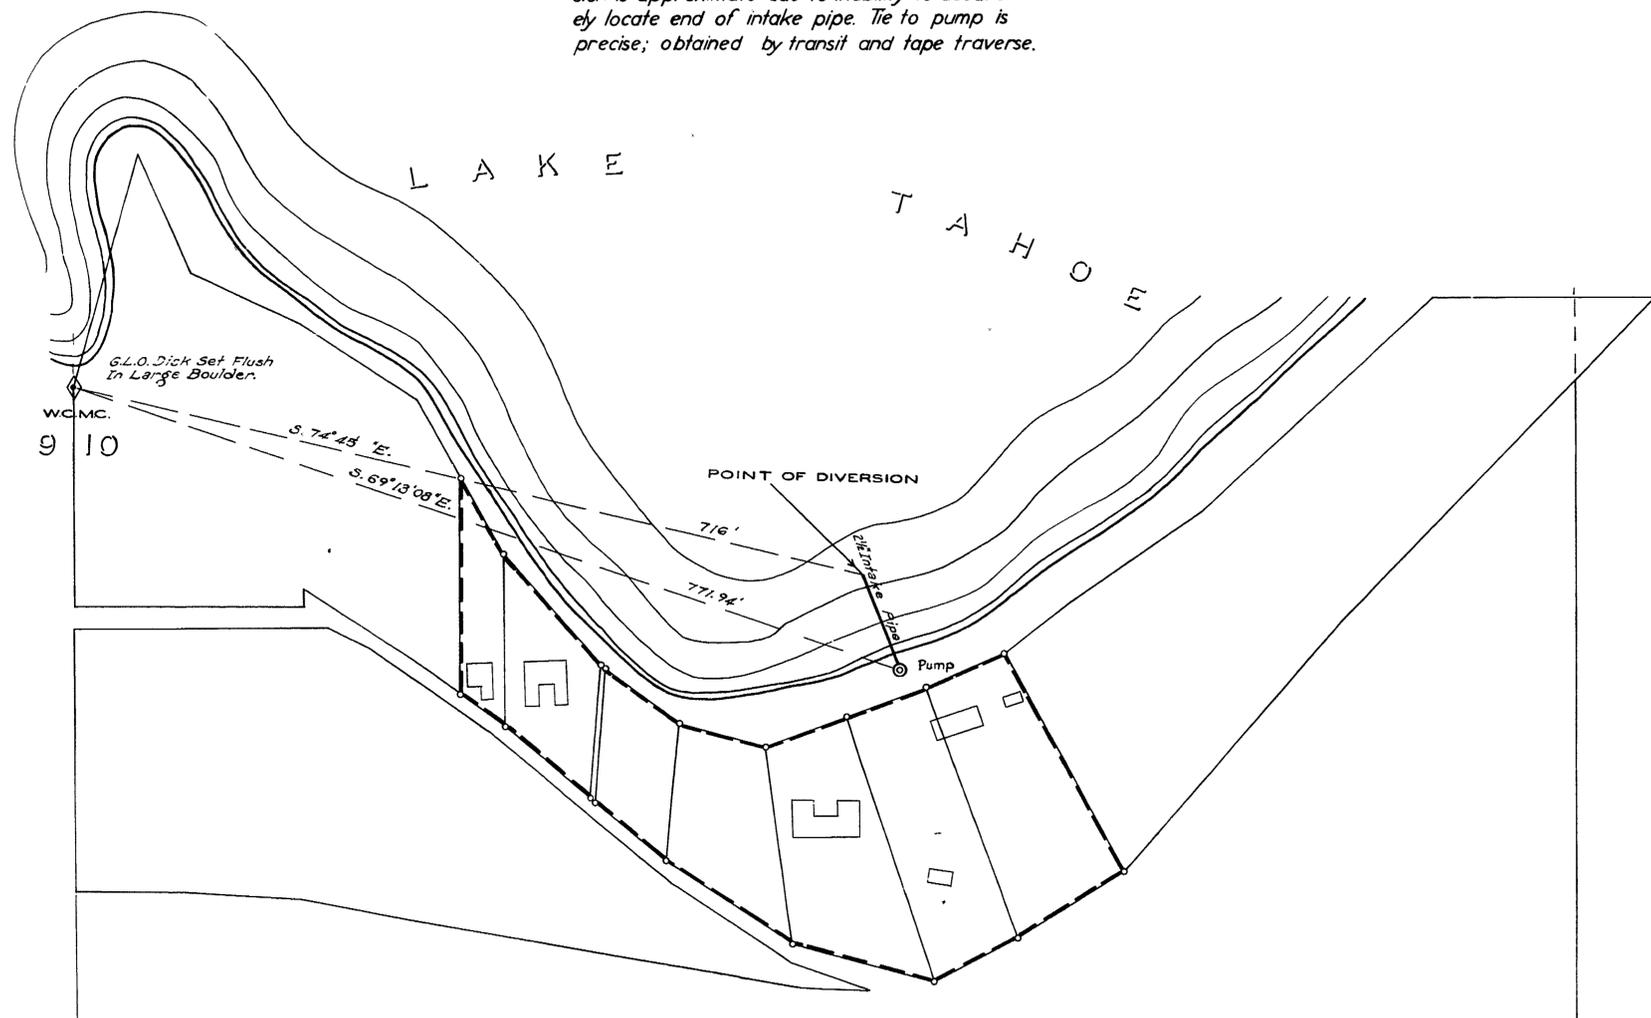

LOT 3,
 SECTION 10 T. 13 N. R. 18 E.


STATE OF NEVADA,
 County of Washoe ss.

I, Robert F. Guinn, being first duly sworn, depose and say that this map, consisting of 1 sheet, has been correctly drawn to the designated scale from field notes of a survey made under my supervision and direction between the 15th day of June, and the 15th day of July, 1947; that it truly and correctly represents the location and extent of the works used to divert water from Lake Tahoe, in Douglas County, by Peter B. Cook Jr. for domestic purposes under application No. 11907. That the point ~~(or proposed point)~~ of diversion, the location, size and grades of the diverting channel, location and description of all measuring devices, the location and extent of lands owned or controlled by the applicant upon which water applied for under application No. 11907 is used ~~(or to be used)~~, together with the area and kind of culture in each 40-acre subdivision, and the location and names of all other works or streams which are crossed by or connected with said works are fully and correctly designated thereon.

Robert F. Guinn
 State Water Right Surveyor

Subscribed and sworn to before me this 17th day of October, 1947.

[Signature]
 Notary Public in and for Washoe County, Nevada.

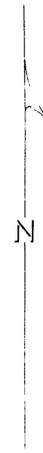

0 _____ 528 FEET
 SCALE 1"=80'

3287 issued 10/27/43 for 0.000 c.f.s.

FILED
 October 20, 1947
 STATE ENGINEER'S OFFICE

MAP
 TO ACCOMPANY APPLICATION NO.
 11907
 TO APPROPRIATE WATER FROM
 LAKE TAHOE
 FOR DOMESTIC PURPOSES BY
 PETER B. COOK JR.
 AND PROOF OF BENEFICIAL USE

11907