


STATE OF NEVADA)
) SS.
 COUNTY OF CLARK)

I, DAVID F. CAUSEY, REGISTERED PROFESSIONAL ENGINEER AND LAND SURVEYOR, NEVADA CERTIFICATE NO. 1811, AND STATE WATER RIGHT SURVEYOR, NEVADA CERTIFICATE NO. 494, AS AGENT FOR CAUSEY ENGINEERING SERVICE BEING FIRST DULY SWORN, DEPOSE AND SAY THAT THIS MAP CONSISTING OF ONE SHEET HAS BEEN CORRECTLY DRAWN TO THE DESIGNATED SCALE FROM FIELD NOTES OF A SURVEY MADE BY ME, OR UNDER MY SUPERVISION AND DIRECTION, BETWEEN THE 10 DAY OF ~~December~~, 1980 AND THE 6 DAY OF ~~JANUARY~~, 1981; THAT IT TRULY AND CORRECTLY REPRESENTS THE PROPOSED LOCATION AND EXTENT OF THE WORKS USED TO DIVERT WATER FROM UNDERGROUND IN WHITE PINE COUNTY, BY LEANN M. STEIN

AND DOMESTIC PURPOSES; THAT THE PROPOSED POINT OF DIVERSION, THE APPROXIMATE LOCATION AND SITE OF THE DIVERTING CHANNEL, ALL RESERVOIRS OR BASINS, THE LOCATION AND NAMES OF ALL OTHER WORKS WHICH WILL CROSS OR CONNECT WITH THE PROPOSED WORKS, AND THE BOUNDARY OF ALL LANDS, SHOWING BY FORTY-ACRE SUBDIVISIONS THE AREAS PROPOSED TO BE SERVED, ARE FULLY AND CORRECTLY DESIGNATED THEREON.

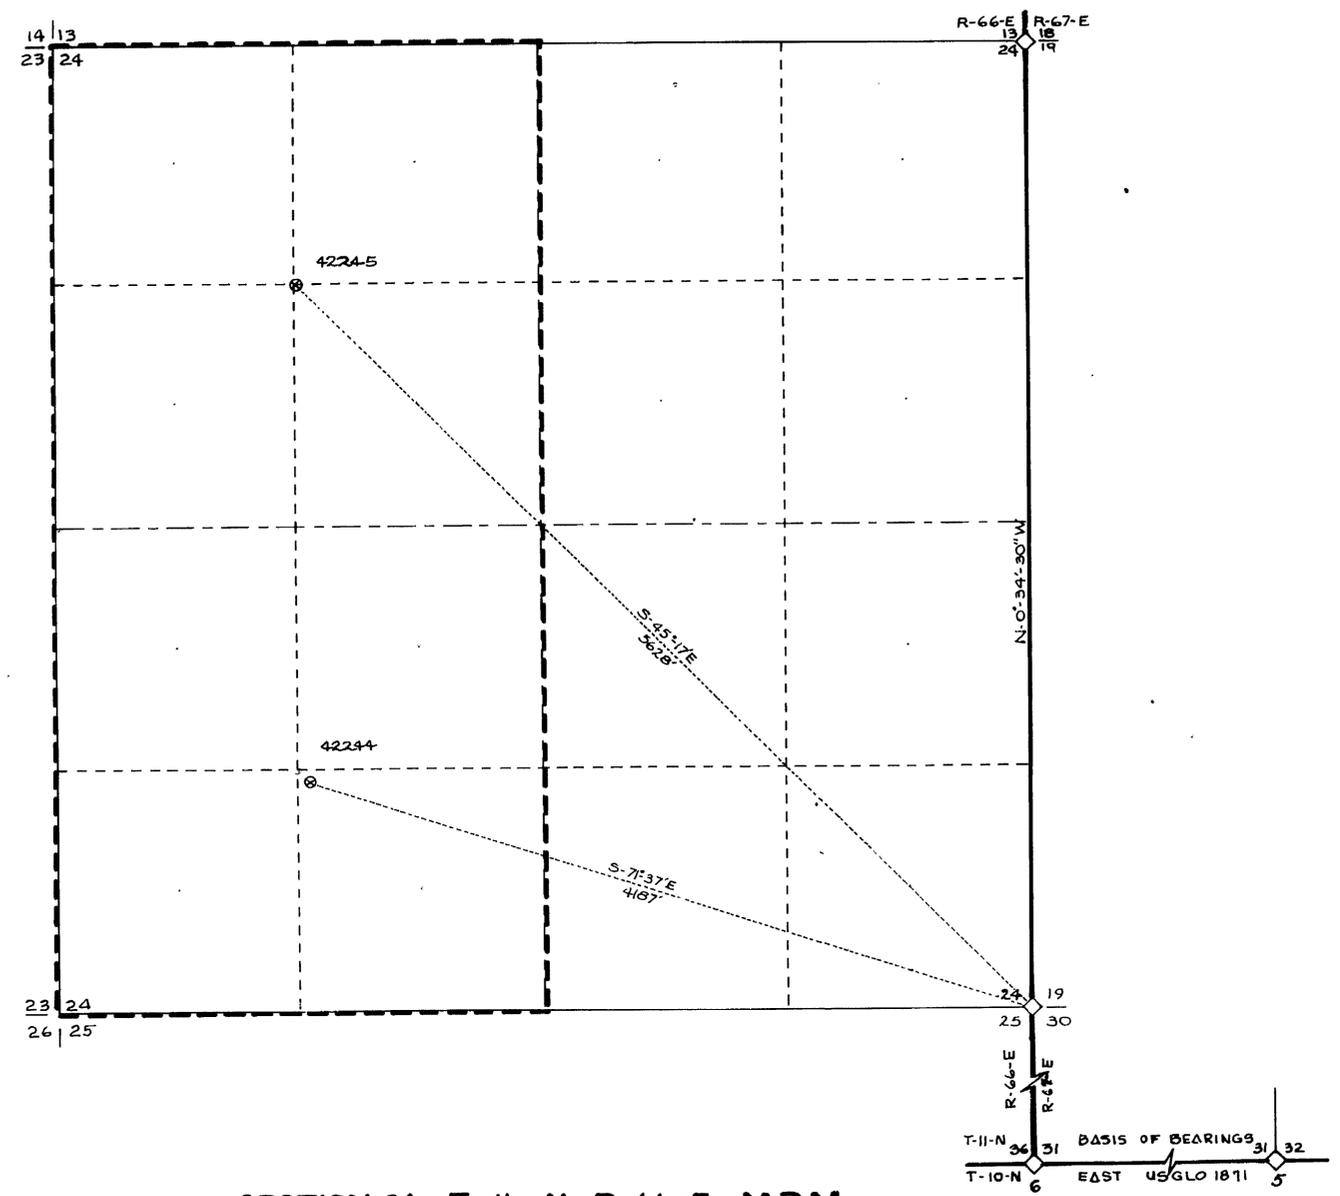

SECTION 24 T-11 -N R-66-E M.D.M.

David F. Causey
 DAVID F. CAUSEY
 STATE WATER-RIGHT SURVEYOR, NO. 494


SUBSCRIBED AND SWORN TO BEFORE ME THIS 7 DAY OF ~~January~~, 1981.

Linda Sue Frank
 LINDA SUE FRANK
 NOTARY PUBLIC IN AND FOR SAID COUNTY AND STATE



LEGEND

- TOWNSHIP LINE
- SECTION LINE
- - - QUARTER-SECTION LINE
- - - SIXTEENTH-SECTION LINE
- - - PLACE OF USE
- ◇ SECTION CORNER FOUND
- ◆ QUARTER CORNER FOUND
- MONUMENT FOUND
- MONUMENT SET R.L.S. 1811
- ~ RIVERS OR PERPETUAL STREAMS
- MAIN SUPPLY DITCHES OR CANALS
- - - SECONDARY OR LATERAL DITCHES
- DAMS, BRIDGES
- - - INTERSECTING DITCHES OR CANALS
- TRAVERSE LINES
- TIE LINES
- ROADS
- FENCES
- RAILROADS
- BUILDINGS
- ⊗ WELL SITE

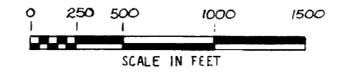

SCALE 1" = 500'	DATE
DES.	
DR.	

REVISIONS	BY	DATE
COR. & BEARINGS REF.	JDH	3-6-81

331 JAN 28 AM 8 45

RECEIVED
 JAN 19 1981
 Div. of Water Resources
 Nevada Office - Las Vegas, Nev.

FILED
 MAR 9 7 1981
 STATE ENGINEER'S OFFICE

MAP TO ACCOMPANY APPLICATION TO APPROPRIATE WATER FOR IRRIGATION AND DOMESTIC USE

IN W 1/2 SECTION 24 TOWNSHIP 11 NORTH, RANGE 66 EAST MOUNT DIABLO MERIDIAN WHITE PINE COUNTY, NEVADA

BY LEANN M. STEIN

CAUSEY ENGINEERING SERVICE

42244	42245	JOB NO. 7831-1-8	SHEET 1 OF 1
42245		12244	