

PLACE OF USE BEFORE TRANSFER

PLACE OF USE AFTER TRANSFER

THE CERTIFIED WATER SERVICE AREA OF SIERRA PACIFIC POWER COMPANY AS SHOWN ON LEGAL DESCRIPTION AND SUPPORTED WITH A MAP OF THE CERTIFIED WATER SERVICE AREA ON FILE WITH THE STATE ENGINEER'S OFFICE.


STATE OF NEVADA  
COUNTY OF WASHOE S.S.

I, RICHARD D. MOSER, BEING DULY SWORN DEPOSE AND SAY THAT THIS MAP, CONSISTING OF ONE SHEET HAS BEEN CORRECTLY DRAWN TO THE DESIGNATED SCALE, FROM DATA AVAILABLE IN THE OFFICE OF SIERRA PACIFIC POWER CO. AT RENO, NEVADA, THAT IT TRULY REPRESENTS THE PROPOSED CHANGES IN THE POINT OF DIVERSION, PLACE AND MANNER OF USE, OF THE WATERS FROM THE TRUCKEE RIVER IN WASHOE COUNTY, NEVADA, BY SIERRA PACIFIC POWER CO.


*Richard D Moser*  
STATE WATER RIGHT SURVEYOR NO. 453

ON August 23, 1989 PERSONALLY APPEARED BEFORE ME A NOTARY PUBLIC, RICHARD D. MOSER WHO ACKNOWLEDGED THAT HE EXECUTED THE WITHIN INSTRUMENT.

*Gregory C. Neuweiler*

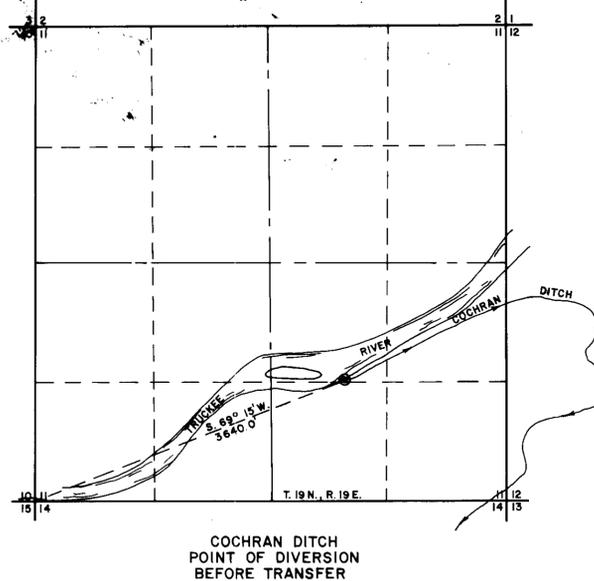


COCHRAN DITCH  
POINT OF DIVERSION  
BEFORE TRANSFER

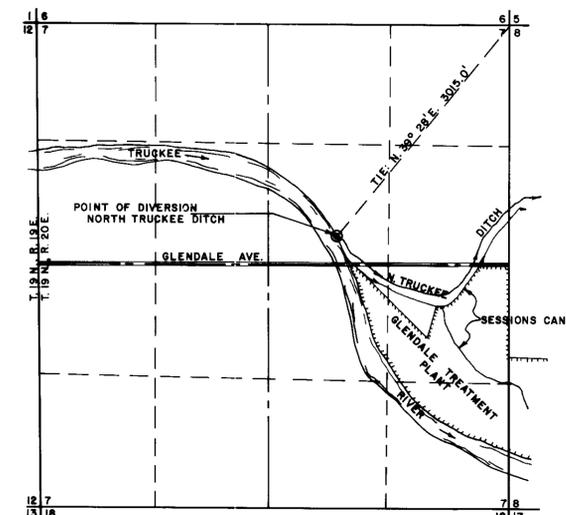

NORTH TRUCKEE DITCH  
POINT OF DIVERSION  
AFTER TRANSFER

NORTH  
M.D.B. & M.  
BASIS OF BEARING: TIES TO P.O.D. AS INDICATED WITHIN THE ORR DITCH DECREE

- 48395 CERTIFICATE No. 12620 ISSUED 1-22-91
- 48396 CERTIFICATE No. 12629 ISSUED 1-22-91
- 48397 CERTIFICATE No. 12672 ISSUED 3-14-91
- 48398 CERTIFICATE No. 12631 ISSUED 1-16-91
- 48399 CERTIFICATE No. 12632 ISSUED 1-22-91
- 48400 CERTIFICATE No. 12633 ISSUED 1-22-91
- 48401 CERTIFICATE No. 12634 ISSUED 1-22-91

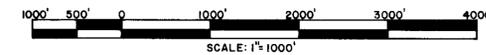

'84 SEP 13 PA:32  
STATE ENGINEER'S OFFICE

48395-401  
MAP  
TO ACCOMPANY APPLICATION TO CHANGE THE POINT OF DIVERSION, PLACE OF USE AND MANNER OF USE FROM IRRIGATION TO MUNICIPAL & DOMESTIC BY SIERRA PACIFIC POWER CO. FOR WATERS OF THE TRUCKEE RIVER