


THE NW 1/4 of the NW 1/4 of
SECTION 17, TOWNSHIP 26 SOUTH, RANGE 61 EAST, M.D.M.

FND STONE MONUMENT
W/6 NOTCHES ON E. SIDE
and 6 NOTCHES ON S. SIDE

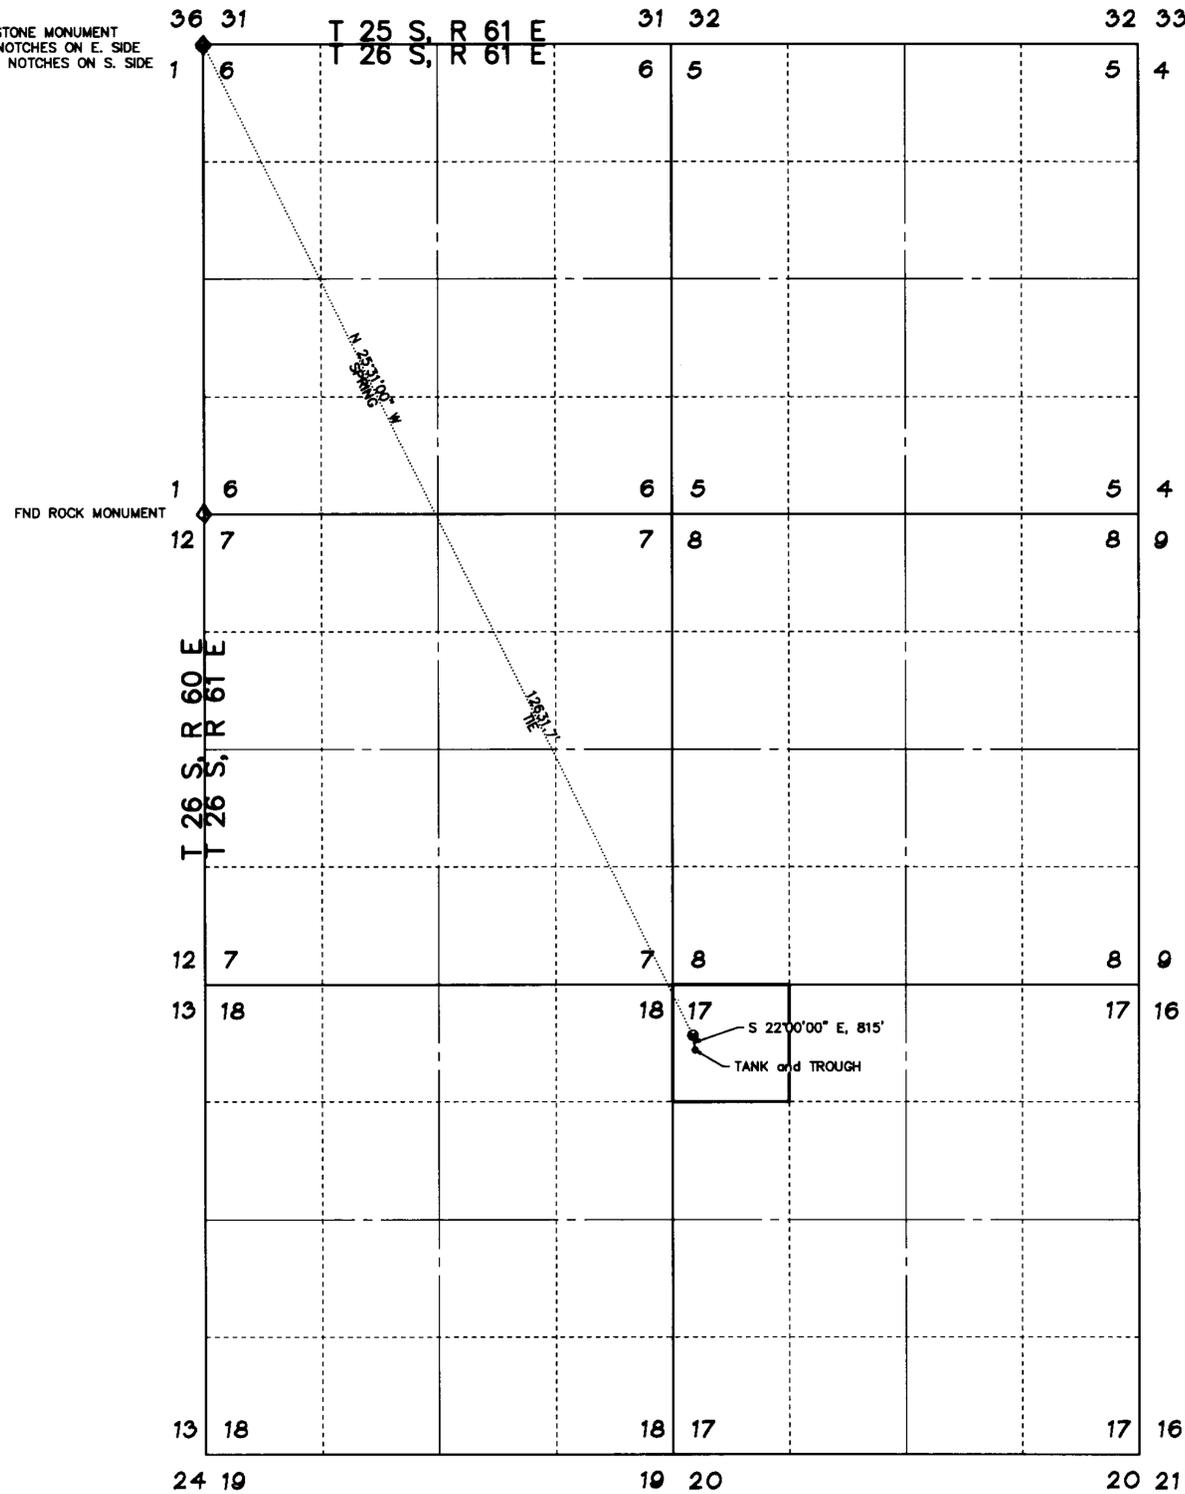

SURVEY SHOWING: SECTIONS 5, 6, 7, 8, 17, and 18, TOWNSHIP 26 SOUTH, RANGE 61 EAST, M.D.M.

SURVEYOR'S CERTIFICATE

I, GERALD L. WIRTHLIN, BEING FIRST DULY SWORN, DEPOSE AND SAY THAT THIS MAP, CONSISTING OF ONE SHEET, HAS BEEN CORRECTLY DRAWN TO THE DESIGNATED SCALE FROM RECORD DRAWINGS OF A SURVEY MADE BY LEO A. SNOW, ON THE DATE OF OCTOBER 20, 1946, THAT IT HAS BEEN FIELD VERIFIED AND CORRECTLY REPRESENTS THE PROPOSED LOCATION AND EXTENT OF THE WORKS USED TO DIVERT WATER FROM AN UNDERGROUND SOURCE IN CLARK COUNTY, STATE OF NEVADA BY CAL BAIRD FOR STOCKWATERING PURPOSES, THAT THE PROPOSED POINT OF DIVERSION, THE APPROXIMATE LOCATION AND SIZE OF THE DIVERTING CHANNEL OR OTHER CONDUIT, THE PLACE AND MANNER OF USE AND THE LOCATION AND USE OF ALL OTHER STREAMS, WHICH ARE CROSSED BY, OR CONNECTED WITH THE SAID WORKS ARE FULLY AND CORRECTLY DESIGNATED THEREON.

GERALD L. WIRTHLIN
PROFESSIONAL LAND SURVEYOR
NEVADA CERTIFICATE No. 7008
NEVADA WATER RIGHTS SURVEYOR No. 887



SUBSCRIBED AND SWORN TO ME THIS 21 of August, 1995

Mildred E. Woods


NOTARY PUBLIC IN AND FOR
SAID COUNTY AND STATE



MY COMMISSION EXPIRES: 4/8/96

BASIS OF BEARINGS

THE BASIS OF BEARINGS FOR THIS MAP IS THE WEST LINE OF SECTION 6, TOWNSHIP 26 SOUTH, RANGE 61 EAST, M.D.M. SAID LINE BEARS S 0°00'00" E, AS SHOWN ON BLM PLAT DATED JUNE 21 st, 1882

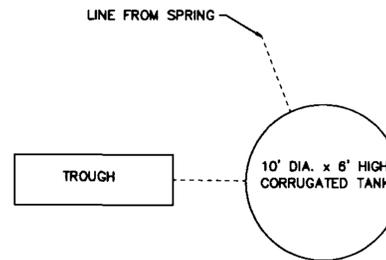

FILED
AUG 21 1995
STATE ENGINEER'S OFFICE
Bldg. 1000
200 N. MAIN ST.
RENO, NEVADA 89501

STATE ENGINEERS USE

FILED
AUG 21 1995
STATE ENGINEER'S OFFICE

MAP TO ACCOMPANY AN
APPLICATION TO APPROPRIATE
WATER

BY: CAL BAIRD
FOR: STOCKWATERING PURPOSES
FROM: MCCLANAHAN SPRING

20110 CROCKETT WIRTHLIN
20-8 NW 1/4-8-00

SOUTHWEST SURVEYING, INC.
GERALD "CROCKETT" WIRTHLIN
PLS #7008

61016

61016