

**SURVEYOR'S CERTIFICATE**

I, GERALD L. WIRTHLIN, BEING FIRST DULY SWORN, DEPOSE AND SAY THAT THIS MAP, CONSISTING OF ONE SHEET, HAS BEEN CORRECTLY DRAWN TO THE DESIGNATED SCALE FROM RECORD DRAWINGS OF A SURVEY MADE BY LEO A. SNOW, ON THE DATE OF OCTOBER 19, 1946, THAT IT HAS BEEN FIELD VERIFIED AND CORRECTLY REPRESENTS THE PROPOSED LOCATION AND EXTENT OF THE WORKS USED TO DIVERT WATER FROM AN UNDERGROUND SOURCE IN CLARK COUNTY, STATE OF NEVADA BY CAL BAIRD FOR STOCKWATERING PURPOSES, THAT THE PROPOSED POINT OF DIVERSION, THE APPROXIMATE LOCATION AND SIZE OF THE DIVERTING CHANNEL OR OTHER CONDUIT, THE PLACE AND MANNER OF USE AND THE LOCATION AND USE OF ALL OTHER STREAMS, WHICH ARE CROSSED BY, OR CONNECTED WITH THE SAID WORKS ARE FULLY AND CORRECTLY DESIGNATED THEREON.



GERALD L. WIRTHLIN  
PROFESSIONAL LAND SURVEYOR  
NEVADA CERTIFICATE No. 7008  
NEVADA WATER RIGHTS SURVEYOR No. 887

SUBSCRIBED AND SWORN TO ME THIS 21 of August, 1995

*Mildred E. Woods*

NOTARY PUBLIC IN AND FOR SAID COUNTY AND STATE




MY COMMISSION EXPIRES: 4/8/96

THE NW 1/4 of the SW 1/4 of SECTION 21, TOWNSHIP 28 SOUTH, RANGE 61 EAST, M.D.M.

**BASIS OF BEARINGS**

THE BASIS OF BEARINGS FOR THIS MAP IS THE SOUTH LINE OF THE SOUTHWEST 1/4, OF SECTION 20, T. 28 S., R. 61 E., M.D.M., AS SHOWN IN BLM PLAT DATED 7/22/1982. SAID LINE BEARS N 89°53'00" W.

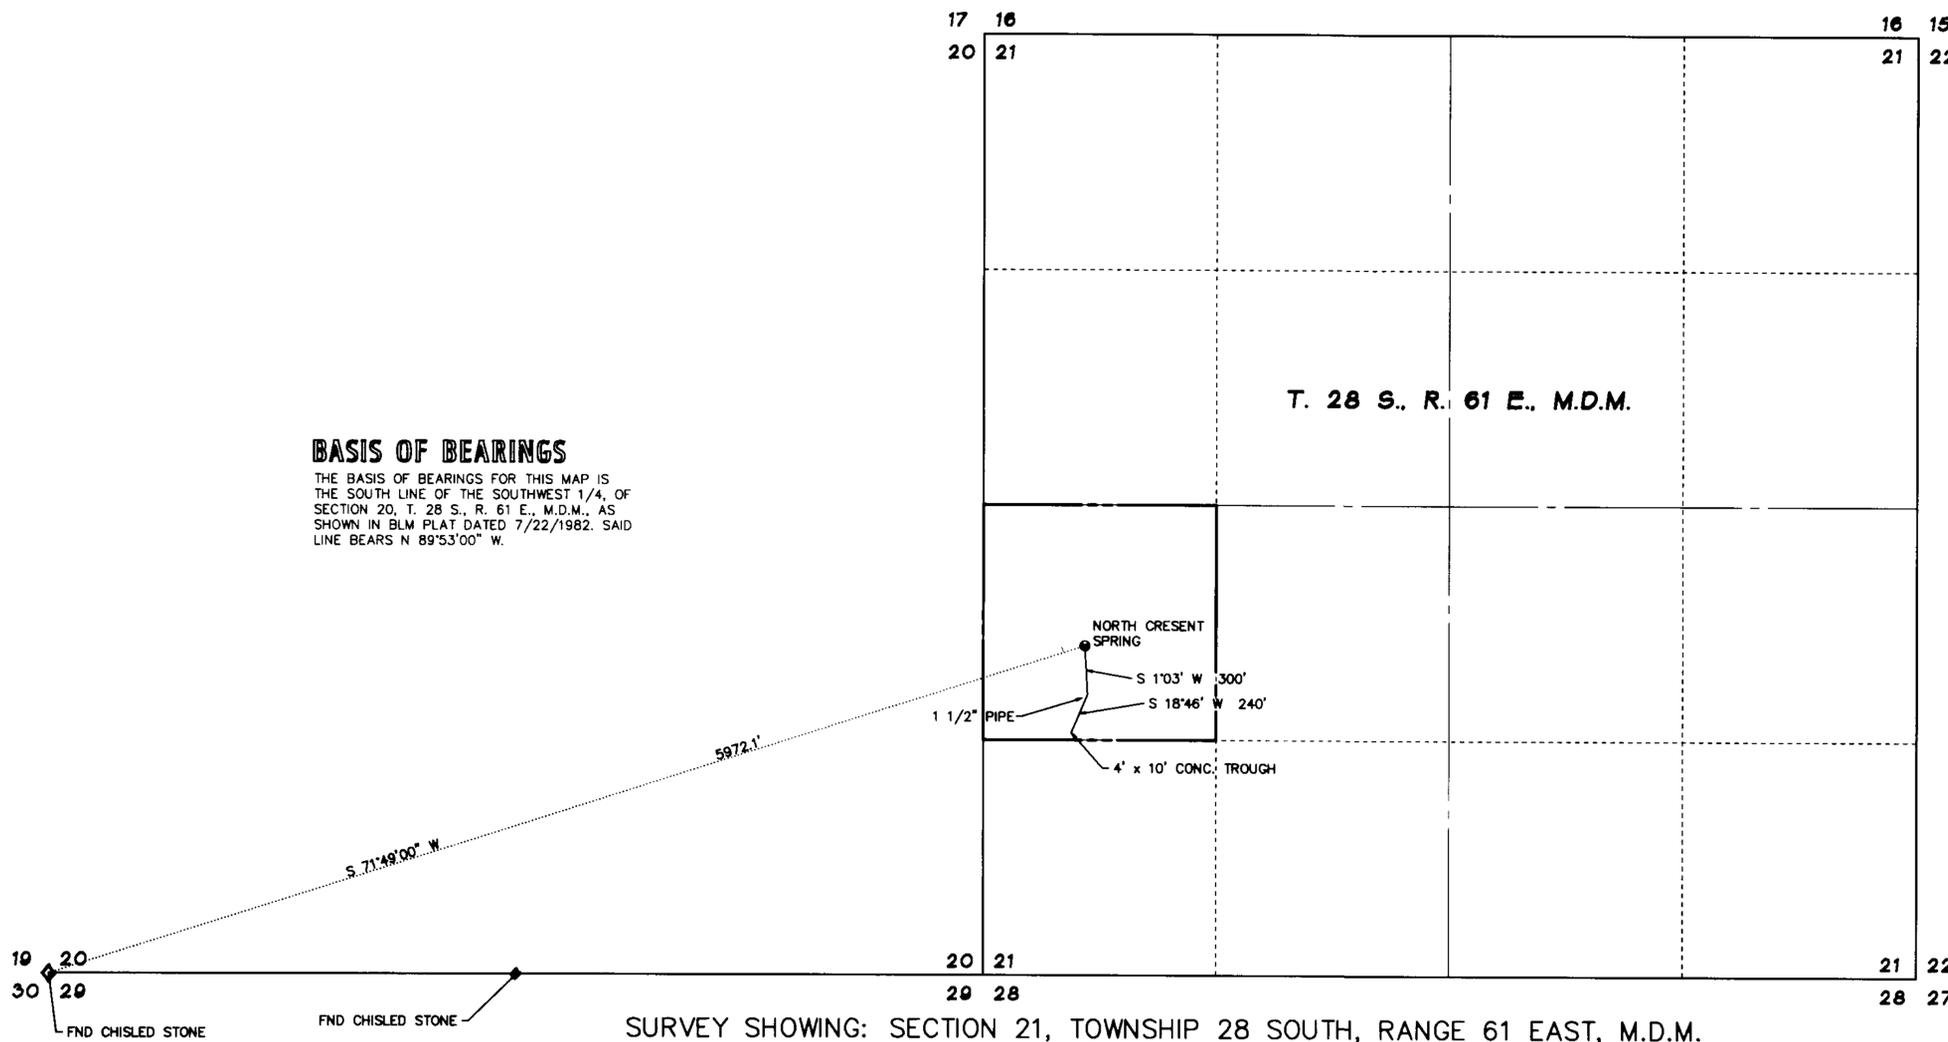

STATE ENGINEERS USE

FILED  
AUG 21 1995  
STATE ENGINEER'S OFFICE

MAP TO ACCOMPANY AN APPLICATION TO APPROPRIATE WATER

BY: CAL BAIRD  
FOR: STOCKWATERING PURPOSES  
FROM: NORTH CRESENT SPRING

SOUTHWEST SURVEYING, INC.  
GERALD "CROCKETT" WIRTHLIN  
PLS #7008

600-3204 OFFICE  
375-2062 MOBILE

61019

61019