


THE SE 1/4 of the NE 1/4 of  
SECTION 31, TOWNSHIP 26 SOUTH, RANGE 61 EAST, M.D.M.

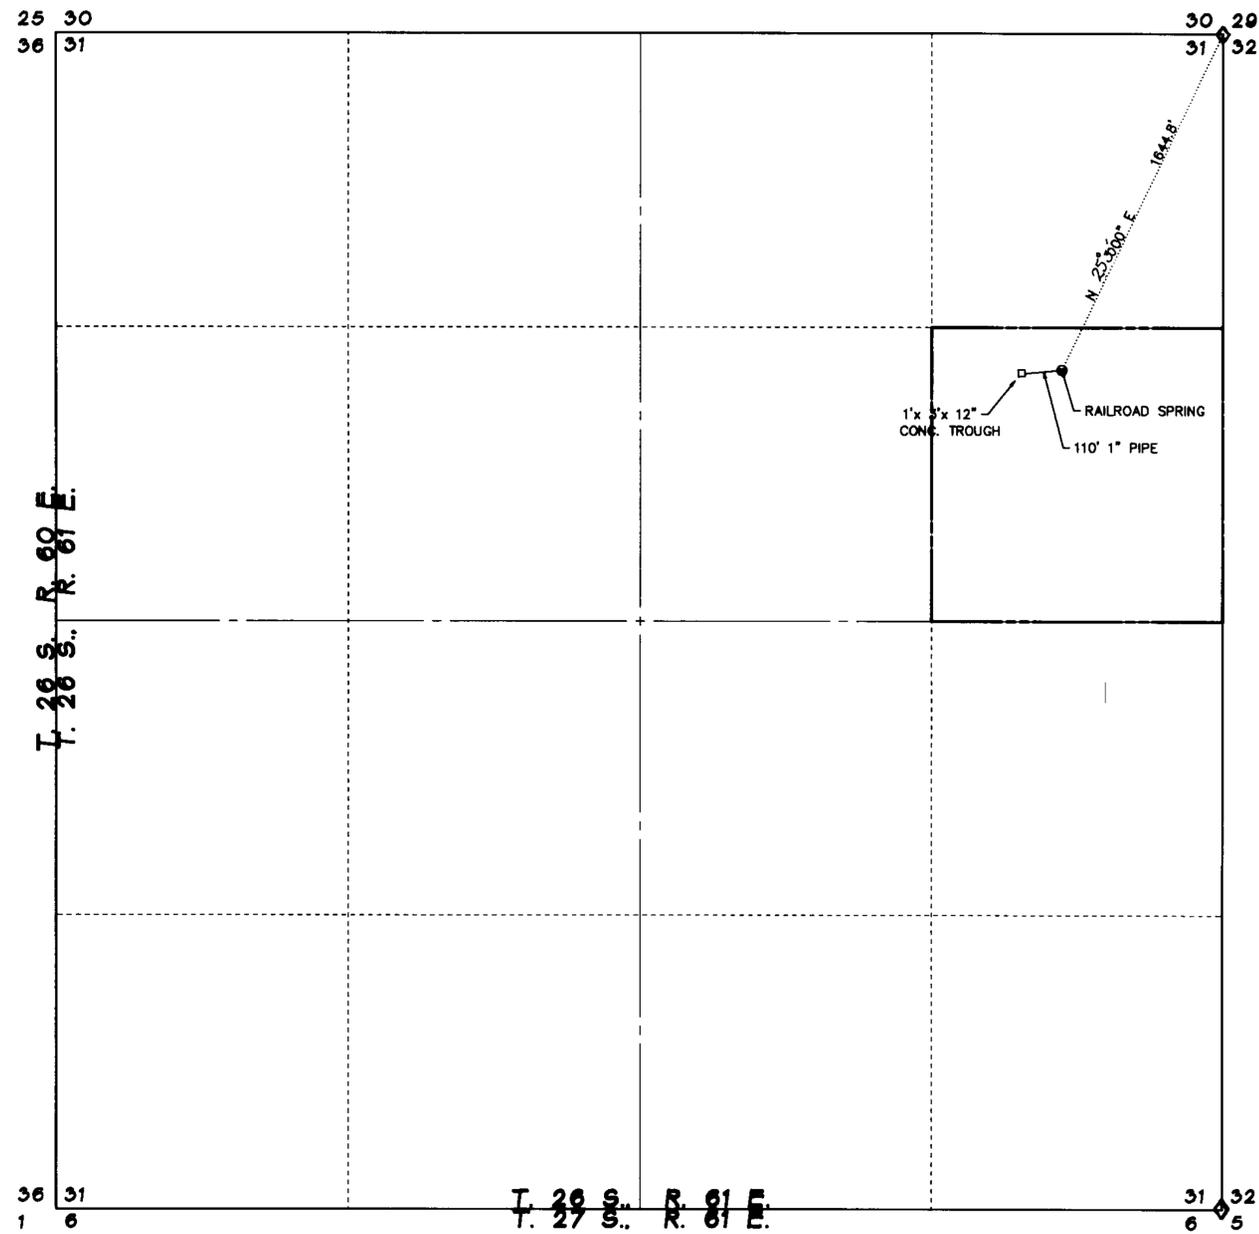

FND 4" x 4" POST  
IN ROCK PILE

FND 4" x 4" POST  
IN ROCK PILE

**SURVEYOR'S CERTIFICATE**

I, GERALD L. WIRTHLIN, BEING FIRST DULY SWORN, DEPOSE AND SAY THAT THIS MAP, CONSISTING OF ONE SHEET, HAS BEEN CORRECTLY DRAWN TO THE DESIGNATED SCALE FROM RECORD DRAWINGS OF A SURVEY MADE BY JAY M. RASSLER, ON THE DATE OF JUNE 3, 1971, THAT IT HAS BEEN FIELD VERIFIED AND CORRECTLY REPRESENTS THE PROPOSED LOCATION AND EXTENT OF THE WORKS USED TO DIVERT WATER FROM AN UNDERGROUND SOURCE IN CLARK COUNTY, STATE OF NEVADA BY CAL BAIRD FOR STOCKWATERING PURPOSES, THAT THE PROPOSED POINT OF DIVERSION, THE APPROXIMATE LOCATION AND SIZE OF THE DIVERTING CHANNEL OR OTHER CONDUIT, THE PLACE AND MANNER OF USE AND THE LOCATION AND USE OF ALL OTHER STREAMS, WHICH ARE CROSSED BY, OR CONNECTED WITH THE SAID WORKS ARE FULLY AND CORRECTLY DESIGNATED THEREON.



GERALD L. WIRTHLIN  
PROFESSIONAL LAND SURVEYOR  
NEVADA CERTIFICATE No. 7008  
NEVADA WATER RIGHTS SURVEYOR No. 887

SUBSCRIBED AND SWORN TO ME THIS 21 OF August 1995

*Mildred E. Woods*


NOTARY PUBLIC IN AND FOR  
SAID COUNTY AND STATE



MY COMMISSION EXPIRES: 4/6/96

**BASIS OF BEARINGS**

THE BASIS OF BEARINGS FOR THIS MAP IS  
THE EAST LINE OF SECTION 31, AS SHOWN  
IN BLM PLAT DATED JUNE 21, 1882.  
SAID LINE BEARS S 0°00'00" E

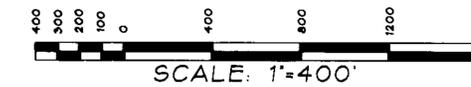

SURVEY SHOWING: SECTION 31, TOWNSHIP 26 SOUTH, RANGE 61 EAST, M.D.M.

STATE ENGINEERS USE

FILED  
AUG 21 1995  
STATE ENGINEER'S OFFICE

MAP TO ACCOMPANY AN  
APPLICATION TO APPROPRIATE  
WATER

BY: CAL BAIRD  
FOR: STOCKWATERING PURPOSES  
FROM: RAILROAD SPRING

SOUTHWEST SURVEYING, INC.  
GERALD 'CROCKETT' WIRTHLIN  
PLS #7008

856-2004  
OFFICE  
379-2002  
MOBILE