


THE NE 1/4 of the NE 1/4 of  
SECTION 21, TOWNSHIP 27 SOUTH, RANGE 60 EAST, M.D.M.

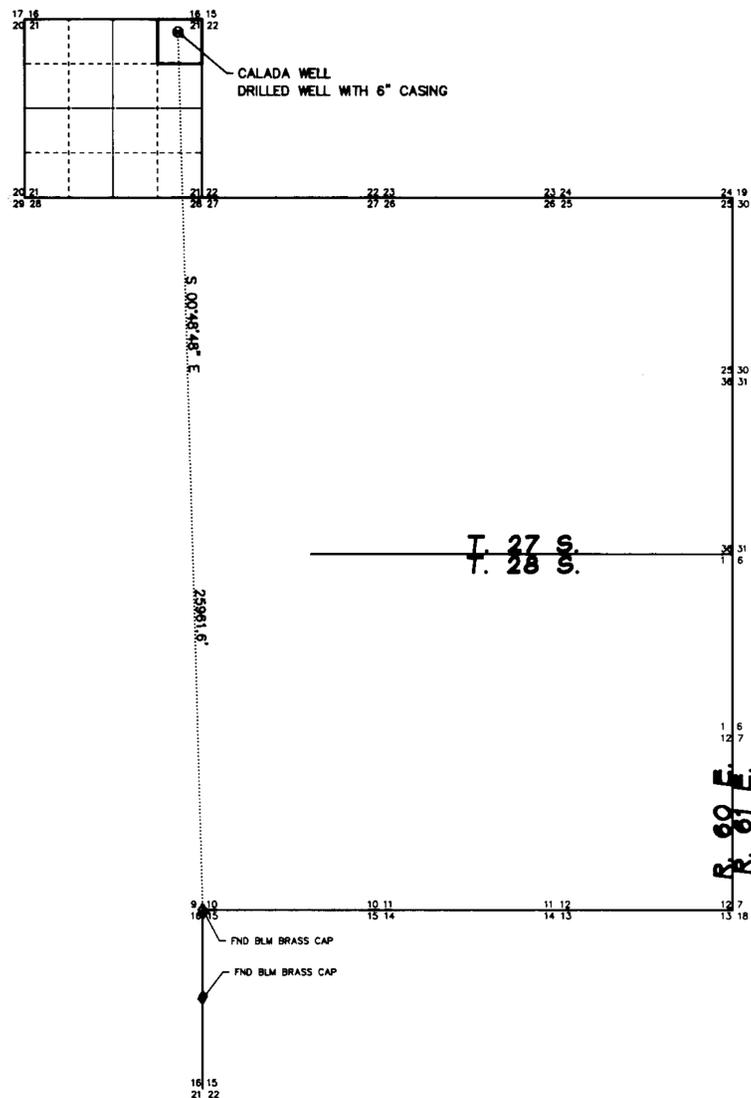

SURVEY SHOWING: SECTION 21, TOWNSHIP 27 SOUTH, RANGE 60 EAST, M.D.M.

**SURVEYOR'S CERTIFICATE**

I, GERALD L. WIRTHLIN, BEING FIRST DULY SWORN, DEPOSE AND SAY THAT THIS MAP, CONSISTING OF ONE SHEET, HAS BEEN CORRECTLY DRAWN TO THE DESIGNATED SCALE FROM RECORD DRAWINGS OF A SURVEY MADE BY RICHARD HAFEN, ON THE DATE OF APRIL 19, 1979. THAT IT HAS BEEN FIELD VERIFIED AND CORRECTLY REPRESENTS THE PROPOSED LOCATION AND EXTENT OF THE WORKS USED TO DIVERT WATER FROM AN UNDERGROUND SOURCE IN CLARK COUNTY, STATE OF NEVADA BY CAL BAIRD FOR STOCKWATERING PURPOSES, THAT THE PROPOSED POINT OF DIVERSION, THE APPROXIMATE LOCATION AND SIZE OF THE DIVERTING CHANNEL OR OTHER CONDUIT, THE PLACE AND MANNER OF USE AND THE LOCATION AND USE OF ALL OTHER STREAMS, WHICH ARE CROSSED BY, OR CONNECTED WITH THE SAID WORKS ARE FULLY AND CORRECTLY DESIGNATED THEREON.

GERALD L. WIRTHLIN  
PROFESSIONAL LAND SURVEYOR  
NEVADA CERTIFICATE No. 7008  
NEVADA WATER RIGHTS SURVEYOR No. 887



SUBSCRIBED AND SWORN TO ME THIS 21 of August, 1995

*Mildred E. Woods*

NOTARY PUBLIC IN AND FOR  
SAID COUNTY AND STATE



MY COMMISSION EXPIRES: 4/8/96

**BASIS OF BEARINGS**

THE BASIS OF BEARINGS FOR THIS MAP IS THE WEST LINE OF THE NORTHWEST 1/4 OF SECTION 15, TOWNSHIP 28 SOUTH, RANGE 60 EAST, M.D.M., AS SHOWN ON 1933 BLM FRACTIONAL RESURVEY, SIAD LINE BEARS N 00°16'00" W



61022

STATE ENGINEERS USE

**FILED**  
AUG 21 1995  
STATE ENGINEER'S OFFICE

**MAP TO ACCOMPANY AN APPLICATION TO APPROPRIATE WATER**

BY: CAL BAIRD  
FOR: STOCKWATERING PURPOSES  
FROM: CALADA WELL

AUG 21 1995  
STATE ENGINEER'S OFFICE

601022  
60-8 HW 42 SW 66

**SOUTHWEST SURVEYING, INC.**  
GERALD 'CROCKETT' WIRTHLIN  
PLS #7008

61022