

WATER TO BE TRANSFERRED UNDER THE ORR DITCH DECREE

STATE OF NEVADA }
COUNTY OF WASHOE }

I, Harlan K. King, being first duly sworn, depose and say that site inspections have been made by me, or under my supervision and direction, that this map, consisting of one sheet, has been correctly drawn to the designated scale from surveying calculation notes prepared by me, or under my supervision and direction, relying upon analysis of recorded survey maps and other recorded surveying documents in the office of the Washoe County Recorder, that this map truly and correctly represents the proposed location and extent of the works used to divert water from the Truckee River, in Washoe County, Nevada, by C.B. Maddox.

Harlan K. King


Harlan K. King,
State Water Rights Surveyor No. 615

On January 24, 1997 personally appeared before me, a notary public in and for the County of Washoe, State of Nevada, HARLAN K. KING, who acknowledged to me that he executed the foregoing instrument.

Daniel McGill

DANIEL MCGILL
Notary Public - State of Nevada
Appointment Recorded in Washoe County
No. 95-0612-2 - EXPIRES NOV. 1, 1999

Notary Public

PLACE OF USE AFTER TRANSFER

The certified water service area of Sierra Pacific Power Company as designated by the Nevada Public Service Commission and which may be amended from time to time.

POINT OF DIVERSION AFTER TRANSFER

Existing Sierra Pacific Power Company points of diversion as described in application 52882, and shown on the supporting map accompanying said application on file with the State Engineers Office.

EXISTING POINT OF DIVERSION


As Decreed

BASIS OF BEARINGS

Ties to the Points of Diversion are depicted as indicated within the Orr Ditch Decree.



SCALE: 1" = 200'

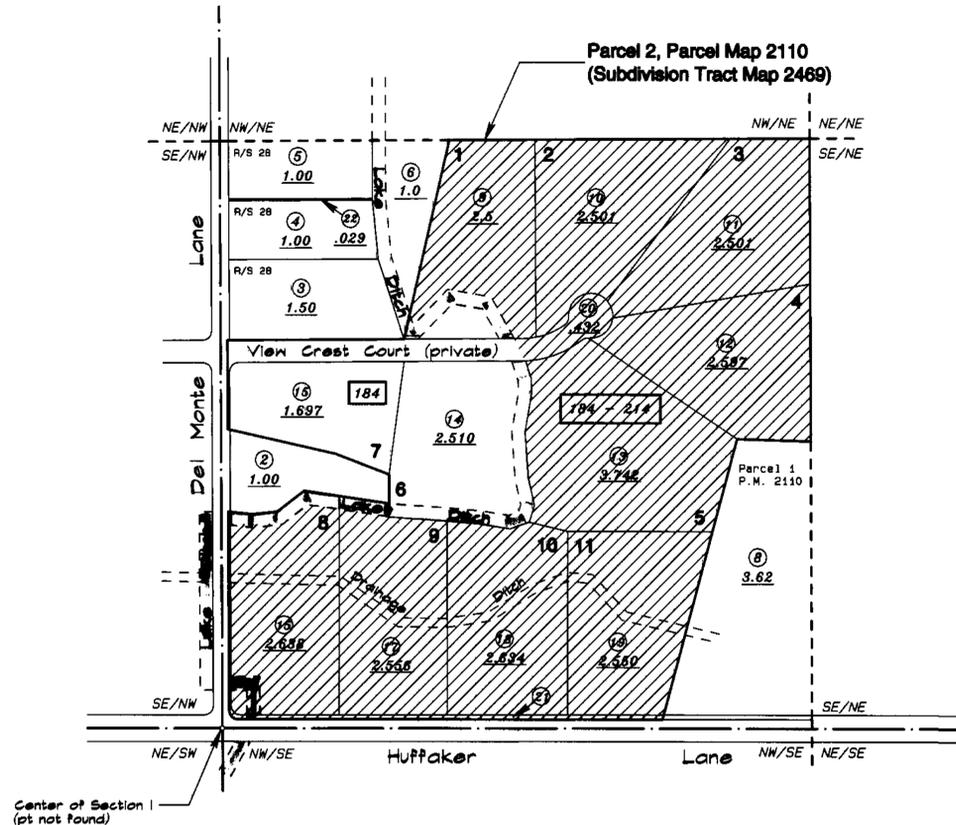

SW 1/4, NE 1/4 of Section 1, T.18 N., R.19 E., M.D.B.& M.

KEY



Existing Place of Use. Portion of an O.D.D. Claim to be transferred under this Application

③

Washoe Co. Assessor's Parcel Number. All Parcels shown hereon are located on Book 40, Block 601. (i.e. APN 040-601-03)

1.50

Parcel area in acres

2

Subdivision Lot No. (Tract Map 2469)

184

Orr Ditch Decree Claim reference



Lake Ditch

35	36	T.19 N.	36	31
2	1	T.18 N.	1	6
		SW 1/4	R.19 E.	R.20 E.
2	1		1	6
11	12		12	7

Section Map

nts

TITLE BLOCK SHOULD READ "PORTION OF CLAIM 184 # 214" STATE ENGINEER'S USE
 EXISTING PLACE OF USE DETAIL SHOULD READ "SW 1/4 NE 1/4" i.e. NO COMMON BOUNDARIES
 SOME PARCELS HAVE RE-PURCHASED ORIGINAL RIGHTS, OR PORTIONS, SO STRIPPING BY ACRES NOT POSSIBLE FOR PUBLICATION. § 2-30-97

FILED
JAN 28 1997
STATE ENGINEER'S OFFICE

MAP TO ACCOMPANY APPLICATION TO CHANGE POINT OF DIVERSION, PLACE AND MANNER OF USE, FROM IRRIGATION TO MUNICIPAL AND DOMESTIC USE BY C. B. MADDOX FOR THE WATERS OF THE TRUCKEE RIVER IN WASHOE COUNTY, NEVADA

 HARLAN KING & ASSOCIATES
 LAND SURVEYING & WATER RIGHTS
 6147 LAKESIDE DR., #104 Reno, NEVADA 89509
 (702) 829-8919 Fax: (702) 828-1877

Date: 01/24/97
 Drawn: DEM
 Checked: HKK