


~~PLACE OF USE~~
~~SE 1/4 SE 1/4~~
~~OF SECTION 12~~

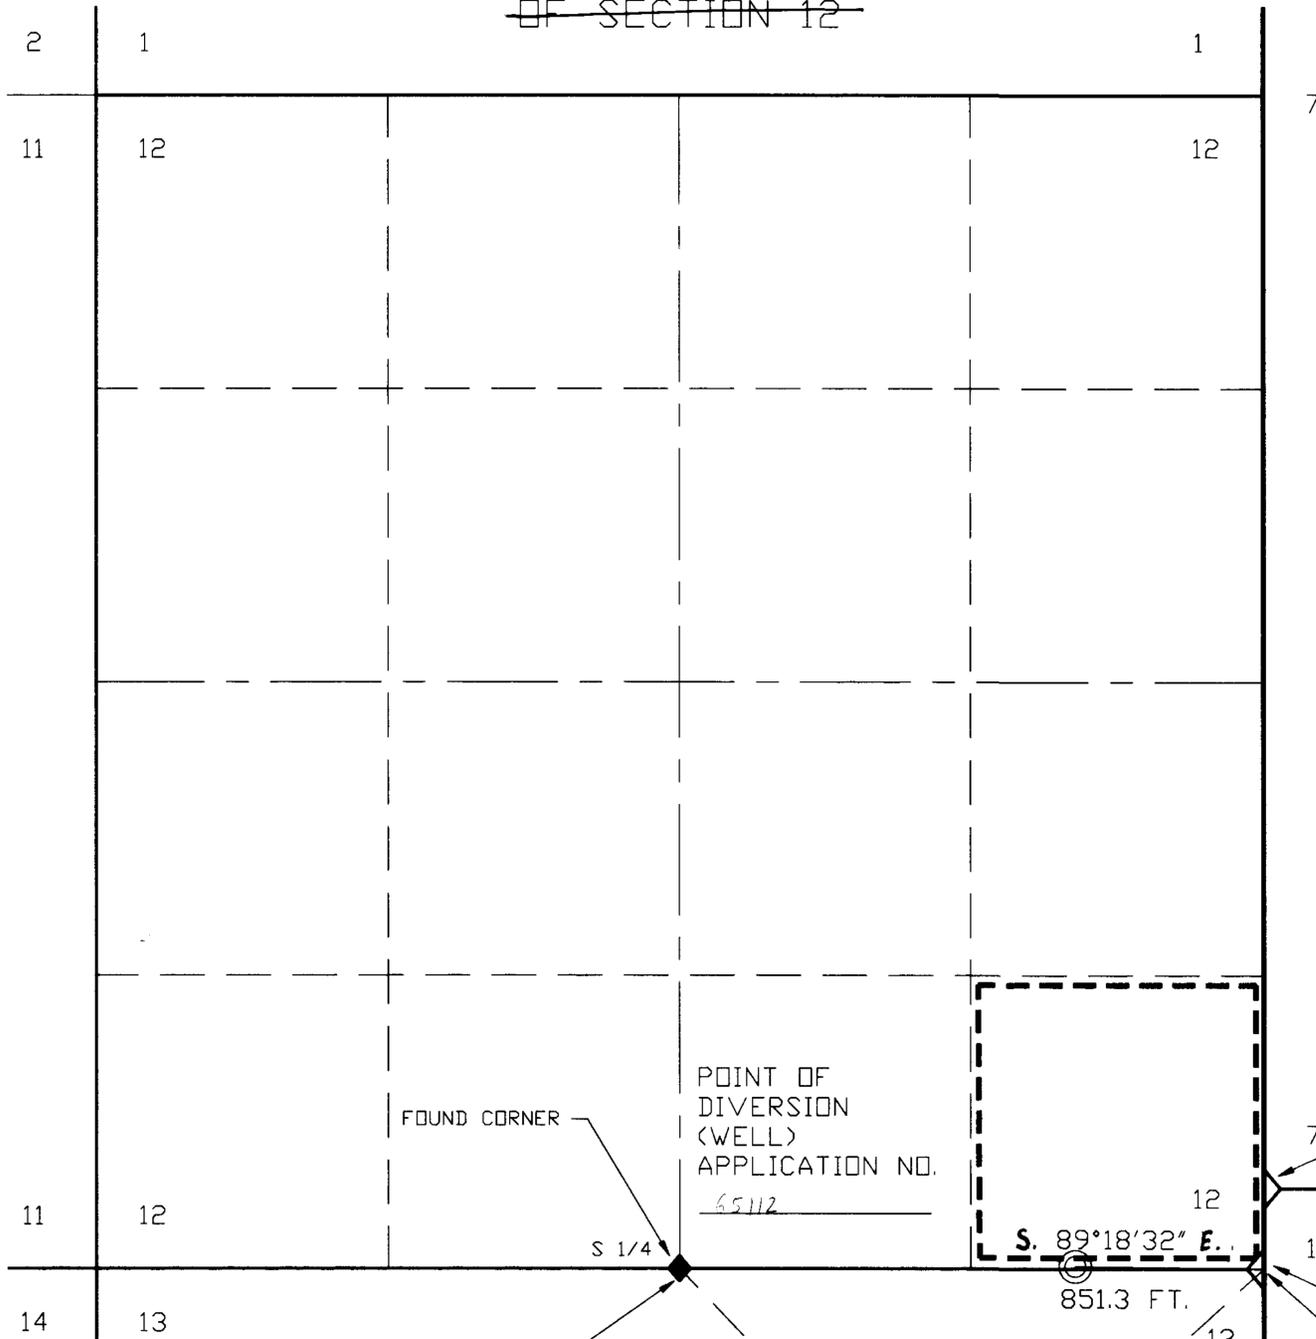

STATE OF NEVADA, } SS.
COUNTY OF CHURCHILL }

I, Stephen G Ward, being first duly sworn, depose and say that this map, consisting of 1 sheet, has been correctly drawn to the designated scale from field notes of a survey made by me, on the 26th day of Oct, 1995, that it truly and correctly represents the proposed location and extent of the works used to divert water from underground sources in Churchill County, by Naval Air Station Fallon, for Quasi-Municipal purposes. That the proposed point of diversion, the approximate location, and the boundary of all lands, showing by 40-acre subdivisions the areas proposed for use, are fully and correctly designated thereon.

Stephen G Ward
(State Water Right Surveyor)



Subscribed and sworn to before me this

26th day of June, 1997.


Joann G. Bradford
Notary Public

Notary Public in and for Churchill,
County, Nevada.
My Commission Expires 3 March, 1999, 3 March 2003

Joann G. Bradford

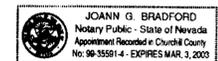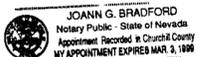

SCALE: 1"=400'

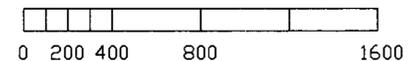


4x4 Post w/ Illegible Scribe
Marks, Exposed 12" Above
Ground.

SECTION 12
T. 24 N., R. 31 E., MDB & M
CHURCHILL COUNTY, NEVADA

65112 CERTIFICATE NO. 16303 ISSUED 03-02-04


STATE ENGINEER'S USE

1) The title block and affidavit should read "quasi-industrial" and not "quasi-municipal"
per letter in file 6-4-97. @
2) See SHEET 2 of 2 FOR PLACE OF USE. @ 6-4-97

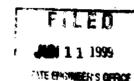

RECEIVED
69 JUN -4- PM 4:07

MAP TO ACCOMPANY APPLICATION TO
APPROPRIATE WATER FOR
QUASI-MUNICIPAL USE
BY NAVAL AIR STATION FALLON
FROM UNDERGROUND SOURCES
CHURCHILL COUNTY, NEVADA

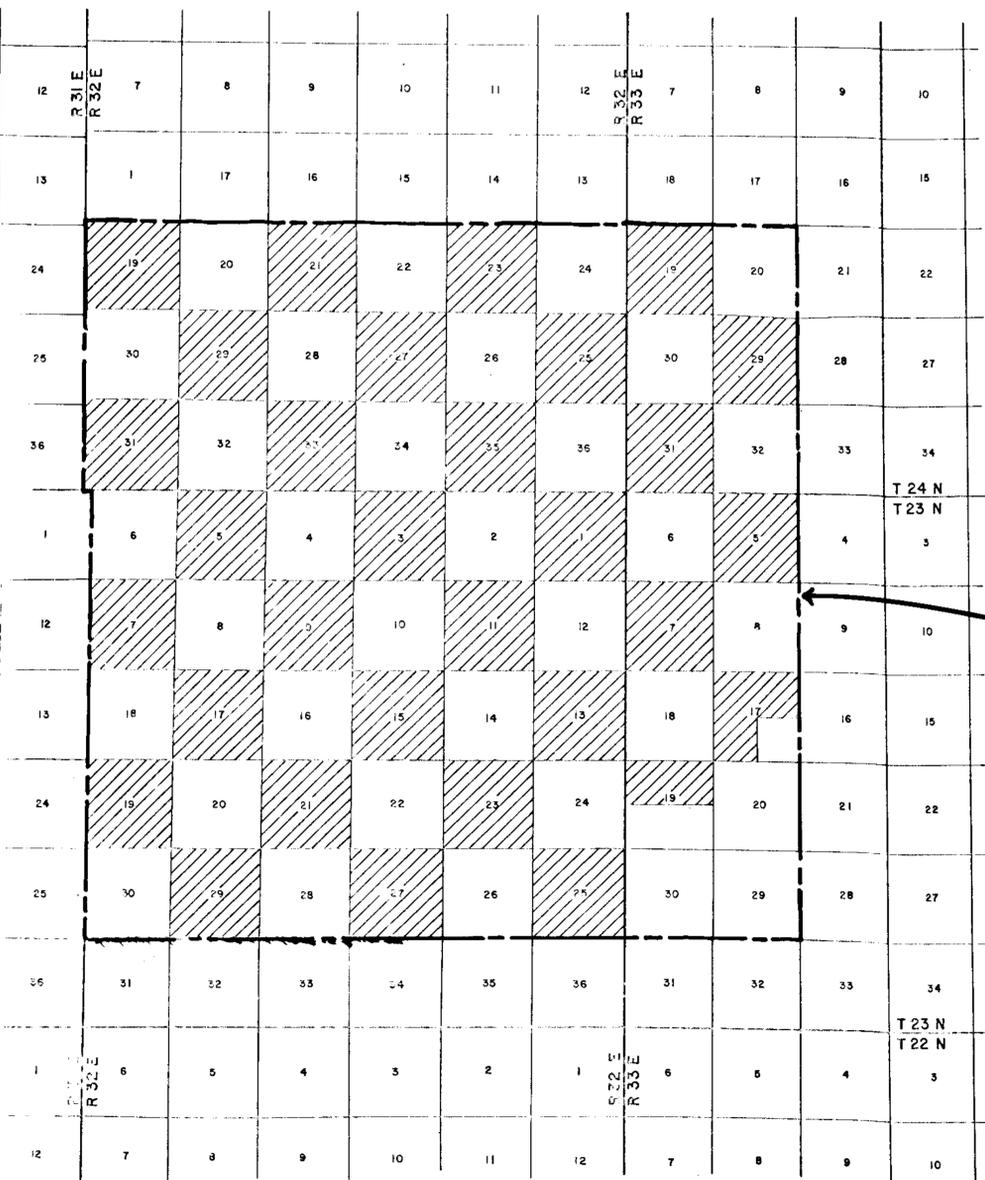

NAVY BOMBING RANGE B-20

ITEM-56
 CIVIL CV-R-82-32B-ECR
 19,429.35 AC.
 REMAINDER OF LAND INSIDE STATION
 BOUNDARY IS PENDING ACTION ON A
 PUBLIC LAND ORDER.
 21,600 AC.

Portion of T23 & 24 N, R 32 & 33 E

PUBLIC DOMAIN LANDS WITHIN B-20 WERE WITHDRAWN BY THE "WITHDRAWAL OF PUBLIC LANDS FOR MILITARY PURPOSES ACT OF 1906" (PL 99-606)

M.D.B. S.M.

65112 CERTIFICATE NO. 116303 ISSUED 03-02-04

FILED
 JUN 11 1999
 STATE ENGINEER'S OFFICE



STATE ENGINEER'S USE 1) MAP TO ACCOMPANY APPLICATION TO APPROPRIATE WATER FOR QUASI-INDUSTRIAL USE BY HAWAIIA STATION FALLON FROM UNDERGROUND SOURCE, CHAMBERLAIN COUNTY, NEVADA © 1-8-71		WEST DIV. DWG. NO. C-104223	DEPT. OF THE NAVY NAVAL FACILI WESTERN DIVISION, S
		COMPILED BY: J.A. TOMEO	NAVAL AIR
RECEIVED JUN 11 1999 UIC N60495		DRAWN BY: J.A. TOMEO	FALLON
		CHECKED BY: F. Young	REAL ESTATE S
RECEIVED JUN 11 1999 UIC N60495		REVIEWED BY: M. Maloney, P.E.S.	SCALE: AS SHOWN
		HEAD, CADASTRAL SECTION	SHEET 2 OF 2
RECEIVED JUN 11 1999 UIC N60495		SALE FACTORY BY: M. Maloney, P.E.S.	DIRECTOR REAL ESTATE DIVISION FOR COMMANDER NAVFAC
		MANAGER QUALITY SERVICES BRANCH	