

STATE OF NEVADA )  
 ) ss.  
 COUNTY OF ELKO )


I, MARK C. BOGE, being first duly sworn, depose and say that this map, consisting of 2 sheets, numbered from 1 to 2, inclusive has been correctly drawn to the designated scale to accompany Applications To Change Point Of Diversion and Place of Use of a portion of Permit Numbers 51750 and 52354, from a survey conducted by me on the 19th day of August 2002; that the location of each reference monument has been verified by site inspection; that the proposed point of diversion and proposed place of use sites have been inspected; that this map has been compiled from survey calculation notes prepared by me, and by relying upon analysis of record surveying documents in the State Engineer's Office; that this map truly and correctly represents the proposed point of diversion and place of use in Eureka County, Nevada, for mining, milling, and domestic purposes from an underground source.

*Mark C. Boge*  
 Nevada State Water Right Surveyor No. 662



SUBSCRIBED and SWORN to before me  
 this 1 day of October, 2002

*P.J. Glass*  
 Notary Public in and for  
 Elko County, Nevada  
 My Commission Expires April 11, 2006

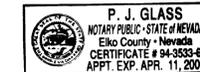

NOTES:



1. BASIS OF BEARINGS IS A LINE OF KNOWN BEARING, BEING THE LINE BETWEEN THE SE CORNER AND THE SW CORNER OF SEC. 3, T35N, R50E. MDM. THE RECORD SOURCE FOR THIS BEARING IS THE OFFICIAL GOVT. PLAT APPROVED OCT. 18, 1921, FILED AT USDOI, BLM STATE OFFICE, RENO, NEVADA.
2. SECTION LINES ARE PROTRACTED BY REFERENCE TO BLM GEOGRAPHIC COORDINATE DATA BASE AND HISTORICAL SURVEY RECORDS MAINTAINED BY THE APPLICANT.
3. THE PURPOSE OF THIS MAP IS TO:  
 SERVE APPLICATIONS 68934 AND 68935T (CHANGE PORTION 52354)  
 SERVE APPLICATIONS 69152 AND 69151T (CHANGE PORTION 51750)  
 REVISE POD TIE FOR PERMIT 50939/CERTIFICATE 13880  
 REVISE POD TIE FOR PERMIT 51750  
 REVISE POD TIE FOR PERMIT 52354

LEGEND

- ◇ SECTION CORNER REFERENCE MONUMENT
- ◆ 1/4 SECTION CORNER REFERENCE MONUMENT
- PROPOSED POINT OF DIVERSION



T35 & 36N, R50E, MDM  
 0 1000 2000 3000  
 SCALE: 1"=1000'

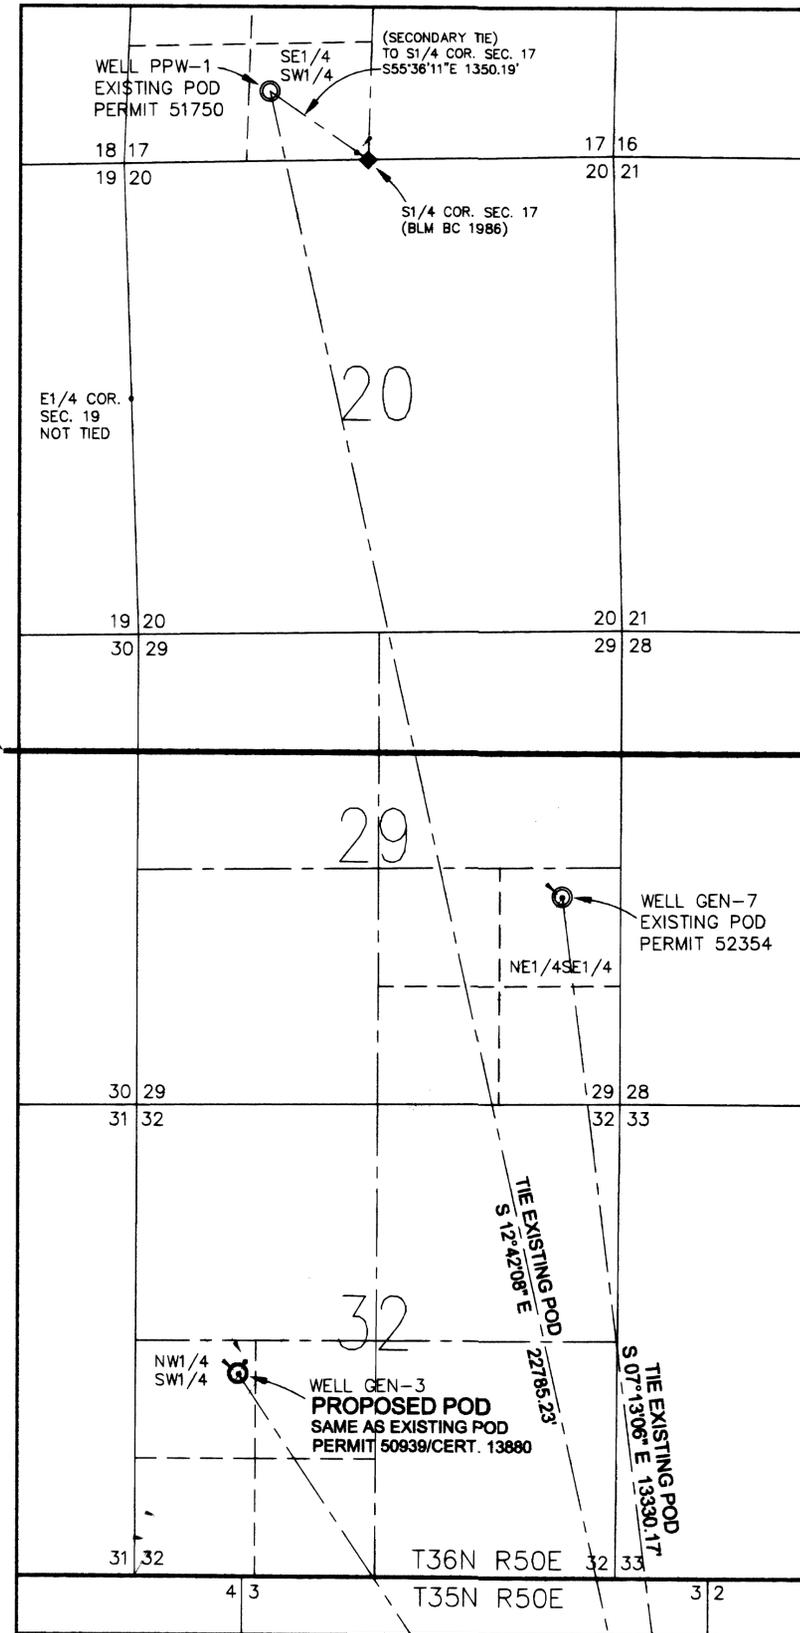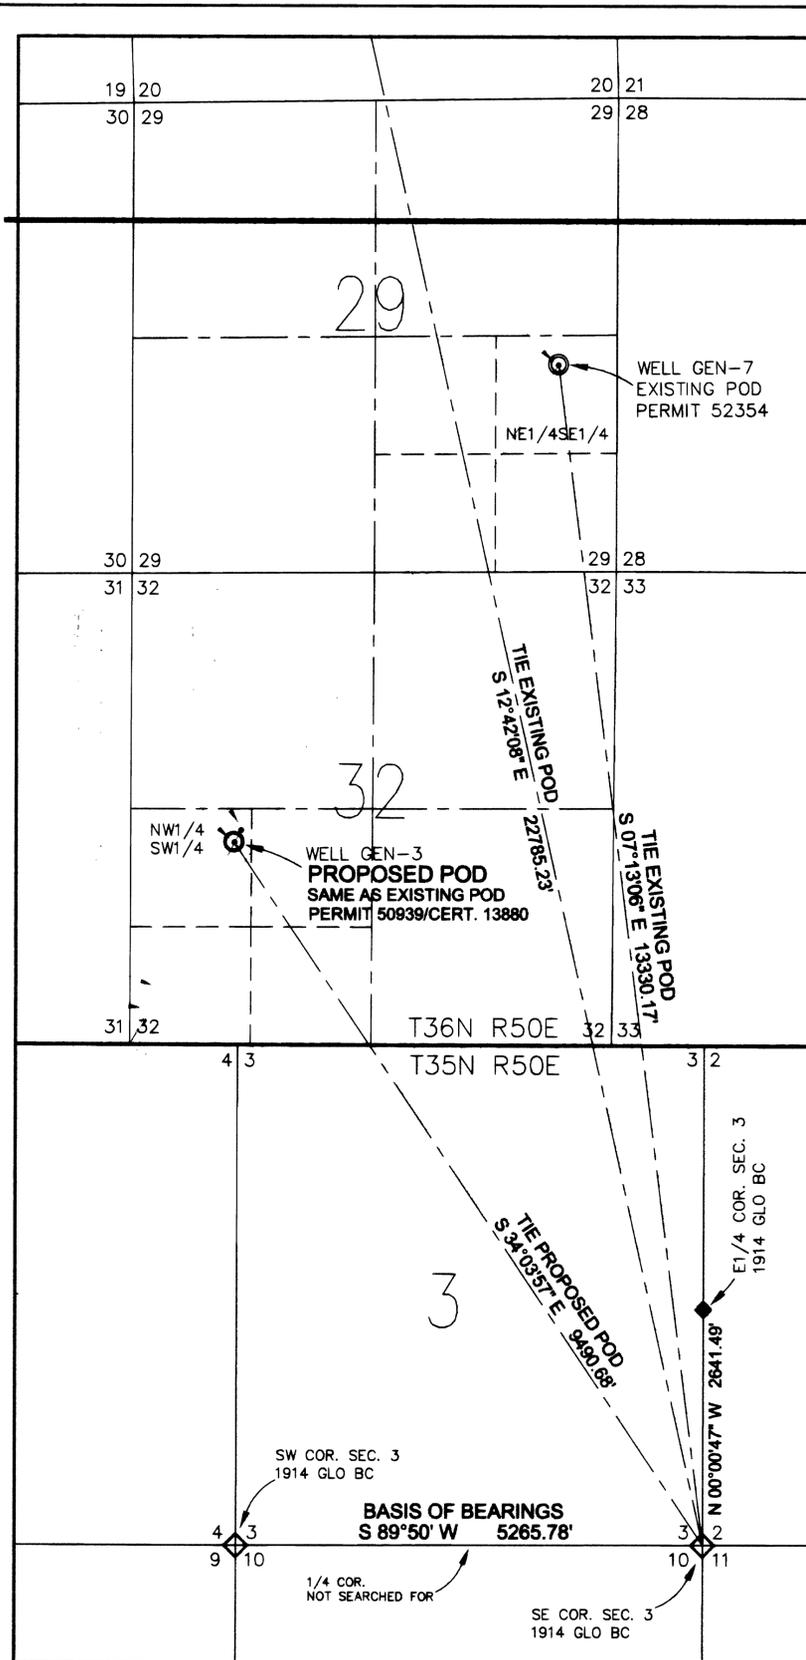

THIS SHEET SHOWS THE EXISTING AND PROPOSED POINTS OF DIVERSION  
 SEE SHEET 2 OF 2 FOR EXISTING AND PROPOSED PLACES OF USE

MARK C. BOGE, PLS  
 2085 SAWYER WAY  
 Elko, Nevada 89801  
 phone (775) 777-2822  
 DRAWING NO. 02-100302

STATE ENGINEER'S USE


**FILED**  
 OCT 04 2002  
 STATE ENGINEER'S OFFICE

MAP TO ACCOMPANY  
 APPLICATION TO CHANGE  
 POINT OF DIVERSION AND PLACE OF USE  
 OF A PORTION OF PERMIT NUMBERS 51750 AND 52354

FOR MINING, MILLING AND DOMESTIC  
 BY NEWMONT GOLD COMPANY  
 FROM UNDERGROUND; GENESIS MINE; WELL GEN-3  
 IN EUREKA COUNTY, STATE OF NEVADA

SHEET 1 OF 2 SHEETS

69152 69151T 68935T 68934

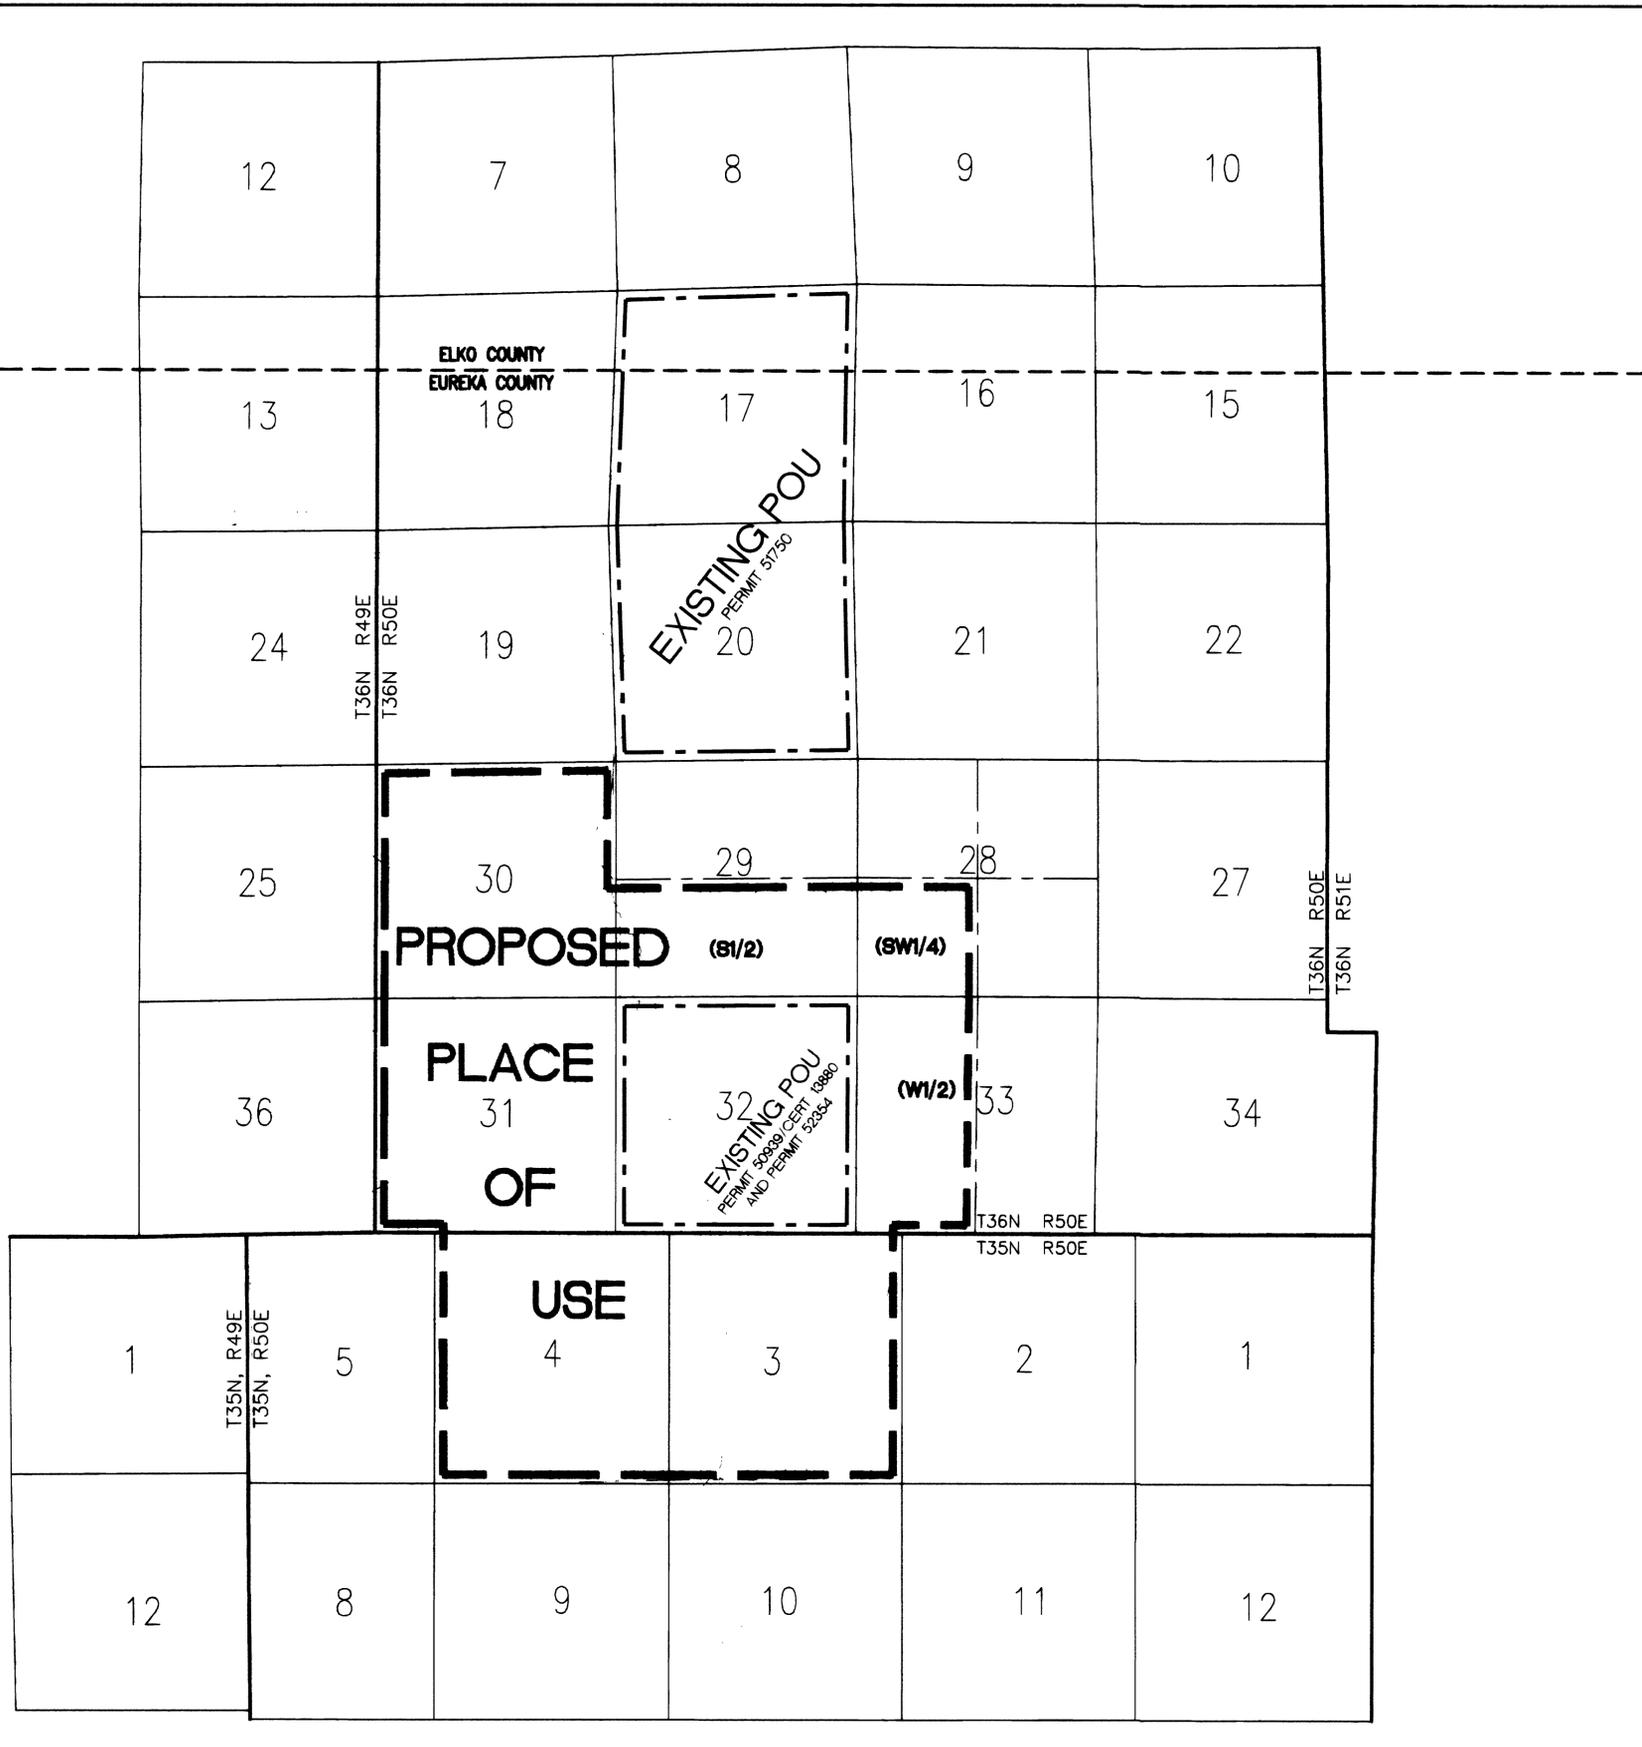

EXISTING PLACES OF USE

PERMIT NUMBER 51750  
 REFERENCE MADE TO MAP ACCOMPANYING PERMIT NUMBER 51750.  
 T36N, R50E, MDM: SECTIONS 17 AND 20

PERMIT NUMBER 52354  
 REFERENCE MADE TO MAP ACCOMPANYING PERMIT NUMBER 52354  
 T36N, R50E, MDM: SECTION 32

PROPOSED PLACE OF USE

T35N, R50E, MDM: ALL OF SECTIONS 3 AND 4  
 T36N, R50E, MDM: SW1/4 OF SECTION 28  
 S1/2 OF SECTION 29  
 ALL OF SECTIONS 30, 31, 32  
 W1/2 OF SECTION 33

LEGEND

--- EXISTING PLACES OF USE  
 - - - PROPOSED PLACE OF USE



T35 & 36N, R50E, MDM  
 0 2000 4000 6000  
 SCALE: 1"=2000'

SHEET 2 OF 2, PLACE OF USE

STATE ENGINEER'S USE	
68941 68935-T 69151-T 69152	
MAP TO ACCOMPANY APPLICATION TO CHANGE POINT OF DIVERSION AND PLACE OF USE OF A PORTION OF PERMIT NUMBERS 51750 AND 52354	
FOR	MINING, MILLING AND DOMESTIC
BY	NEWMONT GOLD COMPANY
FROM	UNDERGROUND; GENESIS MINE; WELL GEN-3
IN	EUREKA COUNTY, STATE OF NEVADA
SHEET 2 OF 2 SHEETS	

THIS SHEET SHOWS THE EXISTING AND PROPOSED PLACES OF USE  
 SEE SHEET 1 OF 2 FOR EXISTING AND PROPOSED POINTS OF DIVERSION

MARK C. BOGE, PLS  
 2085 SAWYER WAY  
 ELKO, NEVADA 89801  
 phone (775) 777-2822  
 DRAWING NO. 02-100302