

DESCRIPTION OF EXISTING POINT OF DIVERSION

THE EXISTING POINT OF DIVERSION IS IN THE SW 1/4 NE 1/4 SECTION 23, T. 14 S., R. 65 E., M.D. & M. AT A POINT FROM WHICH THE NW CORNER OF SAID SECTION 23 BEARS N. 52°30'21" W. AT A DISTANCE OF 5388.23'.

EXISTING PLACE OF USE

A PORTION OF NE 1/4 NE 1/4 SECTION 26 AND A PORTION OF SW 1/4 NE 1/4 SECTION 26, T. 14 S., R. 65 E., M.D. & M.

PROPOSED POINT OF DIVERSION

THE PROPOSED POINT OF DIVERSION IS IN THE NE 1/4 NE 1/4 OF SECTION 22, T. 14 S., R. 65 E., M.D. & M. AT A POINT FROM WHICH THE E1/16 CORNER OF SAID SECTION 22 BEARS N. 23°20'46" W. AT A DISTANCE OF 764.60'.

PROPOSED PLACE OF USE

A PORTION OF THE NE 1/4 NE 1/4 OF SECTION 22, T. 14 S., R. 65 E., M.D. & M. CLARK COUNTY, NEVADA.

EXISTING MANNER OF USE

IRRIGATION

PROPOSED MANNER OF USE

IRRIGATION

BASIS OF BEARING

GPS ACCURACY 0.5 METERS

AFFIDAVIT




STATE OF NEVADA)
COUNTY OF CLARK)

I, Lonnie C. Roy, being first duly sworn, depose and say that site inspections have been made by me, or under my direction, on June 16 and October 13, 2003, and April 9, 2004, that the location of each reference monument has been verified by site inspection; that the point of diversion and place of use sites have been inspected; that this map, consisting of 1 sheet, has been correctly drawn to the designated scale from surveying calculation notes prepared by me, or under my supervision and direction, relying upon analysis of recorded survey maps and other recorded surveying documents in the office of the State Engineer and Clark County Records; that this map truly and correctly represents the proposed location and extent of the works used to divert water from underground, in Clark County, Nevada, by Venna Leavitt Davis for irrigation purposes. That the proposed point of diversion, the approximate location and size of the diverting channel or other conduit, all reservoirs or basins, the location and names of all other works which will cross or connect with the proposed works, and the boundary of all lands, are fully and correctly designated.

Lonnie C. Roy
LONNIE C. ROY, P.E.
NEVADA STATE WATER RIGHTS SURVEYOR NO. 862

NOTARY'S ACKNOWLEDGMENT
SUBSCRIBED AND SWORN TO BEFORE ME
THIS 9th DAY OF April, 2004.

Kenya Henderson
NOTARY PUBLIC IN AND FOR CLARK COUNTY, NEVADA.
MY COMMISSION EXPIRES 8/29/07

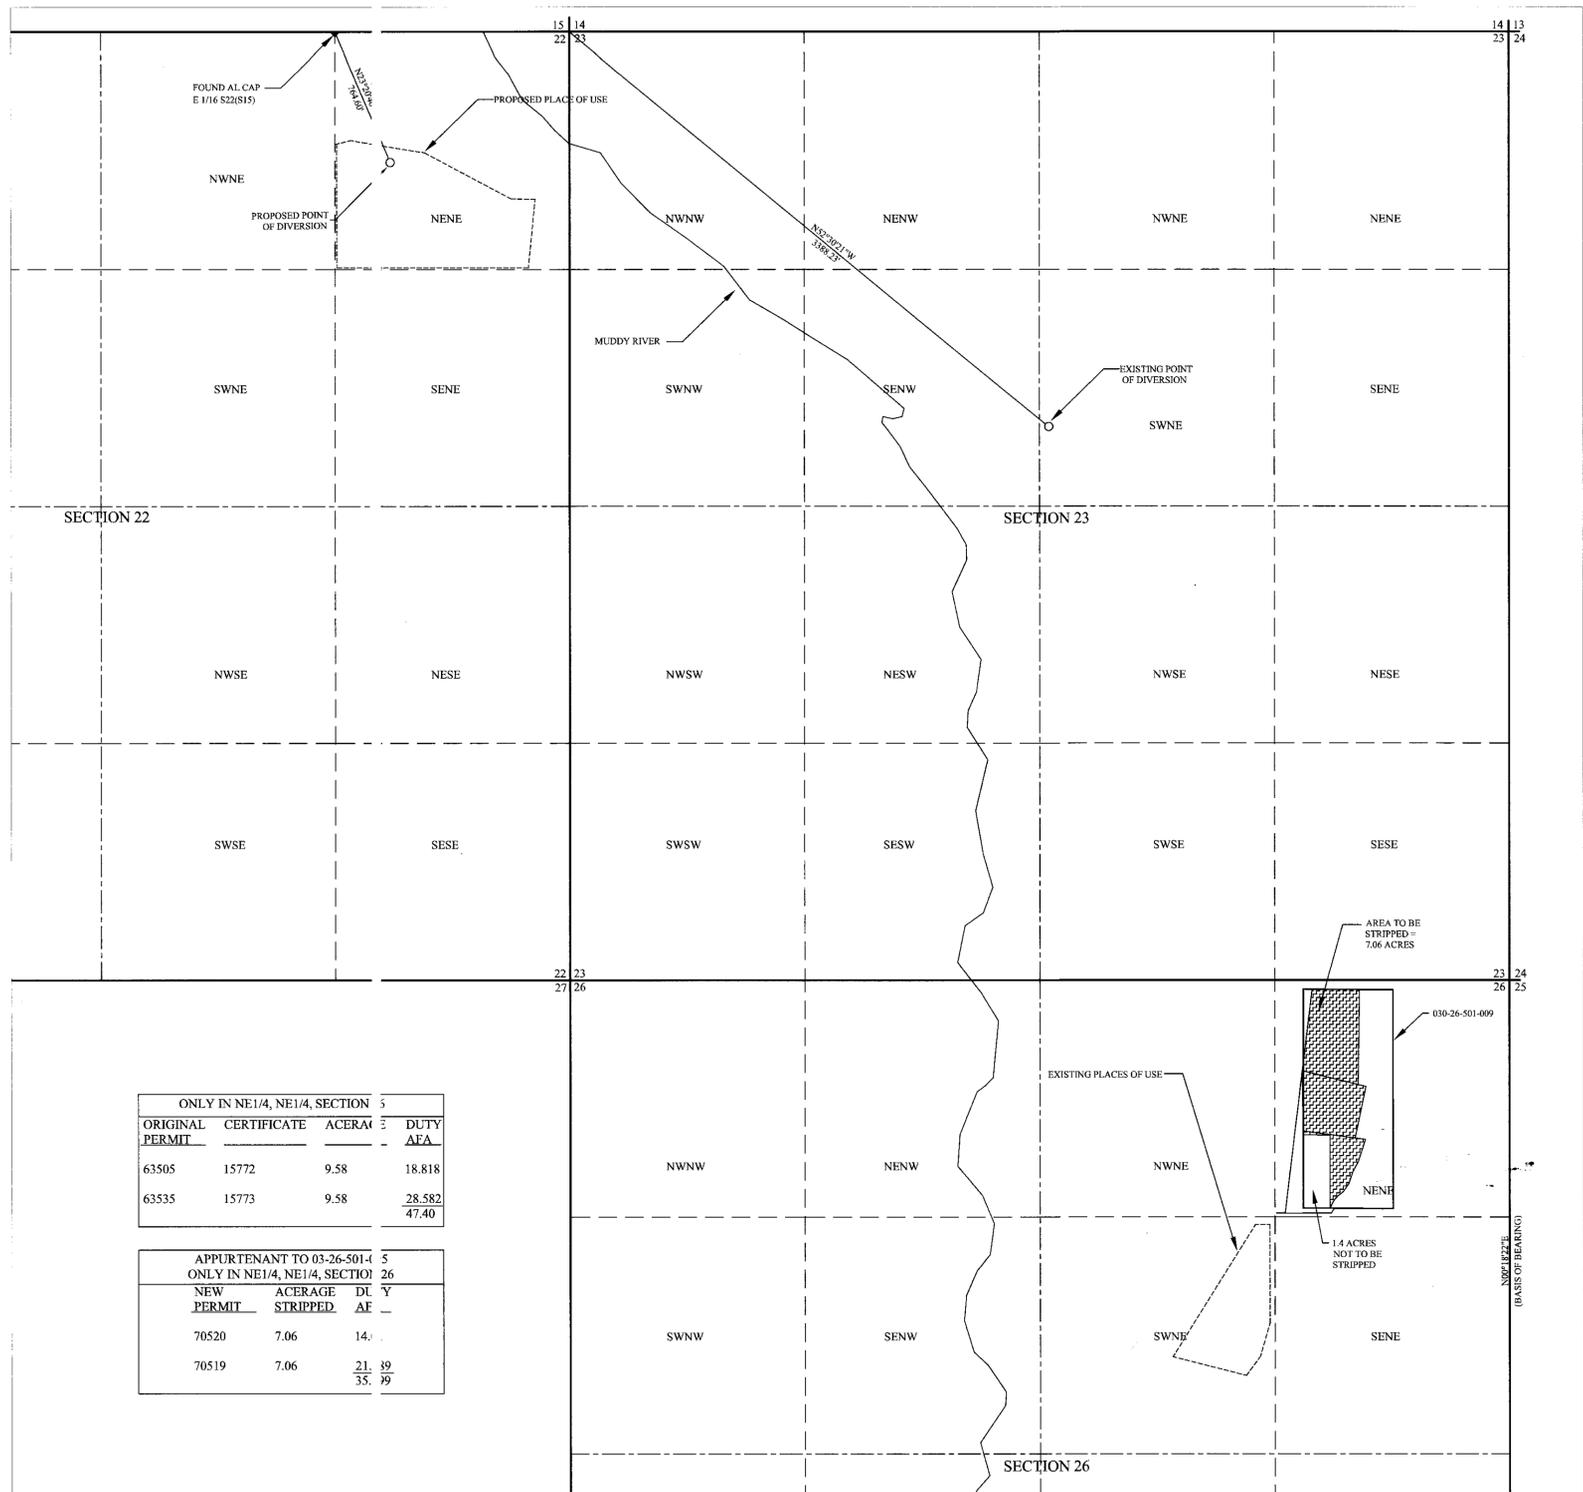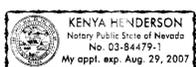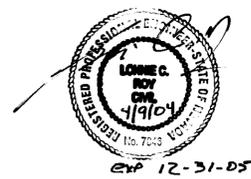


T. 14 S., R. 65 E. M.D. & M.

REFERENCE

RECORD SURVEY FILE 69 PAGE 74
PARCEL MAP FILE 78 PAGE 54
CLARK COUNTY AIR PHOTOS

BROADBENT & ASSOCIATES, INC.
ENGINEERING, WATER RESOURCES & ENVIRONMENTAL
8 West Pacific Avenue,
Henderson, Nevada 89015
(702) 563-0800

Project No. 03-01-177-001

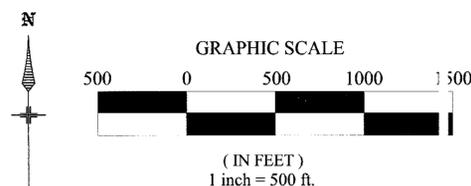

STATE ENGINEER'S USE
FILED APR 12 2004 STATE ENGINEER'S OFFICE
RAD 4-12-04 Ignore note in SE NE Sec 26, per letter in file dated 4-12-04. Also, change APN # in tabulation in Sec 27 to 030-26-501-009
SWAZLIAN 7-29-2003 NOTE IN SENE SEC 26 SHOULD READ (FOR CLAZIFICATION) "2.42 ACRES REMAIN IN NENE SEC 26" AREA IN NW CORNER OF APN 030-26-501-009 DOES NOT HAVE WATER UNDER PERMIT 63505 ALSO NOTE IN TABULATION OF DATA SHOULD BE 9.48 ACRES IN STEAD OF 9.38 ACRES.

STRIPPING MAP TO ACCOMPANY APPLICATION TO CHANGE THE POINT OF DIVERSION AND PLACE OF USE OF A PORTION OF PERMITS 63505 (CERT 15772) AND PERMIT 63535 (CERT 15773) FOR IRRIGATION PURPOSES BY VENNA LEAVITT DAVIS FROM UNDERGROUND SOURCE IN CLARK COUNTY, NEVADA

86209 71223 70520 70519