

STATE OF NEVADA } S.S.
 WASHOE COUNTY }


I, ROY H. HIBDON, BEING FIRST DULY SWORN, DEPOSE AND SAY THAT THIS MAP CONSISTING OF ONE SHEET HAS BEEN CORRECTLY DRAWN TO THE DESIGNATED SCALE FROM INFORMATION ON FILE IN THE OFFICIAL RECORDS OF WASHOE COUNTY, NEVADA, AND MAPS PREPARED BY THE WASHOE COUNTY ASSESSOR, ON OR BEFORE APRIL 15, 2005. THAT IT TRULY AND CORRECTLY REPRESENTS THE EXTENT AND LOCATION OF THE PLACE OF USE OF WATER HERETOFORE APPROPRIATED UNDER A PORTION OF TRUCKEE RIVER CLAIM 187 BEING CHANGED BY LENNAR RENO, LLC FOR MUNICIPAL AND DOMESTIC PURPOSES. THAT THE PLACE OF USE, THE LOCATION AND NAME OF ALL OTHER WORKS, AND THE BOUNDARY OF ALL LANDS, SHOWN BY 40 ACRE SUBDIVISIONS, ARE FULLY AND CORRECTLY DESIGNATED HEREON.

Roy H. Hibdon

ROY H HIBDON
 SWRS NO. 370

SUBSCRIBED AND SWORN TO BEFORE ME A NOTARY PUBLIC IN AND FOR WASHOE COUNTY, NEVADA, THIS 20 DAY OF October, 2005.

Valerie W. Ball
 NOTARY PUBLIC
 MY COMMISSION EXPIRES
 8-17-07

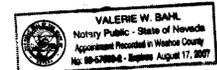

REFERENCES:

AMENDED MAP OF SIERRA MANNER SUBDIVISION, WASHOE COUNTY, NEVADA TRACT MAP #44B

BASIS OF BEARINGS:

THE BEARING OF THIS MAP IS BASED ON THE WEST LINE OF AMENDED MAP OF SIERRA MANNER SUBDIVISION AS SHOWN ON TRACT MAP #44B OF AMENDED MAP OF SIERRA MANNER SUBDIVISION. RECORDED IN WASHOE COUNTY RECORDERS OFFICE.

POINT OF DIVERSION AFTER TRANSFER:



EXISTING TRUCKEE MEADOWS WATER AUTHORITY POINTS OF DIVERSION DESCRIBED IN PERMIT ~~71534~~ AND ~~71606~~ AND AS SHOWN ON THE SUPPORTING MAP ACCOMPANYING SAID PERMIT ON FILE WITH THE STATE ENGINEER.

PLACE OF USE AFTER TRANSFER:

THE WATER SERVICE AREA OF THE TRUCKEE MEADOWS WATER AUTHORITY AS SHOWN ON THE SUPPORTING MAP ON FILE UNDER PERMIT ~~71534~~ AND ~~71606~~.

EXISTING POINT OF DIVERSION:

ENGLISH MILL DITCH AT A POINT FROM WHICH THE NORTHWEST CORNER OF SECTION 20, T19N, R19E MD&M BEARS S44°40' WEST A DISTANCE OF 3,211 FEET. THE SE 1/4 OF NE 1/4 OF SECTION 14, T19N, R18E, OR AT A POINT FROM WHICH THE NW CORNER OF SECTION 13 T19N, R18E, BEARS N 24°26' E A DISTANCE OF 1,840 FEET, LAST CHANCE DITCH PER ORR DITCH DECREE.

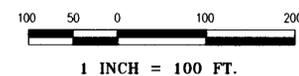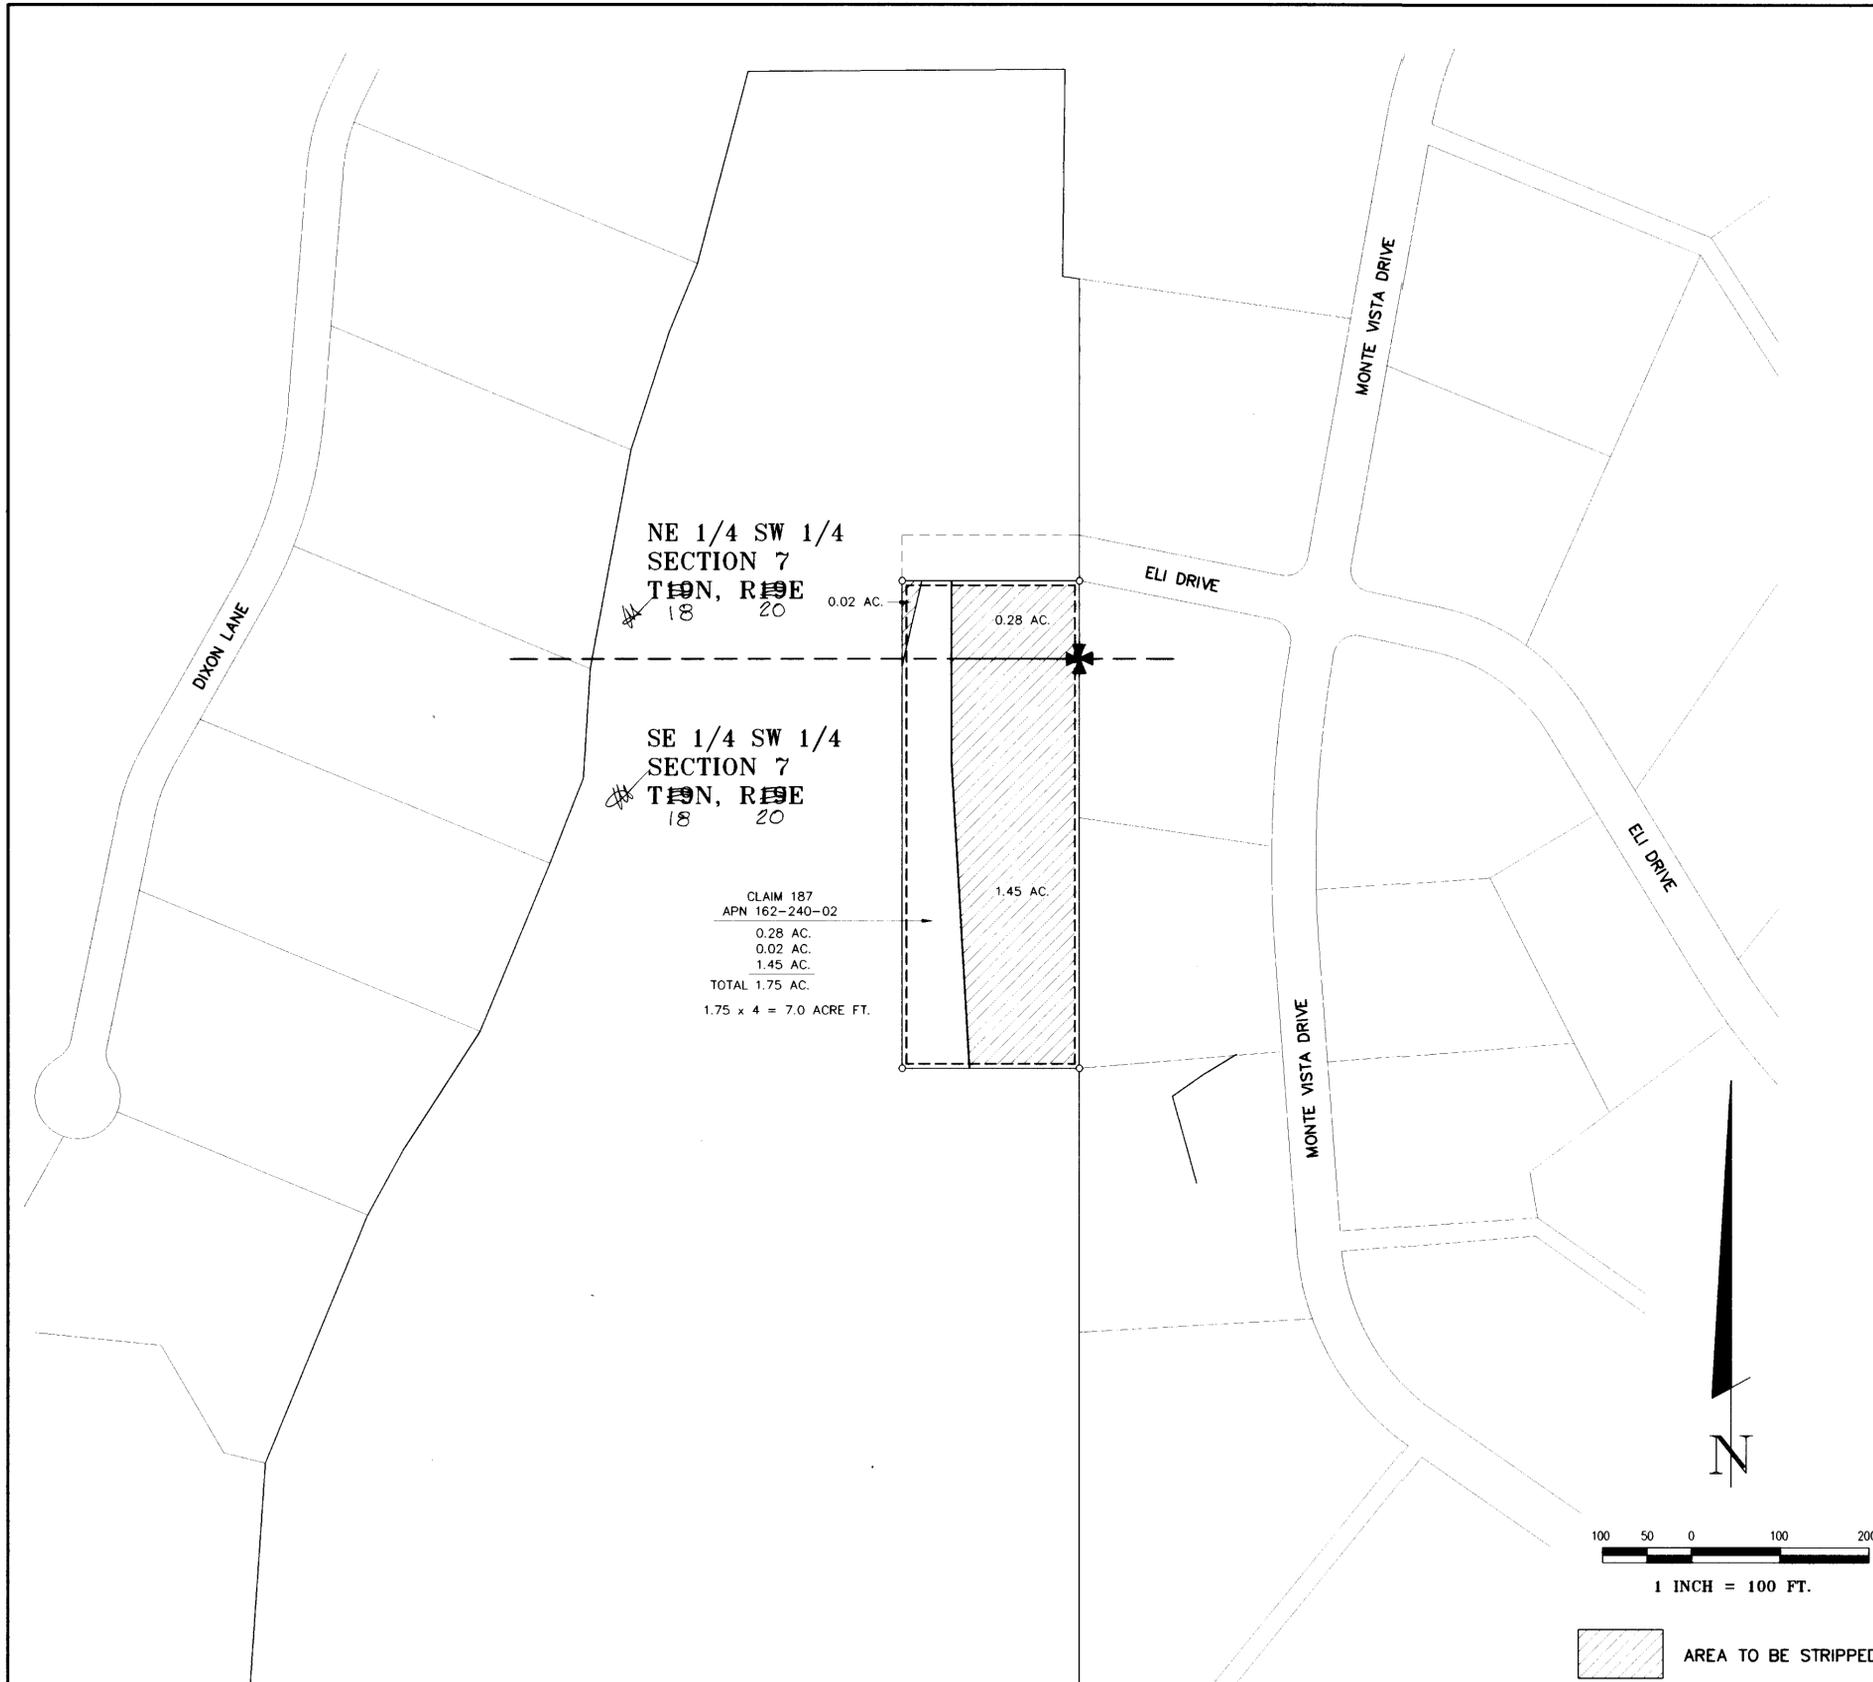

AREA TO BE STRIPPED

STATE ENGINEER'S USE

73384
FILED
 OCT 24 2005
 STATE ENGINEER'S OFFICE

MAP

TO ACCOMPANY APPLICATION TO CHANGE THE POINT OF DIVERSION, & PLACE AND MANNER OF USE OF A PORTION OF CLAIM 187 OF THE TRUCKEE RIVER DECREE.

LENNAR RENO, LLC.
 A NEVADA LIMITED LIABILITY COMPANY

FOR MUNICIPAL & DOMESTIC PURPOSES
 WASHOE COUNTY NEVADA

ROY H. HIBDON
 CIVIL ENGINEERING CONSULTANTS, LTD.
 1479 S. WELLS, SUITE #21, RENO NV.
 PH: (775) 323-4801 FAX: (775) 323-1020

DATE: 10-19-05
 DRAWN BY: CV
 CHECKED BY: RHH
 JOB NO.: