
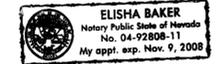


SURVEYOR'S AFFIDAVIT

I, Lenard D. Smith, being first duly sworn, depose and say that this map, consisting of one sheet has been correctly drawn to the designated scale from field notes of a survey made by me on July 12, 2006, that it truly and correctly represents the proposed location and extent of the works used to divert water from underground in Lincoln County, Nevada by Kelly B. Jensen and Karla R. Jensen for irrigation purposes. That the proposed point of diversion, the approximate location and size of the diverting channel or other conduit, all reservoirs or basins, the location and names of all other works which will cross or connect with the proposed works, and the boundary of all lands, showing by 40-acre subdivisions the areas proposed to be served, are fully and correctly designated thereon.

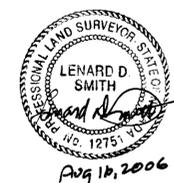

Lenard D. Smith, State Water Right Surveyor #1033 Expires 6/30/08

Subscribed and sworn to before me this 16th day of August, 2006

Elisha Baker
Notary Public

My commission Expires 11-9-2008

LEGEND

- ◆ Quarter Corner found as described
- Quarter section line
- Sixteenth section line
- Irrigation ditch
- Proposed Place of Use
- Highway 93 right of way
- Proposed point of diversion for a portion of Permit 26638
- Pahrangat Valley Creek (Pahrangat Valley central drain)


BASIS OF BEARINGS

The Basis of Bearings for this map is the east line of the northwest quarter of Section 16, T. 7 S., R. 61 E., M.D.M. given as S 00°09'38" W in the map of the Stewart Subdivision recorded Plat Book A, Page 133 of Lincoln County, Nevada Records.

MAP NOTES:

The Place of Use under this application is in Lot 9 of the Stewart Subdivision of the Map Recorded Plat Book A, Page 133 of Lincoln County, Nevada Records, from which this map was constructed


The existing point of diversion for this application is shown on the accompanying map under Permit 26638 which is the application to change the remainder the Jensen's right.

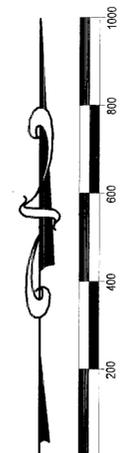

SCALE: 1" = 200'

Lenard Smith Land Survey
509 Main Street
P.O. Box 443
Caliente, Nevada 89001
Phone/Fax 775 726 3365
Cell Phone 775 992 1196

For State Engineer's Use
9-29-2006-KSM. SURVEYOR'S AFFIDAVIT SHOULD SAY CONSISTING OF TWO SHEETS.

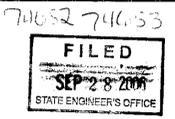

MAP
To Accompany Application to Change the Point of Diversion and Place of use of a Portion Under Permit 26638, Certificate 9368

For Irrigation & domestic
By Kelly B. Jensen and Karla R. Jensen

From Underground
In Lincoln County, Nevada

SURVEYOR'S AFFIDAVIT

I, Lenard D. Smith, being first duly sworn, depose and say that this map, consisting of two sheets has been correctly drawn to the designated scale from field notes of a survey made by me on that I truly and correctly represents the proposed location and extent of the works used to divert water from underground in Lincoln County, Nevada by Kelly B. Jensen and Karla R. Jensen for irrigation and domestic purposes. That the proposed point of diversion, the approximate location and size of the diverting channel or other conduit, all reservoirs or basins, the location and names of all other works which will cross or connect with the proposed works, and the boundary of all lands, showing by 40-acre subdivisions the areas proposed to be served, are fully and correctly designated thereon.




Lenard D. Smith, State Water Right Surveyor #1033 Expires 8/30/08

Subscribed and sworn to before me this 27th day of September, 2006

Elisha Baker
Notary Public

My commission Expires 11-9-2008

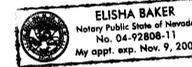


MAP REFERENCES

1. Parcel Map for Leo Stewart recorded Plat Book B, Page 14 of Lincoln County, Nevada Records.
2. Stewart Subdivision Map, Plat Book A, Page 132 & 133 of Lincoln County, Nevada Records.
3. Subsequent Parcel Maps Plat Book B, Pages 406 and 407 of Lincoln County, Nevada Records.
4. Existing Temporary Easement Book 147 Page 38, Official Records, Lincoln County, Nevada.

BASIS OF BEARINGS

G.L.O. Record: S89°58'W 2647.26'
S 89°56'00" W

Found #5 rebar with aluminum cap stamped R. Hafen PLS 4428 & stone mound locally accepted as the quarter corner

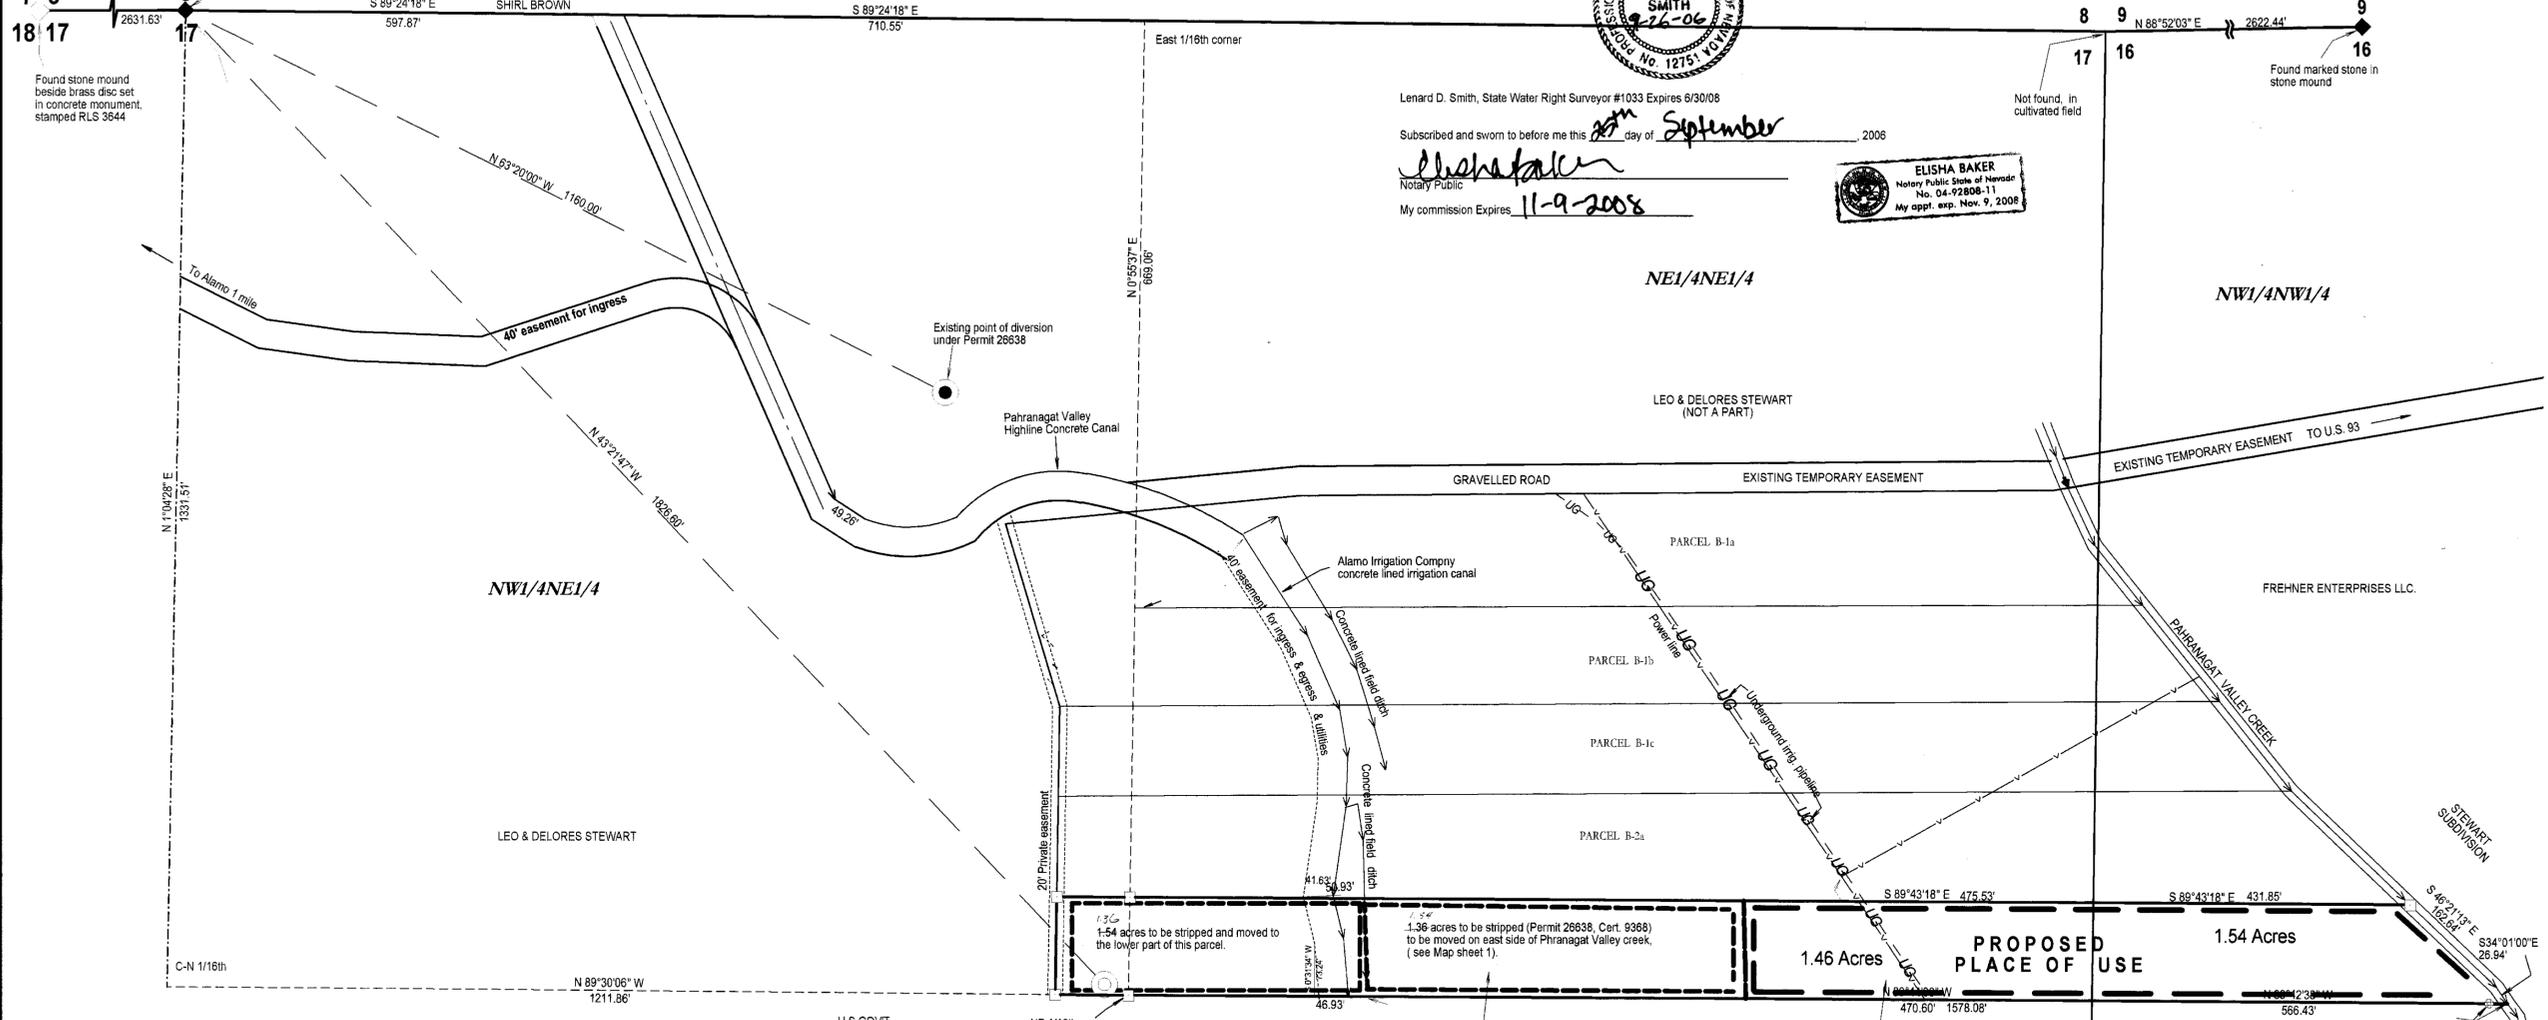

LEGEND


- Found rebar & cap stamped L SMITH PLS 12751
- UG— Underground irrigation pipeline
- Power line
- Pahranagat Valley Creek
- Section line
- - - Quarter section line
- - - Sixteenth section line
- Proposed Point of Diversion for a portion of Permit 26638
- Existing Point of Diversion under Permit 26638
- Area to be stripped for change of POU & POD

BASIS OF BEARINGS

The Basis of Bearings of this map is the west half of Section 17 north line, T.7S., R.61E., M.D.M. as given in G.L.O. survey records as S89°56'W.

MAP NOTE:

The place of use, including the proposed place of use is located in Parcel B-2b, recorded on Plat Book C, Page 226 of Lincoln County, Nevada Records

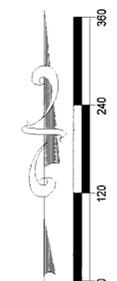

SCALE: 1" = 120'

For State Engineer's Use
 9-29-2006-KSM: THE 1.46 ACRES WITHIN THE NE 1/4 NE 1/4 SEC. 17 AS SHOWN ON MAP AS PROPOSED POU. IS ALSO BEING STRIPPED FROM PERMIT 26638, CERTIFICATE 9368 AND IS TO BE IRRIGATED BY THE NEW P.O.D.
 3-12-2007-MBW: THE 1.54 ACRES TO BE STRIPPED INCORRECTLY DESCRIBED AS 1.36 ACRES. SHOULD BE THE OPPOSITE, THE LAND THAT SHOWN AS 1.54 ACRES IS 1.36 ACRES.

FILED
 SEP 28 2006
 STATE ENGINEER'S OFFICE

Map
 To Accompany Application to Change the Point of Diversion and Place of Use
 For Irrigation and Domestic
 From Underground
 In Lincoln County, Nevada