

BASIS OF BEARING
 EAST LINE OF THE NE QUARTER OF SECTION 33, TAKEN AS N 00° 28' W, PER B.L.M. DEPENDENT RESURVEY PLAT FOR T38N, R42E, MDM, FILED IN THE NEVADA LAND OFFICE ON MAY 31, 1966, WHICH IS BASED ON TRUE NORTH.

STATE OF NEVADA } SS.
 COUNTY OF WASHOE }

I, MICHAEL S. SMITH, BEING FIRST DULY SWORN DEPOSE AND SAY THAT THIS MAP, CONSISTING OF ONE (1) SHEET, HAS BEEN CORRECTLY DRAWN BY ME TO THE DESIGNATED SCALE UTILIZING INFORMATION OBTAINED FROM A FIELD SURVEY CONDUCTED BY ME ON SEPT. 11, 2008, DATA FROM THE BUREAU OF LAND MANAGEMENT, NEVADA STATE DEPARTMENT OF WATER RESOURCES, BARRICK TURQUOISE RIDGE INC., AND PINSON MINING COMPANY. THIS MAP IS TO ACCOMPANY AMENDED TEMPORARY APPLICATIONS 77365T, 77366T, 77367T, 77368T, 77369T, 77370T, 77371T, AND ~~77426T~~ THESE TEMPORARY APPLICATIONS CHANGE THE POINT OF DIVERSION AND PLACE OF USE OF PERMITS 58406 (PORTION), 58408, 61602 (PORTION), 61688 (PORTION), 63109 (PORTION), 65907, AND 65908, AND ALSO CHANGE THE MANNER OF USE OF PERMIT 58408.

THIS MAP TRULY AND CORRECTLY REPRESENTS THE PROPOSED PLACE OF USE AND THE PROPOSED POINTS OF DIVERSION FROM UNDERGROUND SOURCES WITHIN HUMBOLT COUNTY, NEVADA, FOR MINING, MILLING, AND DEWATERING USES, BY BARRICK TURQUOISE RIDGE INC.

Michael S. Smith
 MICHAEL S. SMITH STATE WATER RIGHT SURVEYOR NO. 717



Michael S. Smith
 MICHAEL S. SMITH
 9-26-08
 No. 6642
 EXP. 06/30/2010

SUBSCRIBED AND SWORN TO BEFORE ME THIS 26th DAY OF September 2008, NOTARY PUBLIC IN AND FOR WASHOE COUNTY, NEVADA.

Keith Weaver
 KEITH WEAVER
 Notary Public - State of Nevada
 Appointment Recorded In Washoe County
 No. 05-69985-2 - Expires September 6, 2009

MY COMMISSION EXPIRES September 6, 2009

PROPOSED PLACE OF USE DESCRIPTION:
 ALL OF SECTION 27, ALL OF SECTION 28, THE SE ¼ OF SECTION 29, ALL OF SECTION 32, ALL OF SECTION 33, THE N ½ N ½ OF SECTION 34 AND THE NW ¼ NW ¼ OF SECTION 35, WITHIN T38N, R42E, M.D.B.&M.

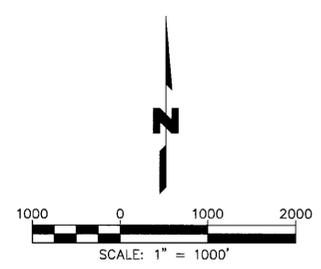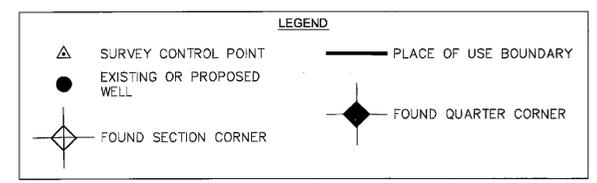

DATE	DRAWN BY	CHK'D BY	 HDR Engineering, Inc. 9805 Double R Blvd. Suite 101 Reno, Nevada 89521 Phone (775) 337-4700 Fax (775) 337-4774
09/26/08	GRB	MSS	
JOB NO.	DWG NO.	SHEET	
79195			

STATE ENGINEER'S USE

REL 9-23-08 spelling Humboldt County

FILED
 SEP 26 2008
 WASHOE COUNTY CLERK'S OFFICE

MAP TO ACCOMPANY AMENDED TEMPORARY APPLICATIONS 77365T, 77366T, 77367T, 77368T, 77369T, 77370T, 77371T, AND ~~77426T~~ TO CHANGE THE POINT OF DIVERSION AND PLACE OF USE OF PERMITS 58406 (PORTION), 58408, 61602 (PORTION), 61688 (PORTION), 63109 (PORTION), 65907, AND 65908, AND ALSO CHANGE THE MANNER OF USE OF PERMIT 58408, FOR MINING, MILLING, AND DEWATERING PURPOSES, BY BARRICK TURQUOISE RIDGE INC. FROM UNDERGROUND SOURCES IN HUMBOLT COUNTY, NEVADA

78956 78955T 77426T 77371T 77370T 77369T 77368T 77367T 77366T 77365T

DATE: 09/26/2008

SHEET 1 OF 1

C

B

A