

STATE OF NEVADA } S.S.
 COUNTY OF CARSON }

I, DAVID D. WINCHELL, BEING FIRST DULY SWORN, DEPOSE AND SAY THAT THIS MAP CONSISTING OF 1 SHEET HAS BEEN CORRECTLY DRAWN TO THE DESIGNATED SCALE FROM FIELD NOTES OF A SURVEY MADE BY ME, OR UNDER MY SUPERVISION AND DIRECTION, ON THE 6th DAY OF MAY, 2012; THAT THIS MAP TRULY AND CORRECTLY REPRESENTS THE PROPOSED LOCATION AND EXTENT OF THE WORKS USED TO DIVERT WATER FROM AN UNDERGROUND SOURCE, IN LYON COUNTY, NEVADA, BY MICHAEL W. HUGHES, TRUSTEE OF THE MICHAEL W. HUGHES TRUST DATED NOVEMBER 15, 2005, FOR INDUSTRIAL AND DOMESTIC PURPOSES; THAT THE PROPOSED POINT OF DIVERSION, THE APPROXIMATE LOCATION AND SIZE OF THE DIVERTING CHANNEL OR OTHER CONDUIT, ALL RESERVOIRS OR BASINS, THE LOCATION AND NAMES OF ALL OTHER WORKS OR STREAMS WHICH ARE CROSSED BY, OR CONNECTED WITH THE SAID WORKS, AND THE BOUNDARY OF ALL LANDS, SHOWING BY 40 ACRE SUBDIVISIONS THE AREAS TO BE SERVED ARE FULLY AND CORRECTLY DESIGNATED THEREON.



SUBSCRIBED AND SWORN TO BEFORE ME ON THIS 6 DAY OF July, 2012.



Gloria K. Lash
 NOTARY PUBLIC IN AND FOR Carson COUNTY, NEVADA.
 MY COMMISSION EXPIRES _____

REFERENCE DOCUMENTS


- ASSESSOR'S PARCEL MAP 16-15
- PARCEL MAP FOR CANYON ROCK INCORPORATED, RECORDED AS FILE No. 122259 ON FILE WITHIN THE OFFICE OF THE LYON COUNTY RECORDER.

BASIS OF BEARING:

THE BEARING N. 00°40'18" E., 2647.71' (M) FOR THE EAST LINE OF THE SE 1/4 OF SECTION 24, T. 16 N., R. 21 E., M.D.B.&M., AS SHOWN ON THE "PARCEL MAP FOR CANYON ROCK INCORPORATED", RECORDED AS FILE No. 122259 IN THE OFFICIAL RECORDS OF LYON COUNTY, NEVADA, WAS USED AS THE BASIS OF BEARINGS FOR THIS MAP.

LEGEND

- PROPOSED PLACE OF USE
- ⊙ PROPOSED POINT OF DIVERSION
- POINT OF DIVERSION PER APPLICATION PERMIT No. 67883, C-17686 (PREVIOUS SURVEYED POSITION)
- ▲ EXISTING AS-BUILT LOCATION
- ◆ FOUND 1/4 SECTION CORNER
- ◇ FOUND SECTION CORNER

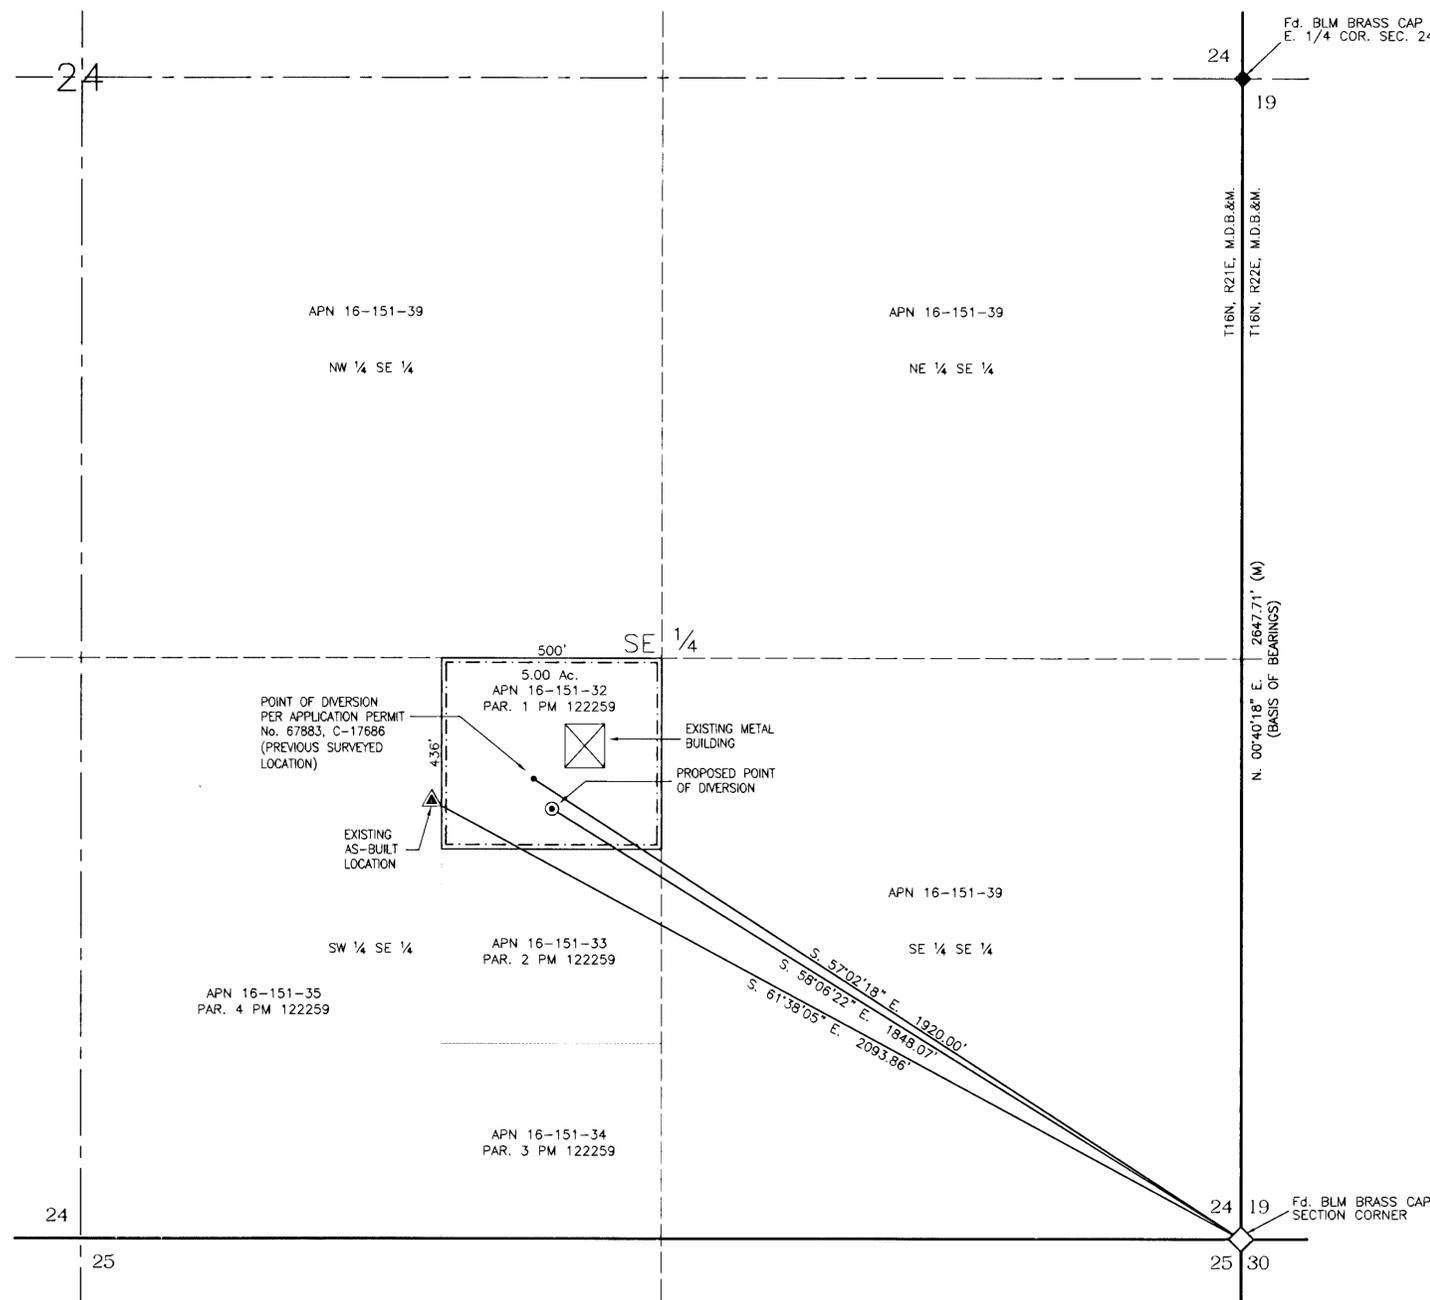


PROPOSED POINT OF DIVERSION AND PLACE OF USE
 PORTION OF THE SW 1/4 SE 1/4 SECTION 24, T. 16 N., R. 21 E., M.D.B.&M.

69039 CERTIFICATE NO. 19043 ISSUED 4-12-13



STATE ENGINEER'S USE

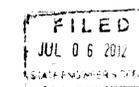

NEVADA SUBDIVISIONS DIV.
 1141 W. 9th ST. SUITE 200
 LAS VEGAS, NV 89102

MAP
 TO ACCOMPANY APPLICATION TO CHANGE THE POINT OF DIVERSION, MANNER AND PLACE OF USE OF A PORTION OF WATER HERETOFORE APPROPRIATED UNDER PERMIT 67883, CERTIFICATE 17686
 FOR: INDUSTRIAL AND DOMESTIC PURPOSES
 BY: MICHAEL W. HUGHES TRUST DATED NOV. 15, 2005
 FROM: UNDERGROUND SOURCE
 LYON COUNTY NEVADA

83301 69039 82000

file under