


SECTION	SUBDIVISION	TNSP	RANGE	CULTIVATED AVERAGE OF CULTURE	DATE OF FIRST CULTURE
34	SE 1/4 SW 1/4	45 N.	53 E.	10.5	NEED MORE DATA
34	SW 1/4 SE 1/4	45 N.	53 E.	4.0	NEED MORE DATA
3	NE 1/4 NW 1/4	44 N.	53 E.	0.6	NEED MORE DATA
3	NW 1/4 NE 1/4	44 N.	53 E.	15.8	NEED MORE DATA
3	NE 1/4 SE 1/4	44 N.	53 E.	29.0	NEED MORE DATA
2	SW 1/4 SE 1/4	44 N.	53 E.	8.0	NEED MORE DATA
2	NW 1/4 NW 1/4	44 N.	53 E.	9.4	NEED MORE DATA
2	SW 1/4 NW 1/4	44 N.	53 E.	7.8	NEED MORE DATA
2	SE 1/4 NW 1/4	44 N.	53 E.	18.9	NEED MORE DATA
2	NW 1/4 NE 1/4	44 N.	53 E.	7.4	NEED MORE DATA
TOTAL 114.3 AC. MEADOW LAY					

WATER RIGHT FILED IN OFFICE OF COUNTY RECORDER ELKO COUNTY, NEVADA BOOK 3 OF MISC. PG. 509 DATED MAY 8, 1888 COVERING DITCH NO. 1 & NO. 2

NOTE: NO. 4 DITCH WAS CONSTRUCTED AFTER 1905 AND IS NOT CLAIMED IN THIS PROOF.

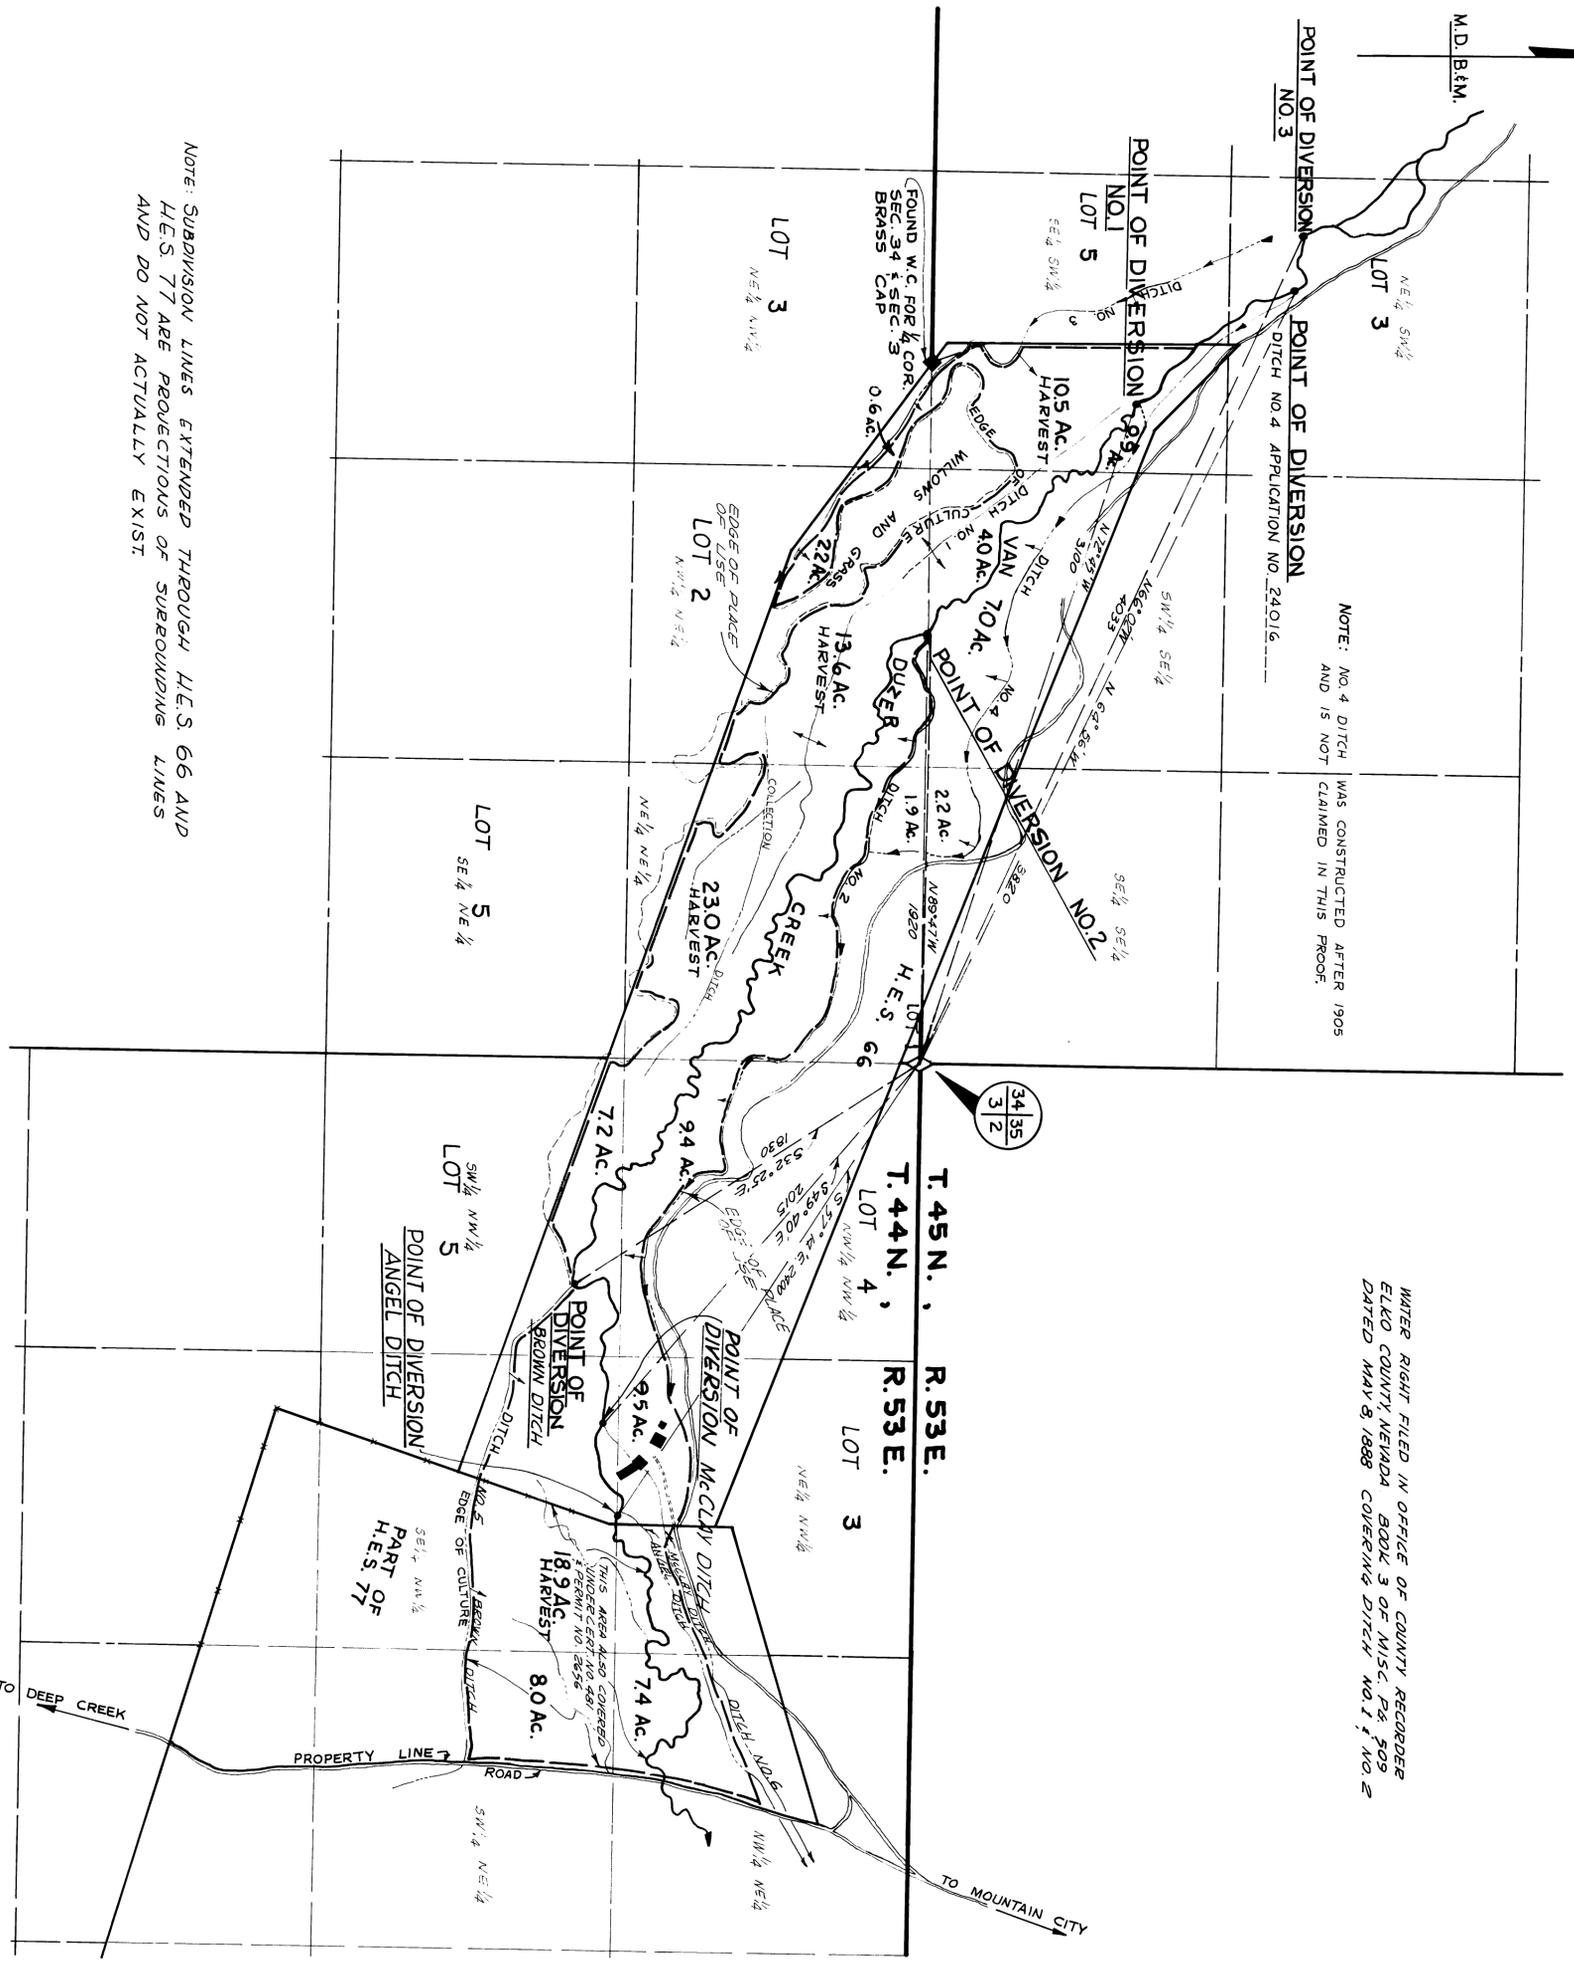


NOTE: SUBDIVISION LINES EXTENDED THROUGH H.E.S. 66 AND H.E.S. 77 ARE PROJECTIONS OF SURROUNDING LINES AND DO NOT ACTUALLY EXIST.

STATE OF NEVADA }
COUNTY OF ELKO } S.S.

I, MARK CHILTON, BEING FIRST DULY SWORN, DEPOSE AND SAY THAT THIS MAP, CONSISTING OF 1 SHEET, HAS BEEN CORRECTLY DRAWN TO THE DESIGNATED SCALE FROM FIELD NOTES OF A SURVEY MADE UNDER MY SUPERVISION AND DIRECTION ON THE 27th AND 28th DAYS OF FEBRUARY, 1967 AND FROM AERIAL PHOTOGRAPHS TAKEN THE 11th DAY OF MAY, 1967; THAT IT TRULY AND CORRECTLY REPRESENTS THE PROPOSED LOCATION AND EXTENT OF THE WORKS USED TO DIVERT WATER FROM VAN DUZER CREEK IN ELKO COUNTY, BY JOSEPHINE J. WILLIAMS & HENRY B. JARVIS FOR IRRIGATION, STOCKWATER AND DOMESTIC PURPOSES. THAT ALL OTHER WORKS, OR STREAMS WHICH ARE CROSSED BY OR CONNECTED WITH SAID WORKS, AND THE BOUNDARY, AREA AND KIND OF CULTURE OF LANDS IRRIGATED, ARE CORRECTLY SHOWN AND DESIGNATED HEREON.

STATE WATER RIGHT SURVEYOR #278

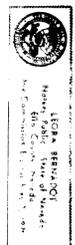

SUBSCRIBED AND SWORN TO BEFORE ME THIS 22nd DAY OF MAY, 1967

NOTARY PUBLIC IN AND FOR ELKO COUNTY, NEVADA

MAP
FOR
TO ACCOMPANY PROOF OF APPROPRIATION
STOCKWATER, IRRIGATION, & DOMESTIC

BY
JOSEPHINE J. WILLIAMS & HENRY B. JARVIS
FROM VAN DUZER CREEK

CHILTON ENGINEERING W67052
WESTERN PACIFIC BLDG. ELKO, NEVADA

02650

NO.	BY DATE	DESCRIPTION	CHG'D. LAMP
1		REVISIONS	
DRAWN BY R.H.B.			
APPROVED BY M.C.			
JOB NO. 236-001			
DATE MAY, 1967			