

Log No. _____
 Permit No. _____
 Basin **179**

PRINT OR TYPE ONLY
 DO NOT WRITE ON BACK

WELL DRILLER'S REPORT

Please complete this form in its entirety in accordance with NRS 534.170 and NAC 534.340

NOTICE OF INTENT NO. **60707**

1. OWNER **William Utter Sierra Pacific** ADDRESS AT WELL LOCATION **1 mile N.W. of**
 MAILING ADDRESS **U.S. 93 @ Lages station** **@ Lages station**

2. LOCATION **NE 1/4 SW 1/4 Sec. 4 T. 25 N. S. R. 65 @ White Pine** County
 PERMIT NO. **2335B** **008-110-06** **Utter Ranch Well**
 Issued by Water Resources Parcel No. **40.06966 Long: -114.63296 NAD 83** Subdivision Name

3. WORK PERFORMED
 New Well Replace Recondition
 Deepen Abandon Other _____

4. PROPOSED USE
 Domestic Irrigation Test
 Municipal/Industrial Monitor Stock

5. WELL TYPE
 Cable Rotary RVC
 Air Other _____

6. LITHOLOGIC LOG

Material	Water Strata	From	To	Thickness
sand + clay		0	40	40
sand + silt		40	70	30
sand with silt		70	80	10
sand with clay		80	130	50
clay with gravel		130	140	10
sandy clay		140	150	10
clay with sand		150	170	20
sand with clay + gravel		170	180	10
clay white to tan		180	200	20
gravel sand clay		200	220	20
clay with sand		220	260	40
gravel with clay + sand		260	270	10
gravel with clay + sand		270	280	10
clay with sand		280	300	20
sandy clay with gravel		300	340	40
gravel with clay		340	370	30
gravel with sand		370	380	10
gravel with sand		380	390	10
gravel with sand		390	430	40
sand + gravel		430	450	20
sandy clay		450	460	10
sandy clay with clay		460	470	10
sand with clay + gravel		470	480	10
gravel		480	520	40

40.069727 N
 114.632104 W
 NAD 83 (TA)

8. WELL CONSTRUCTION
 Depth Drilled **520** Feet Depth Cased **510** Feet

HOLE DIAMETER (BIT SIZE)

From	To
36 Inches	0 Feet 40 Feet
26 Inches	40 Feet 530 Feet

CASING SCHEDULE

Size O.D. (Inches)	Weight/Ft. (Pounds)	Wall Thickness (Inches)	From (Feet)	To (Feet)
16		.312	72	180
16		.312	280	340
16		.312	500	510

Perforations:
 Type perforation **lowered**
 Size perforation **.135**
 From **180** feet to **280** feet
 From **340** feet to **500** feet

Surface Seal: Yes No Seal Type:
 Neat Cement
 Cement Grout
 Concrete Grout

Depth of Seal **60**

Placement Method: Pumped
 Poured

Gravel Packed: Yes No
 From **520** feet to **60** feet

9. WATER LEVEL
 Static water level **60** feet below land surface
 Artesian flow **N/A** G.P.M. **N/A** P.S.I.
 Water temperature _____ °F Quality _____

Date started **10-04**, 20 **07**
 Date completed **2-07**, 20 **08**

7. WELL TEST DATA

TEST METHOD: Bailer Pump Air Lift

G.P.M.	Draw Down (Feet Below Static)	Time (Hours)
150	No draw down into	24 hours

10. DRILLER'S CERTIFICATION
 This well was drilled under my supervision and the report is true to the best of my knowledge.

Name **WDC Exploration & Wells** Contractor
 Address **580 W. Silver St. Elko Nv. 89801** Contractor


Nevada contractor's license number issued by the State Contractor's Board **0012852**

Nevada driller's license number issued by the Division of Water Resources, the on-site driller **1616**

Signed **Paul Taylor**
 By driller performing actual drilling on site or contractor

Date **2/12/08**

BY JMD DATE 11/5/07 CLIENT _____ SHEET NO. 1 OF 1
 CHKD. BY _____ DATE _____ PROJECT NO. _____
 PROJECT UTTER Replacement Irrigation Well

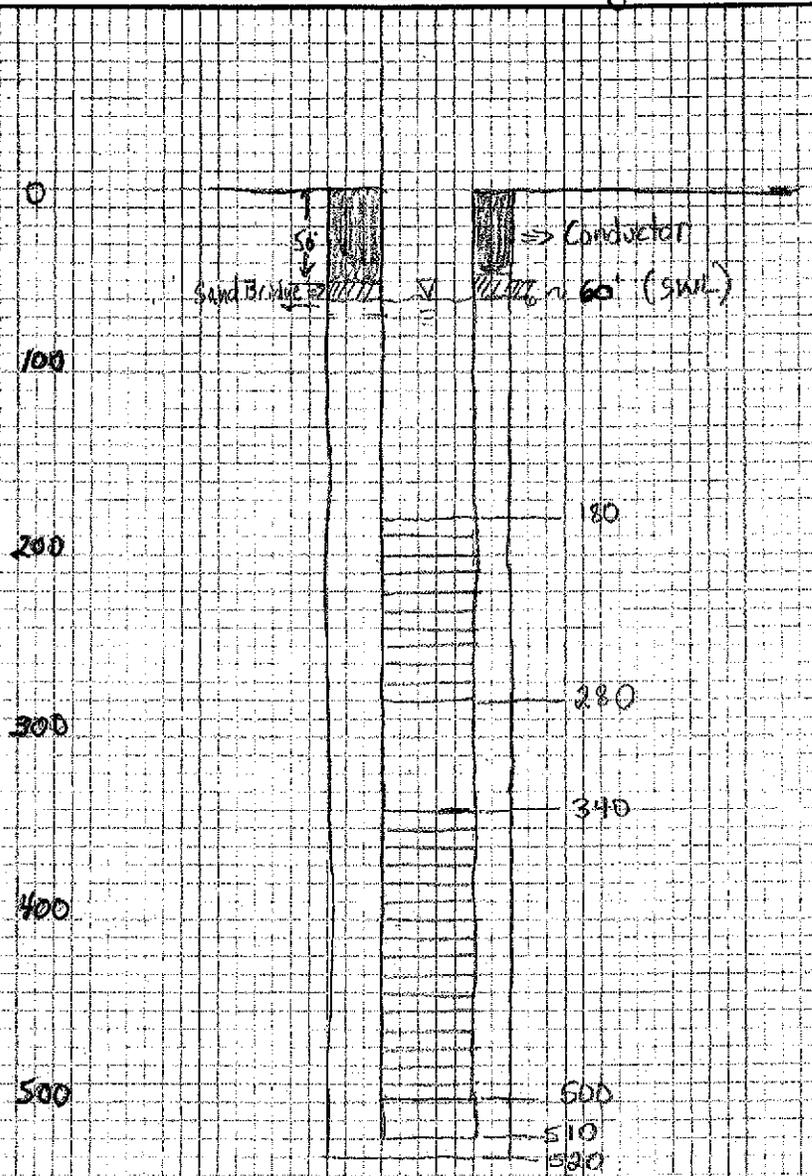

- Blank Casing: A53 Grade B Mild Steel, 16" Nominal Diam., 5/16" Thickness
- Slotted Casing: A53 Grade B Mild Steel, 16" Nominal Diam., 5/16" Thickness
 3/4" slot size = 0.75" x 2.5' to 30" (~~with slot~~) *covered*
- Gravel Pack: ~~Gravel~~ (SRT or Tena) **1/8 X 1/4 SRT**
- Blank Schedule: 0-180, 280-340, 500-510 = 250'
- Screen Schedule: 180-280, 340-500 = 260'

Log No. Utter Replacement

Log # 109808

Date of Drilling: 11/5/07
 Driller: WDC
 Logged By: Kati Gibler

Location: Lages Junction
 Borehole Diameter: 17.5"
 Groundwater Depth (ft):

Ground Surface Elevation (ft):
 Equipment:
 Driving Wt. and Drop:

DRAFTED BY KG

APPROVED BY ON

Depth (ft)	Graphic Log	SUMMARY OF SUBSURFACE CONDITIONS This log is part of the report prepared by Converse for this project and should be read with the report. This summary applies only at the location and time of the exploration. Subsurface conditions may differ at other locations and may change at this location with the passage of time. The data presented is a simplified model of the actual conditions encountered.	Samples						
			Drive	Bulk	Blow Count	% Gravel	% Sand	% Fines	Field or Lab Tests
0		(SM) SILTY SAND; light brown, dry with <5% pea size gravel. GRAVEL with SILT AND SAND; light brown, subrounded							
12		Not logged; conductor casing in place. Presumed composition is sand, silt, and clay							
48		(SC) SAND with SILT and CLAY; light brown, subangular							
72		(SM) SAND with SILT; light brown, small amount of gray coarse sand, subangular							
84		(SC) SAND with CLAY; coarse, subangular sand, light tan to whitish clay							
108		--- coarse to fine sand with clay							
120		--- light brown sand and white to tan clay with gravel							

Converse Sampler (white symbol=no recovery)

SPT Sampler (white symbol=no recovery)

EEC Project - Lages Station
 Lages Station (60 miles north of Ely)
 Nevada

Project No.
 06-33159-02



Over 60 Years of Dedication
 in Engineering and
 Environmental Sciences

Drawing No.

Log No. Utter Replacement

LOG# 109808

Date of Drilling: 11/5/07
 Driller: WDC
 Logged By: Kati Gibler

Location: Lages Junction
 Borehole Diameter: 17.5"
 Groundwater Depth (ft):

Ground Surface Elevation (ft):
 Equipment:
 Driving Wt. and Drop:

DRAFTED BY KG

APPROVED BY ON

SUMMARY OF SUBSURFACE CONDITIONS

This log is part of the report prepared by Converse for this project and should be read with the report. This summary applies only at the location and time of the exploration. Subsurface conditions may differ at other locations and may change at this location with the passage of time. The data presented is a simplified model of the actual conditions encountered.

Depth (ft)	Graphic Log	Samples						
		Drive	Bulk	Blow Count	% Gravel	% Sand	% Fines	Field or Lab Tests
132	(CL) CLAY with GRAVEL; tan to white clay with <10% gravel							
144	(sc) SANDY CLAY; brown soft, plastic							
156	(CL) CLAY with SAND; brown, soft							
168	(SC) SAND with CLAY AND GRAVEL; 45% light brown clay, 1 cm diameter, red subangular gravel							
180	(CH) CLAY with consolidated clumps; white to tan, 5% cm size clumps							
204	(GC) GRAVEL, SAND, CLAY; 85% gray, subangular, 0.5 to 1 cm, gravel with tan to white clay and sand --- 55% gravel							
216	(CL) CLAY with SAND; white to tan clay with medium grain size, gray, angular sand. --- 10% sand, light brown clay							

Converse Sampler (white symbol=no recovery)

SPT Sampler (white symbol=no recovery)

EEC Project - Lages Station
 Lages Station (60 miles north of Ely)
 Nevada

Project No.
 06-33159-02



Over 60 Years of Dedication
 in Engineering and
 Environmental Sciences

Drawing No.

Log No. Utter Replacement

LOG# 109808

Date of Drilling: 11/5/07
 Driller: WDC
 Logged By: Kati Gibler

Location: Lages Junction
 Borehole Diameter: 17.5"
 Groundwater Depth (ft):

Ground Surface Elevation (ft):
 Equipment:
 Driving Wt. and Drop:

DRAFTED BY: KG

APPROVED BY: ON

SUMMARY OF SUBSURFACE CONDITIONS

This log is part of the report prepared by Converse for this project and should be read with the report. This summary applies only at the location and time of the exploration. Subsurface conditions may differ at other locations and may change at this location with the passage of time. The data presented is a simplified model of the actual conditions encountered.

Depth (ft)	Graphic Log	Samples						
		Drive	Bulk	Blow Count	% Gravel	% Sand	% Fines	Field or Lab Tests
252								
264	(SC) SAND with CLAY and GRAVEL; 30% CLAY, 70% fine to coarse, light brown, subrounded sand with gravel							
276	(GC) GRAVEL with CLAY and SAND; 90% 2.5 cm to 0.5 cm, gray, red, angular to subangular gravel							
288	(CH) CLAY with SAND; light brown medium soft clay with <3% fine sand							
300	(CL) CLAY with SAND; coarse to fine, subangular sand							
312	(GC) GRAVEL with SAND AND CLAY; gray, red, angular to subangular gravel, tan clay, brown sand							
324	(SC) SANDY CLAY with GRAVEL; red sand and clay, 10% gravel --- 3 cm to 1 cm size cemented subrounded sand clasts -- less cemented sand clasts							
336	(GC) GRAVEL with CLAY; multi-colored, subangular to subrounded 2 cm to 0.5 cm size gravel and sand clasts --- <5% clay and 3 cm to coarse sand size, black and red, angular gravel --- well consolidated gravel with sand and minor clay							
348								
360								
372								

Converse Sampler (white symbol=no recovery)

SPT Sampler (white symbol=no recovery)

06-33159-02

EEC Project - Lages Station

Lages Station (60 miles north of Ely)
 Nevada

Project No.

06-33159-02



Over 60 Years of Dedication
 in Engineering and
 Environmental Sciences

Drawing No.

Log No. Utter Replacement

LOG# 109808

Date of Drilling: 11/5/07
 Driller: WDC
 Logged By: Kati Gibler

Location: Lages Junction
 Borehole Diameter: 17.5"
 Groundwater Depth (ft):

Ground Surface Elevation (ft):
 Equipment:
 Driving Wt. and Drop:

DRAFTED BY KG

APPROVED BY ON

SUMMARY OF SUBSURFACE CONDITIONS

This log is part of the report prepared by Converse for this project and should be read with the report. This summary applies only at the location and time of the exploration. Subsurface conditions may differ at other locations and may change at this location with the passage of time. The data presented is a simplified model of the actual conditions encountered.


Depth (ft)	Graphic Log	Samples						
		Drive	Bulk	Blow Count	% Gravel	% Sand	% Fines	Field or Lab Tests
384	(GP) GRAVEL with SAND;							
396	(GW) GRAVEL with SAND; 3 cm to medium sand size, angular black --- 2.5 cm to coarse sand size, subangular							
408	--- 4 cm to medium sand size, red, gray and black gravel							
420								
432	(SP) SAND and GRAVEL; 40% gravel and 60% coarse sand, black, red, gray, angular to subangular --- 80% coarse sand, 20% 1.5 to 0.5 cm size gravel							
444								
456	(SC) SANDY CLAY with GRAVEL; 20% 1 cm size, angular, black gravel							
468	(GC) GRAVEL, SAND, CLAY; 50% 1.5 cm to coarse sand size, black angular gravel, with 30 % tan sand and 20% light brown clay							
480	(SC) SAND with CLAY and GRAVEL; 60% brown sand, 20 % clay and 2.5 cm to coarse sand size, black and red gravel --- 75% sand, 10% 1.5 cm size gravel, 15% brown clay							
492	--- 70% sand, 10% gravel, 20% clay							

Converse Sampler (white symbol=no recovery)

SPT Sampler (white symbol=no recovery)

EEC Project - Lages Station
 Lages Station (60 miles north of Ely)
 Nevada

Project No.
 06-33159-02

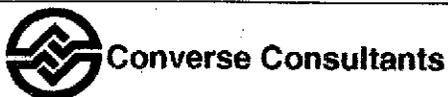

Over 60 Years of Dedication
 in Engineering and
 Environmental Sciences

Drawing No.

Log No. Utter Replacement

LOG # 109808

Date of Drilling: 11/5/07
 Driller: WDC
 Logged By: Kati Gibler

Location: Lages Junction
 Borehole Diameter: 17.5"
 Groundwater Depth (ft):

Ground Surface Elevation (ft):
 Equipment:
 Driving Wt. and Drop:

DRAFTED BY KG

APPROVED BY ON

SUMMARY OF SUBSURFACE CONDITIONS

This log is part of the report prepared by Converse for this project and should be read with the report. This summary applies only at the location and time of the exploration. Subsurface conditions may differ at other locations and may change at this location with the passage of time. The data presented is a simplified model of the actual conditions encountered.

Samples

Depth (ft)	Graphic Log	Samples						
		Drive	Bulk	Blow Count	% Gravel	% Sand	% Fines	Field or Lab Tests
504								
516	End of Boring							
528								
540								
552								
564								
576								
588								
600								
612								
624								

End of Exploration at 507.0'

Converse Sampler (white symbol: no recovery)

SPT Sampler (white symbol: no recovery)

EEC Project - Lages Station
 Lages Station (60 miles north of Ely)
 Nevada

Project No.
 06-33159-02



Over 60 Years of Dedication
 in Engineering and
 Environmental Sciences

Drawing No.

Symbol Description

LOG# 109808

Strata symbols



Silty Sand



Gravelly Lean Clay



Fill



Clayey Sand



Lean Clay



Fat Clay



PG Gravel



WG Gravel



PG Sand

Notes:

1. Exploratory borings were drilled on 11/5/07 using a 4-inch diameter continuous flight power auger.
2. No free water was encountered at the time of drilling or when re-checked the following day.
3. Boring locations were established with hand-held GPS units.
4. These logs are subject to the limitations, conclusions, and recommendations in this report.
5. Results of tests conducted on samples recovered are reported on the logs.