


Log # 116072

	Date Completed: 9/17/2012	UTM (NAD 27):	
	Collar Elevation: 4868' AMSL	65720 N	114769 E
	Total Depth: 150'	SW 1/4, NE 1/4, Sec 28, T28N, R47E	
	Static Water Level: 52'	Permits: NEV0093109, NOI: No. 69225	
Hole ID: SMA-17	Contractor: Boart Longyear	Field Geologist: Nicholas Atiemo	
Location: Cortez	Driller: # 2339	Asbuilt by: Brad Kassing	

Elevation (ft AMSL)	Depth (ft BGS)
------------------------	-------------------

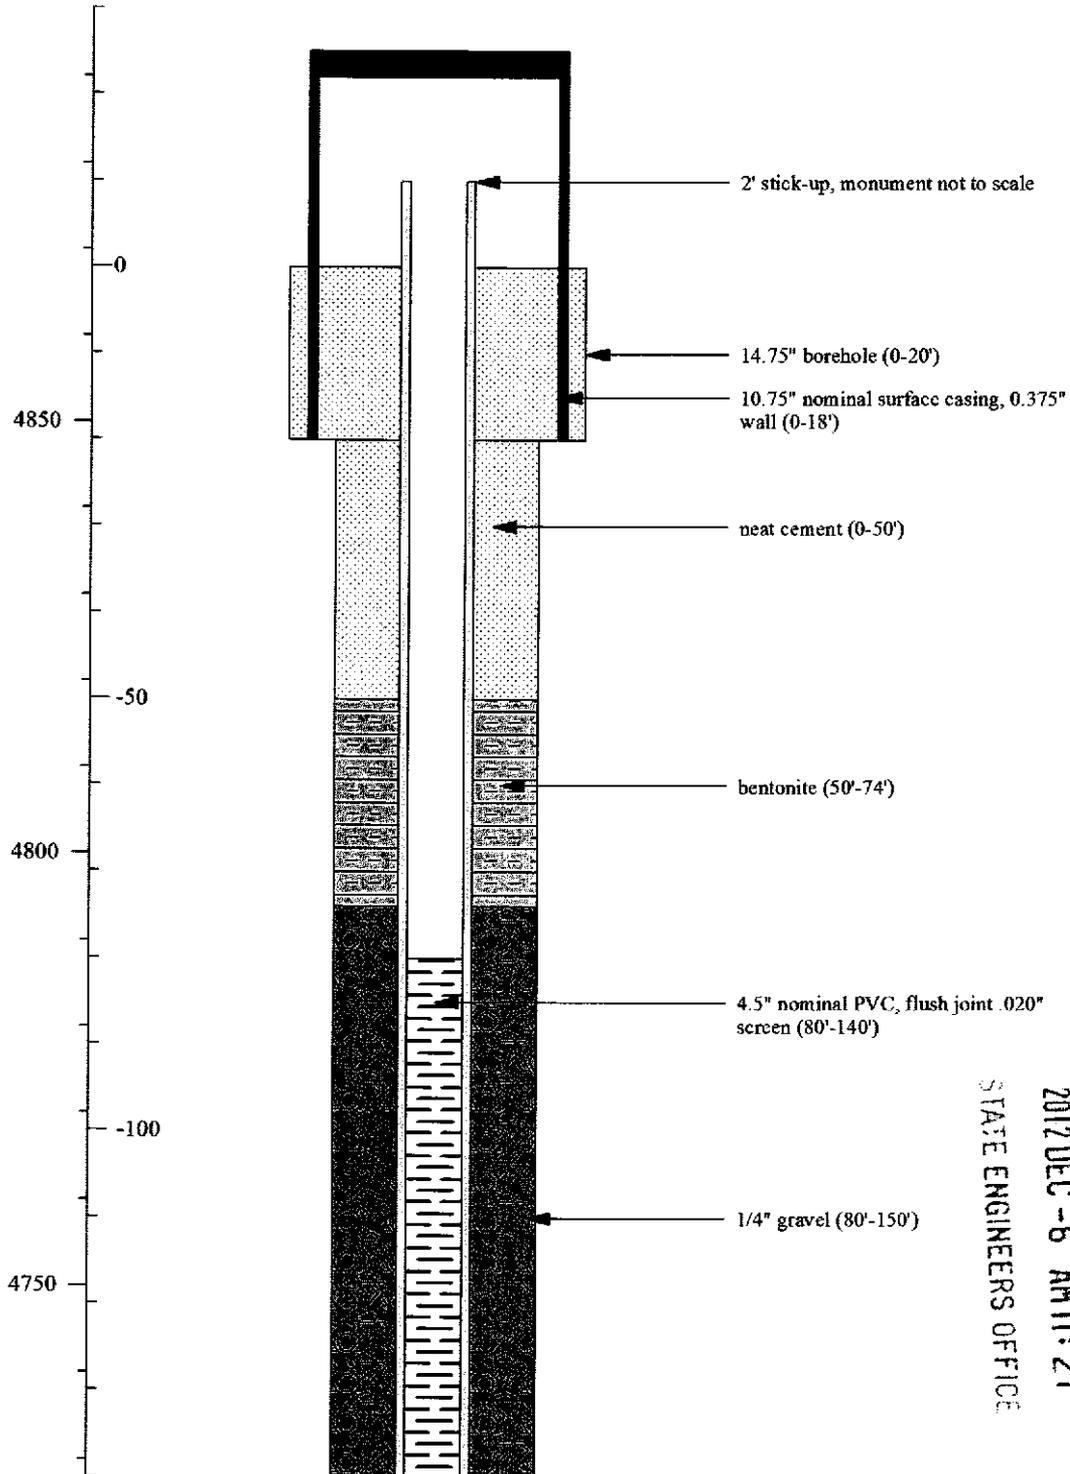

RECEIVED
 2012 DEC -6 AM 11: 21
 STATE ENGINEERS OFFICE