

STATE OF NEVADA  
DIVISION OF WATER RESOURCES  
WELL DRILLER'S PLUGGING REPORT

OFFICE USE ONLY

Log No. 106182  
Permit No. \_\_\_\_\_  
Basin 887 pg1

PRINT OR TYPE ONLY  
DO NOT WRITE ON BACK

Please complete this form in its entirety in  
accordance with NRS 534.170 and NAC 534.340

NOTICE OF INTENT NO. 60560

1 OWNER Washoe Co. School District  
MAILING ADDRESS 7495 South Virginia Street  
RENO NV

ADDRESS AT WELL LOCATION 1850 Kleppe Lane  
SPARKS NV  
Subdivision Name: \_\_\_\_\_ County: Washoe

2 LOCATION NE 1/4 SW 1/4 Sec 11 T 19 N R 20 E  
PERMIT/WAIVER No. 4-000484 | 034-164-02  
Issued by Water Resources Parcel No.

Latitude N 39° 31.508' UTM E  NAD 27  
Longitude W 119° 42.475' N  NAD 83 WGS 84

3 TYPE OF WELL  
 Domestic  Irrigation  Test  
 Municipal/Industrial  Monitor RW 1  Stock

Is this well being plugged because a replacement well was drilled? NO  
If yes, what is replacement well NOI? \_\_\_\_\_

Is there an existing well log? \_\_\_\_\_  
If yes, what is NDWR well log #? \_\_\_\_\_

4 EXISTING WELL CONSTRUCTION  
Depth Drilled 30 Feet Depth Cased 30 Feet

EXISTING CASING SCHEDULE				
Size O.D. (Inches)	Weight/Ft. (Pounds)	Wall Thickness (Inches)	From (Feet)	To (Feet)
<u>6 3/4"</u>		<u>sch 40</u>	<u>0</u>	<u>30</u>

Existing Perforations:  
Type of perforation slotted  
Size of perforation 0.020  
From 5 feet to 30 feet  
From \_\_\_\_\_ feet to \_\_\_\_\_ feet

5 WATER LEVEL  
Static water level 9' feet below land surface  
Artesian flow NO G.P.M. - P.S.I.  
Water temperature WARM °F Quality MURKY

6 Additional Notes or Comments

N 39.525242  
W 119.706914 NAD27

STATE ENGINEERS OFFICE  
44-1114-44  
2008 JUN 27 AM 11:44

7 WELL PLUGGING PROCEDURE  
Was well cleaned out to total depth?  yes  no  
If well was not cleaned out to total depth, please explain why: \_\_\_\_\_

Was the well contaminated?  yes  no  
Was the casing pulled?  yes  no  
Was the casing over drilled?  yes  no

If casing was left in place, please show where additional perforations were made:  
Additional Perforations:  
Type of perforator used:  
From \_\_\_\_\_ feet to \_\_\_\_\_ feet Number of perfs per linear foot \_\_\_\_\_  
From \_\_\_\_\_ feet to \_\_\_\_\_ feet Number of perfs per linear foot \_\_\_\_\_  
8 WELL PLUGGING MATERIALS

Material Used			
From <u>30</u> feet to <u>1</u> feet	<u>Neat cement</u>	<input checked="" type="checkbox"/> Pumped	<input type="checkbox"/> Poured
From <u>1</u> feet to <u>0</u> feet	<u>concrete</u>	<input type="checkbox"/> Pumped	<input checked="" type="checkbox"/> Poured
From _____ feet to _____ feet		<input type="checkbox"/> Pumped	<input type="checkbox"/> Poured
From _____ feet to _____ feet		<input type="checkbox"/> Pumped	<input type="checkbox"/> Poured
From _____ feet to _____ feet		<input type="checkbox"/> Pumped	<input type="checkbox"/> Poured
From _____ feet to _____ feet		<input type="checkbox"/> Pumped	<input type="checkbox"/> Poured

Neat Cement Fluid Weight \_\_\_\_\_ lbs/gal  
Bentonite Grout \_\_\_\_\_ % bentonite

Date Started 6/17/08  
Date Completed 6/17/08

9 DRILLER'S CERTIFICATION

This well was plugged and abandoned under my supervision and the report is true to the best of my knowledge.

Name DALE LEHMAN  
Contractor


Address 520 Edison Way  
RENO NV 89502  
Contractor

Nevada contractor's license number issued by the State Contractor's Board 0062596 RSI Drilling

Nevada driller's license number issued by the Division of Water Resources, the on-site driller M-1976

Signed Dale Lehman  
By driller performing actual drilling on site or contractor

Date 6/19/08

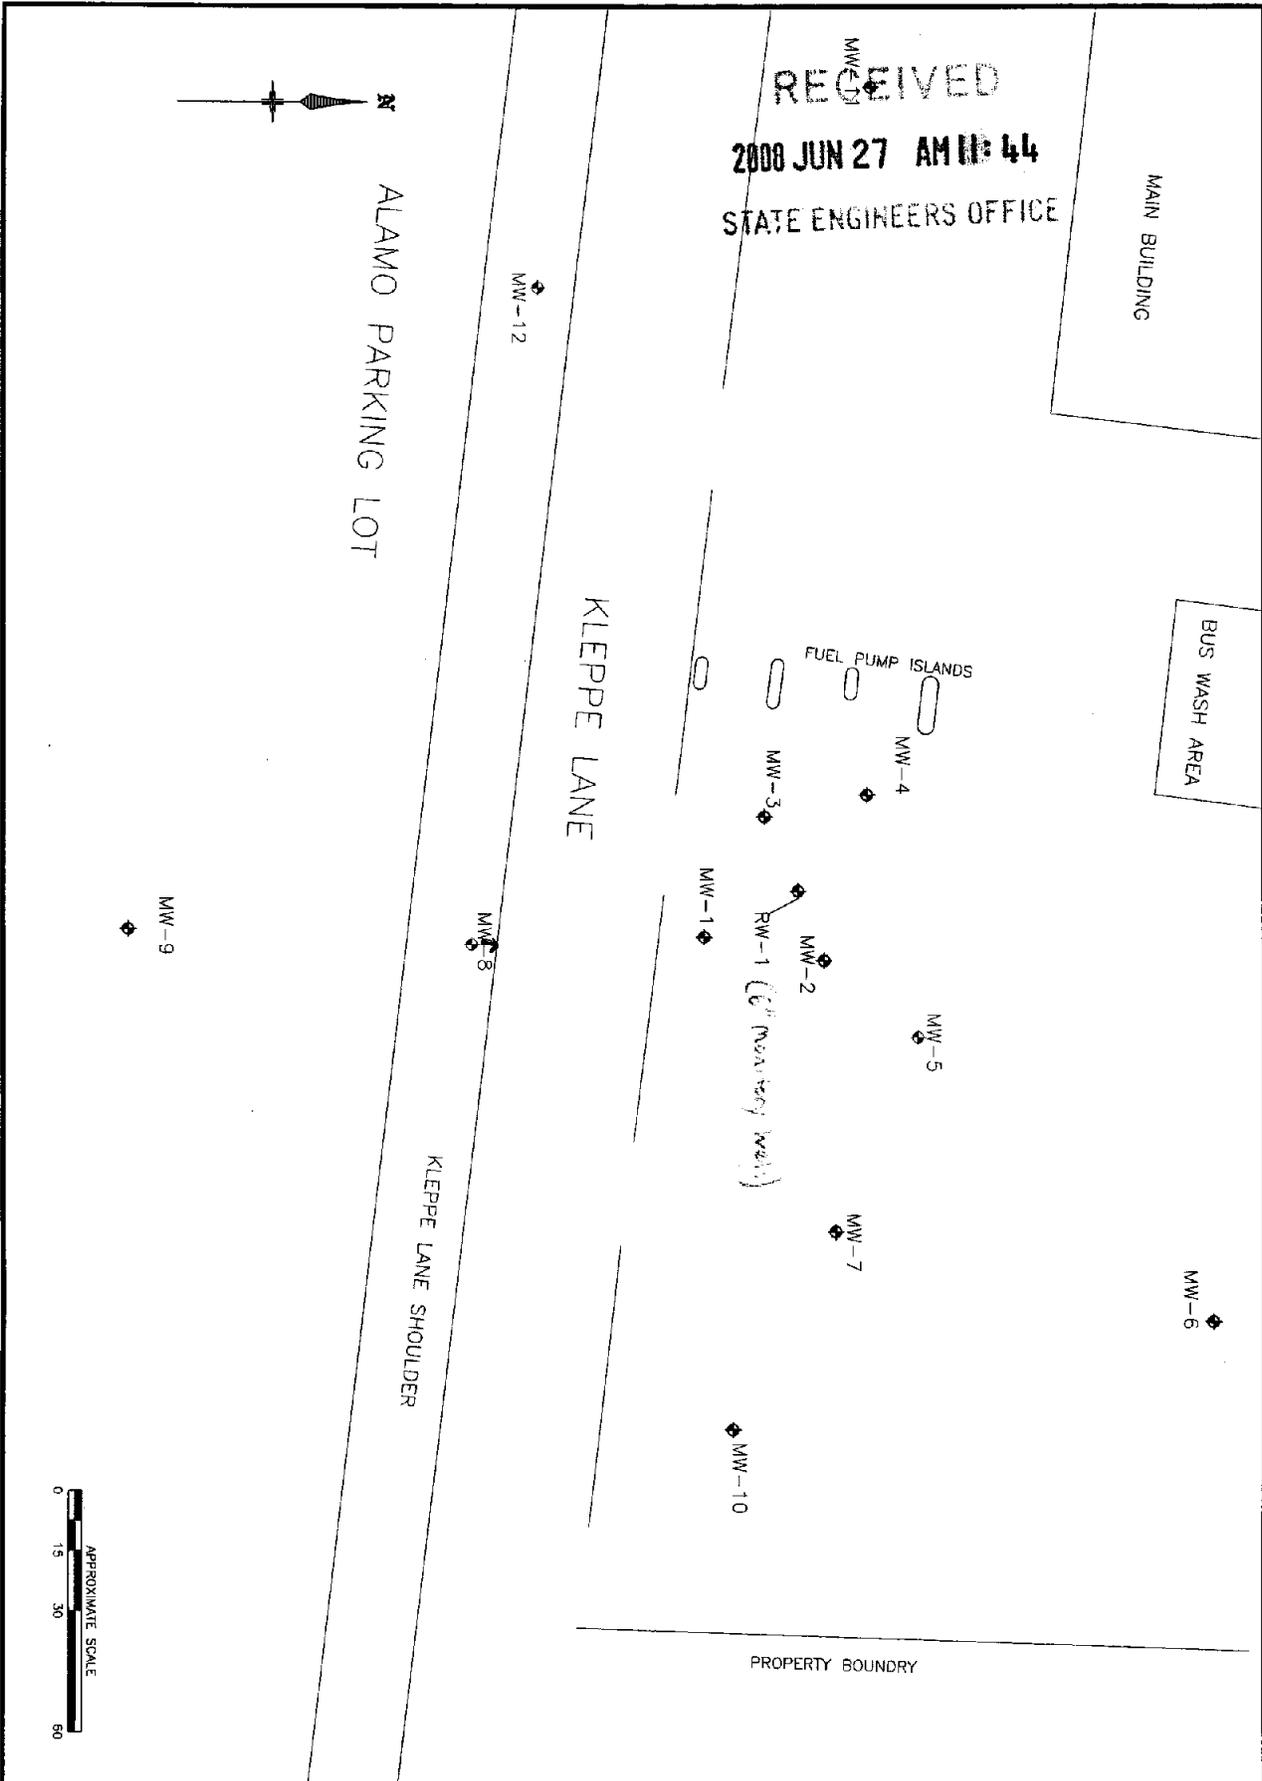

RECEIVED  
2000 JUN 27 AM 11:44  
STATE ENGINEERS OFFICE

DESIGNED BY	CHKD BY
DRAWN BY	DATE
DATE	FILE

SCALE:  
AS SHOWN

**BROADBENT & ASSOCIATES, INC.**  
ENGINEERING, WATER RESOURCES & ENVIRONMENTAL  
2000 Kirman Avenue  
Reno, Nevada 89502

WCSO Getto Transportation Facility  
1850 Kleppe Lane  
Sparks, Nevada

Drawing #1  
Water Level Information