


MW-1

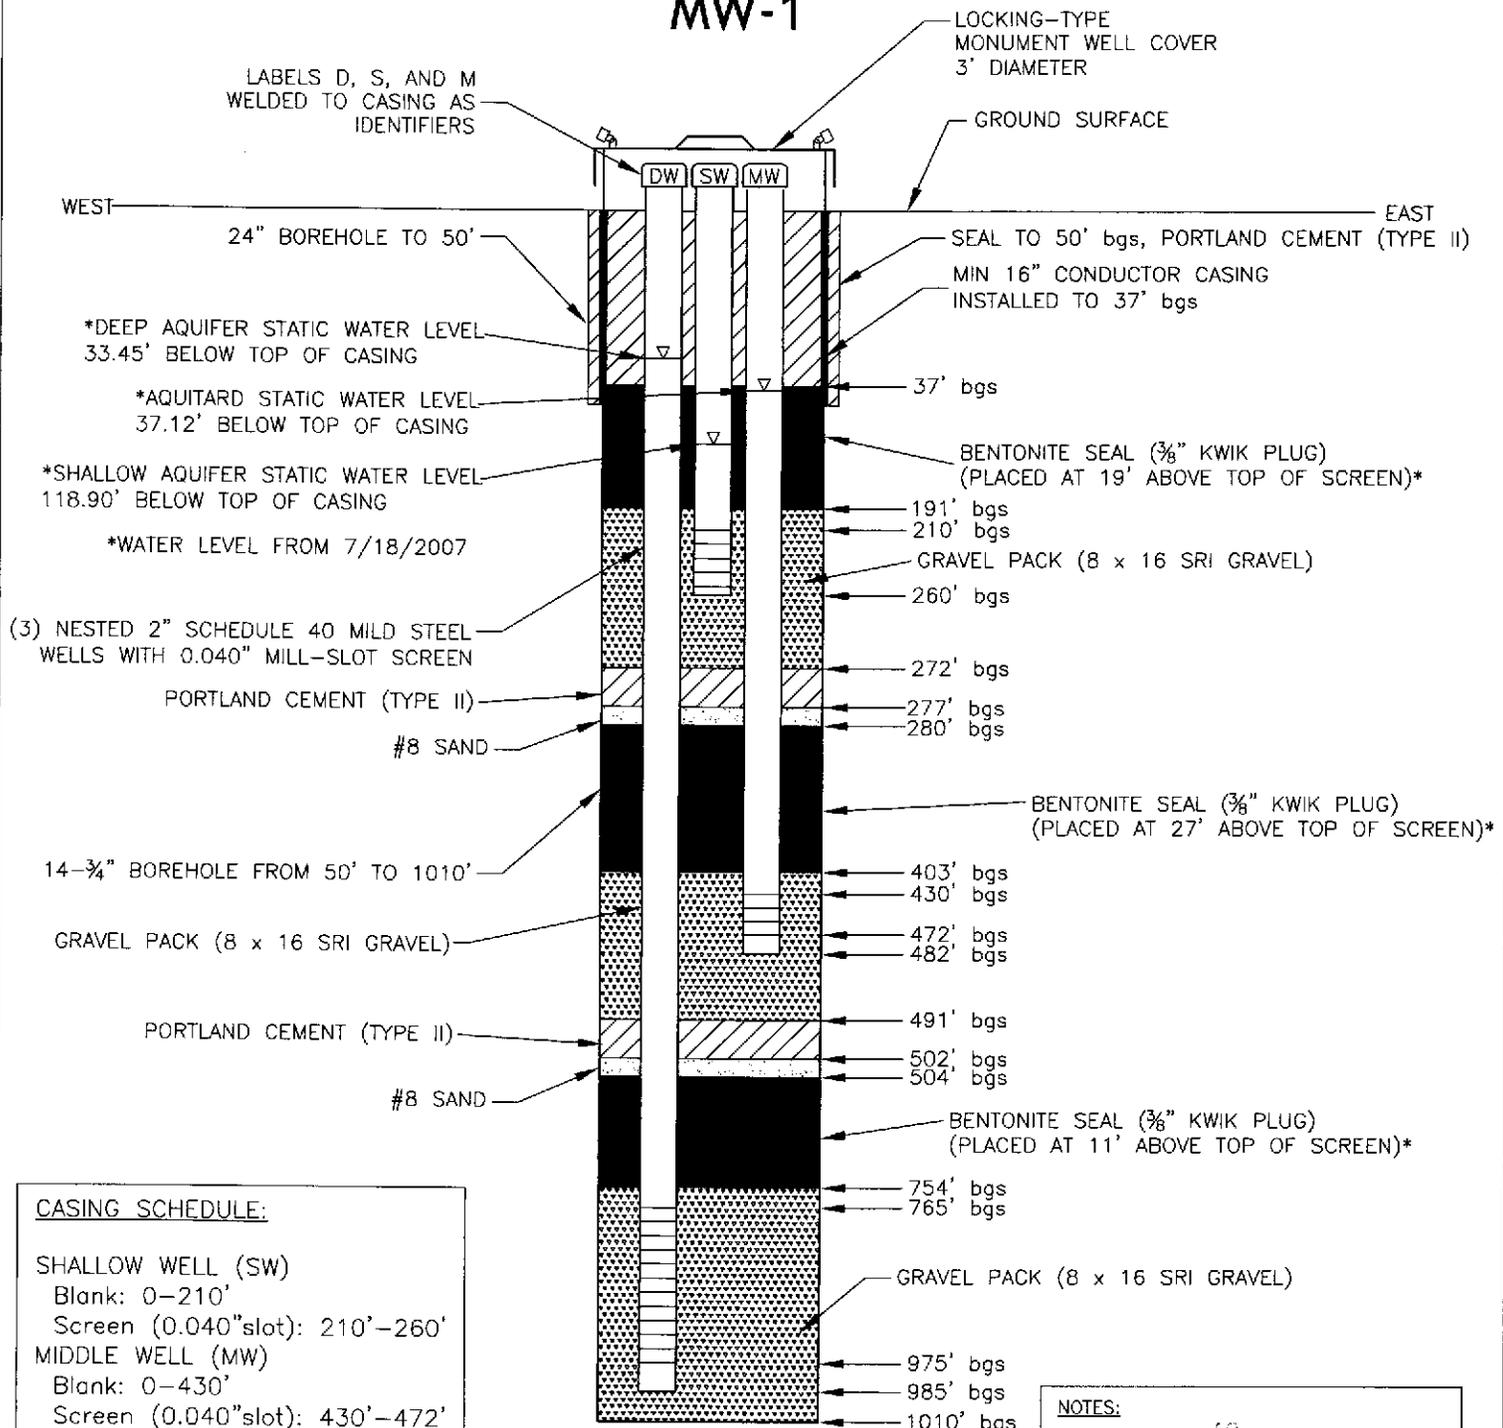

CASING SCHEDULE:

SHALLOW WELL (SW)	
Blank:	0-210'
Screen (0.040" slot):	210'-260'
MIDDLE WELL (MW)	
Blank:	0-430'
Screen (0.040" slot):	430'-472'
Blank:	472'-482'
DEEP WELL (DW)	
Blank:	0-765'
Screen (0.040" slot):	765'-975'
Blank:	975'-985'

NOTES:

6" CENTRALIZERS PLACED EVERY 60' FOR:
 SW FROM 0-260' ft-bgs.
 MW FROM 260-482' ft-bgs.
 DW FROM 482-985' ft-bgs.

*UNABLE TO MEASURE AMOUNT OF SETTLEMENT OF BENTONITE SEAL

MULTI-LEVEL MONITORING WELL (AS BUILT)

ELY ENERGY CENTER
 Lages Station
 White Pine County, Nevada

Scale	N.F.S.	Sheet No.	FIG-1 As Built
Date	07/27/07	Project No.	06-33159-02
Drafted By	GRD	Figure No.	
Checked By	JMD		
Approved By			



Over 60 Years of Dedication
 in Engineering and
 Environmental Sciences