Section	Subdivision	TN	RE	Acreage	Kind of Culture	Date of First Culture
35	SE¼ of NE¼	42	54	5.23	Grass & Sage	
"	NE¼ of SE¼	"	"	29.25	" " "	
"	NW¼ of SE¼	"	"	14.60	" " "	
"	SW¼ of SE¼	"	"	23.50	" " "	
"	SE¼ of SE¼	"	"	12.00	" " "	
2	NE¼ of NE¼	41	"	2.19	" " "	
"	NW¼ of NE¼	"	"	17.42	" " "	
"	NE¼ of NW¼	"	"	0.78	" " "	
"	SW¼ of NW¼	"	"	5.01	" " "	
"	SE¼ of NW¼	"	"	11.75	" " "	
"	SW¼ of ~~NW¼~~ NE¼	"	"	1.54	" " "	

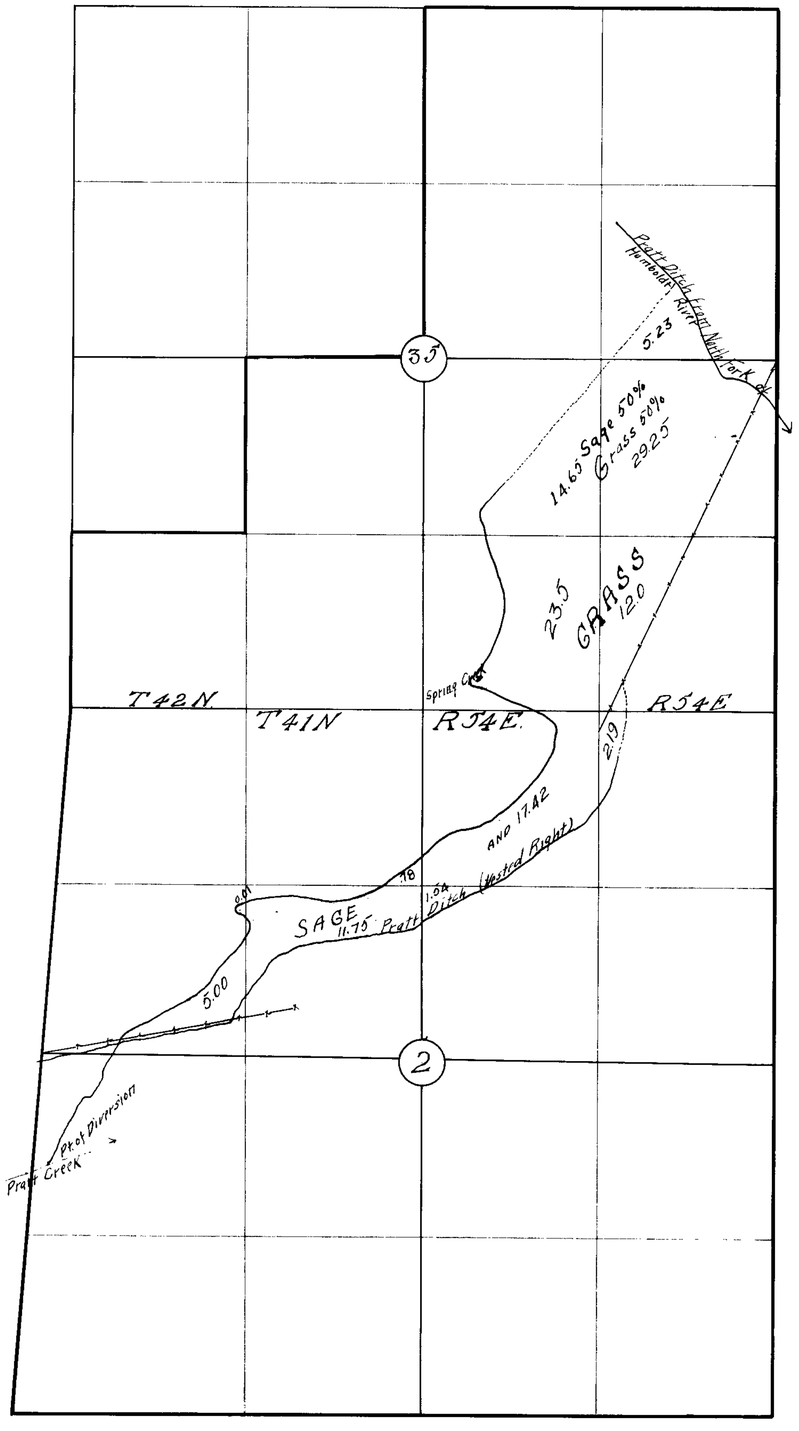

W.H. Settelmeyer
George Pratt

George Pratt
George Pratt
~~W.H. Settelmeyer~~
State Water Right Surveyor
Oct 22
Kaylen Henderson.

741 4-19-23.

FILED
Oct. 16, 1922.
STATE ENGINEER

CULTURAL MAP
OF LANDS OF
GEORGE PRATT
WATER SOURCE: PRATT CREEK
WATER SYSTEM: HUMBOLDT RIVER
NORTH FORK, NEVADA
Surveyed by W.H. Settelmeyer
Scale 1" = 600'

Permit #1732

1732