Section	Subdivision	Township	Range	Cultivated Acreage	Description of Culture	Date of first Culture
15	NE¼ SW¼	42 N.	62 E	0.86	Meadow	
✓	✓	✓	✓	2.23	Timothy	
✓	✓	✓	✓	6.03	Grain Land ~~Land Plowed~~	
✓	NW¼ SE¼	✓	✓	13.17	Grain Land	
✓	✓	✓	✓	3.42	Timothy	
✓	✓	✓	✓	3.26	Pasture ~~Cleared Land~~	
✓	NE¼ SE¼	✓	✓	0.90	Pasture	
✓	✓	✓	✓	1.84	Grain Land ~~Plowed Land~~	
✓	SE¼ NE¼	✓	✓	6.18	Grain Land	
✓	✓	✓	✓	5.89	Pasture ~~Cleared Land~~	
✓	✓	✓	✓	8.83	Timothy	

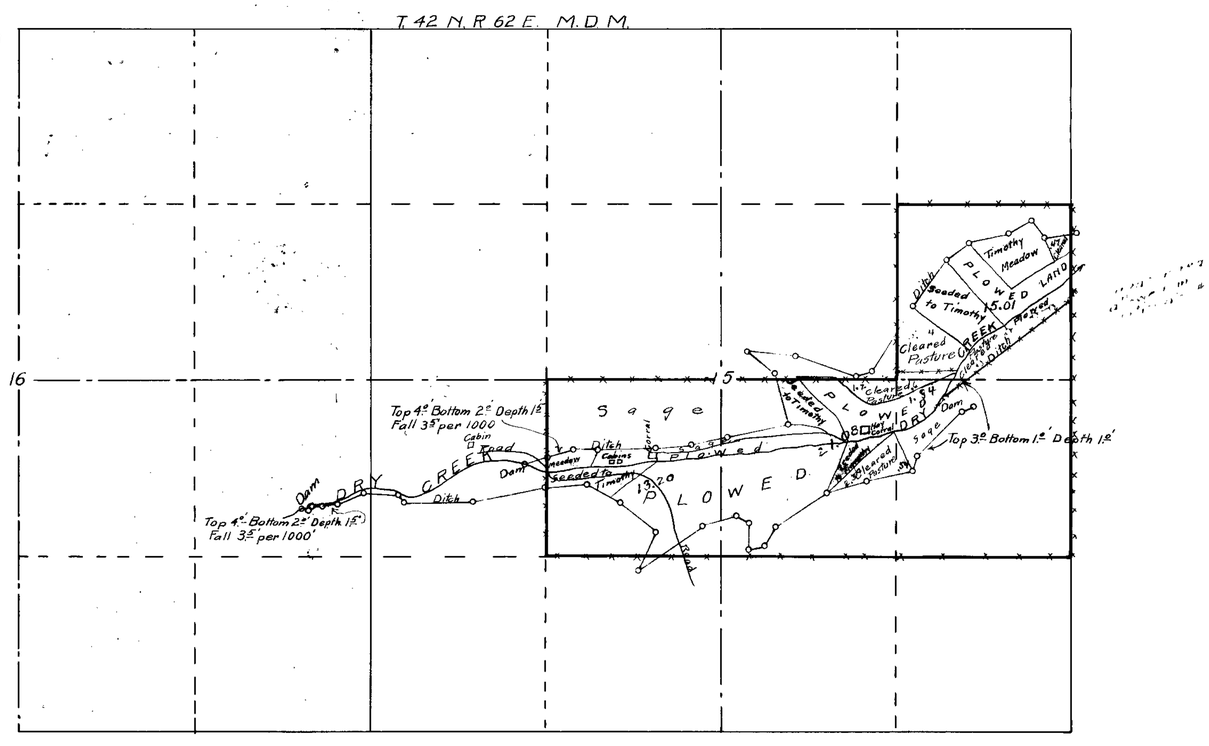

STATE OF NEVADA }
COUNTY OF ELKO } SS.

I, J.L. Vandiver, being first duly sworn, depose and say that the above map is a true and accurate plat of the lands irrigated by Herbert L. Butler, as taken from the field notes of a survey made by me completed on the 28th day of September 1920.

That the map and survey were made at the instance of Herbert L. Butler owner of said lands, and that it truly represents the irrigated lands of said Herbert L. Butler

J.L. Vandiver

Subscribed and sworn to before me this 30th day of September 1920.

Paul S. Trifelett

Notary Public in and for Elko County Nevada.

HERBERT L. BUTLER

WELLS, NEVADA.

APPLICATION OF WATER TO BENEFICIAL USE

APPLICATION NO. 2190.

DRY CREEK.

Sept. 30th 1920 Scale 1"=600'. J.L. Vandiver, Surveyor.

Nov. 3, 1920.

524 BK4 3-7-21
for 6162 c.f.s.

2190