Sec	Subdivision	T. N.	R. E.	Acreage	Culture	Date of First Culture
24	~~NW¼ of NE¼~~	~~33~~	~~57~~	~~1.0~~	~~Grain~~	Exclude.
"	NE¼ " NW¼	"	"	39.0	"	
"	NW¼ " NW¼	"	"	38.0	"	
"	SW¼ " NW¼	"	"	29.75	"	
"	" " "	"	"	10.25	Rye	
"	SE¼ " NW¼	"	"	38.00	Grain	
"	~~SW¼ " NE¼~~	~~"~~	~~"~~	~~1.20~~	~~"~~	Exclude.
"	~~NW¼ " SE¼~~	~~"~~	~~"~~	~~2.00~~	~~"~~	Exclude
"	NE¼ " SW¼	"	"	31.50	"	
"	NE¼ " SW¼	"	"	8.50	Alfalfa	
"	NW¼ " SW¼	"	"	6.25	"	
"	" " "	"	"	8.75	Grain	
"	" " "	"	"	19.10	Rye	
"	" " "	"	"	4.10	Ploughed Ground	
"	SW¼ " SW¼	"	"	32.0	" "	
"	" " "	"	"	1.50	Potatoes	
"	" " "	"	"	2.25	Grain	
"	SE¼ " SW¼	"	"	0.80	Plowed Ground	
"	" " "	"	"	35.50	Alfalfa	
"	SW¼ " SE¼	"	"	3.00	Alfalfa	
"	NE¼ of NW¼	"	"	8.25	Grain	Excluded

Total for proof 300.00 Acres.

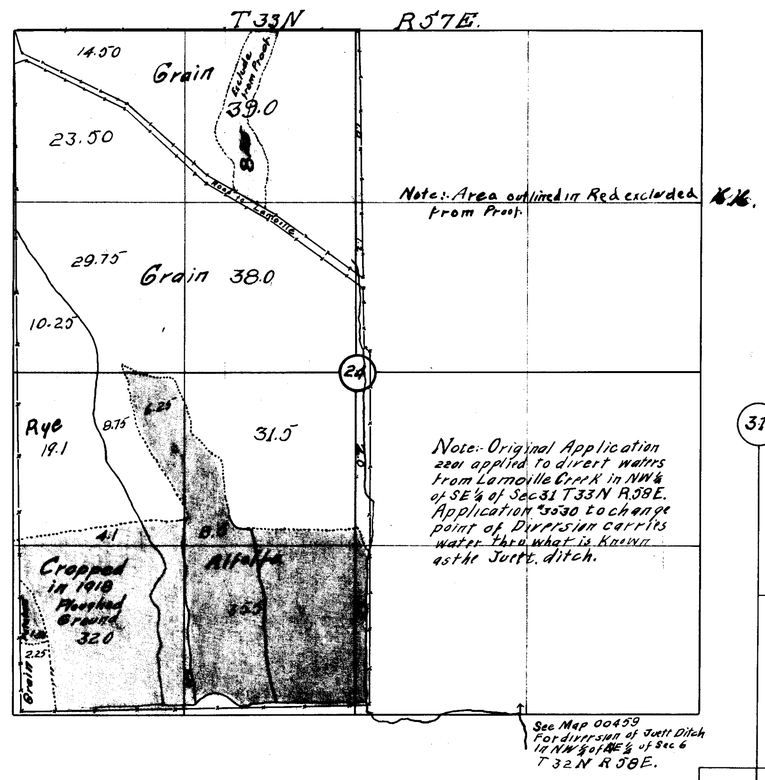

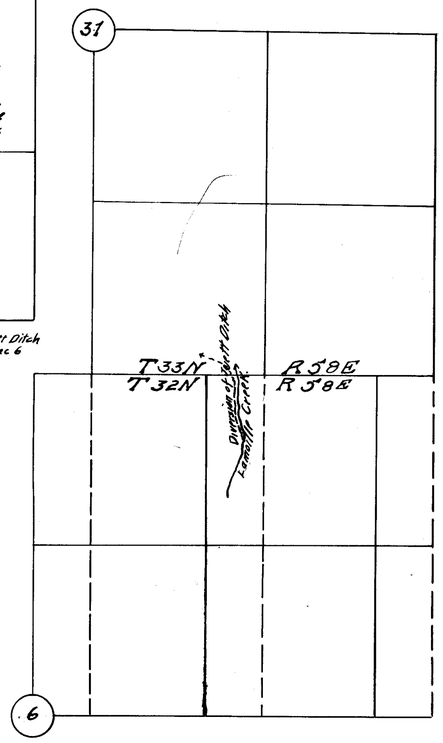

NOTE:- Original diversion of Juett ditch is shown in NW¼ of NE¼ of Section 6 T32N, R58E. T32N at time of first survey of Juett ditch was unsurveyed and has since been surveyed. Using the New Survey Corners, the diversion is in the NE¼ of NE¼ of Section 6, T32N, R58E.

Dotted lines in Section 6 are extensions of section lines from Section 31, T33N, R58E. and are shown to give relative positions of old and new surveys.

W.H. Settelmeyer
Jas. E. Fraiser
Day September 21 30th
Jas. E. Fraiser
Jas. E. Fraiser
W.H. Settelmeyer
Subscribed and sworn to before me, this 24th day of Oct. 21
Hayden Manderson
Notary Public

FILED
Aug. 4, 1922
STATE ENGINEER'S OFFICE

5/10/22

CULTURAL MAP
OF LANDS OF
JAS. E. FRAISER

WATER SOURCE:- LAMOILLE CRK.

WATER SYSTEM:- Humboldt River.

LAMOILLE, ELKO CO., NEV.

Certificate No. 656 BK. 4 issued 8-30-22. for 3.0 c.f.s.

Scale 1" = 600'

(S)

Permit 2201 + Permit #3530

10/27/21

75296 3530