Section	Subdivision	Township	Range	Cultivated Acreage	Description of Culture
13	S.E.¼ of N.E.¼	43 N.	54 E.	39.4	Pasture
"	N.E.¼ of S.E.¼	"	"	35.0	"
"	" "	"	"	4.8	Meadow
"	S.E.¼ of S.E.¼	"	"	10.3	Pasture
"	N.W.¼ of S.E.¼	"	"	40.0	"
"	S.W.¼ of S.E.¼	"	"	29.1	"
"	S.E.¼ of S.W.¼	"	"	32.3	"
"	" "	"	"	3.5	Meadow.
"	S.W.¼ of S.W.¼	"	"	5.2	"
"	" "	"	"	34.8	Pasture
14	S.E.¼ of S.E.¼	"	"	35.4	"
"	" "	"	"	4.6	Meadow
			Total	274.4	

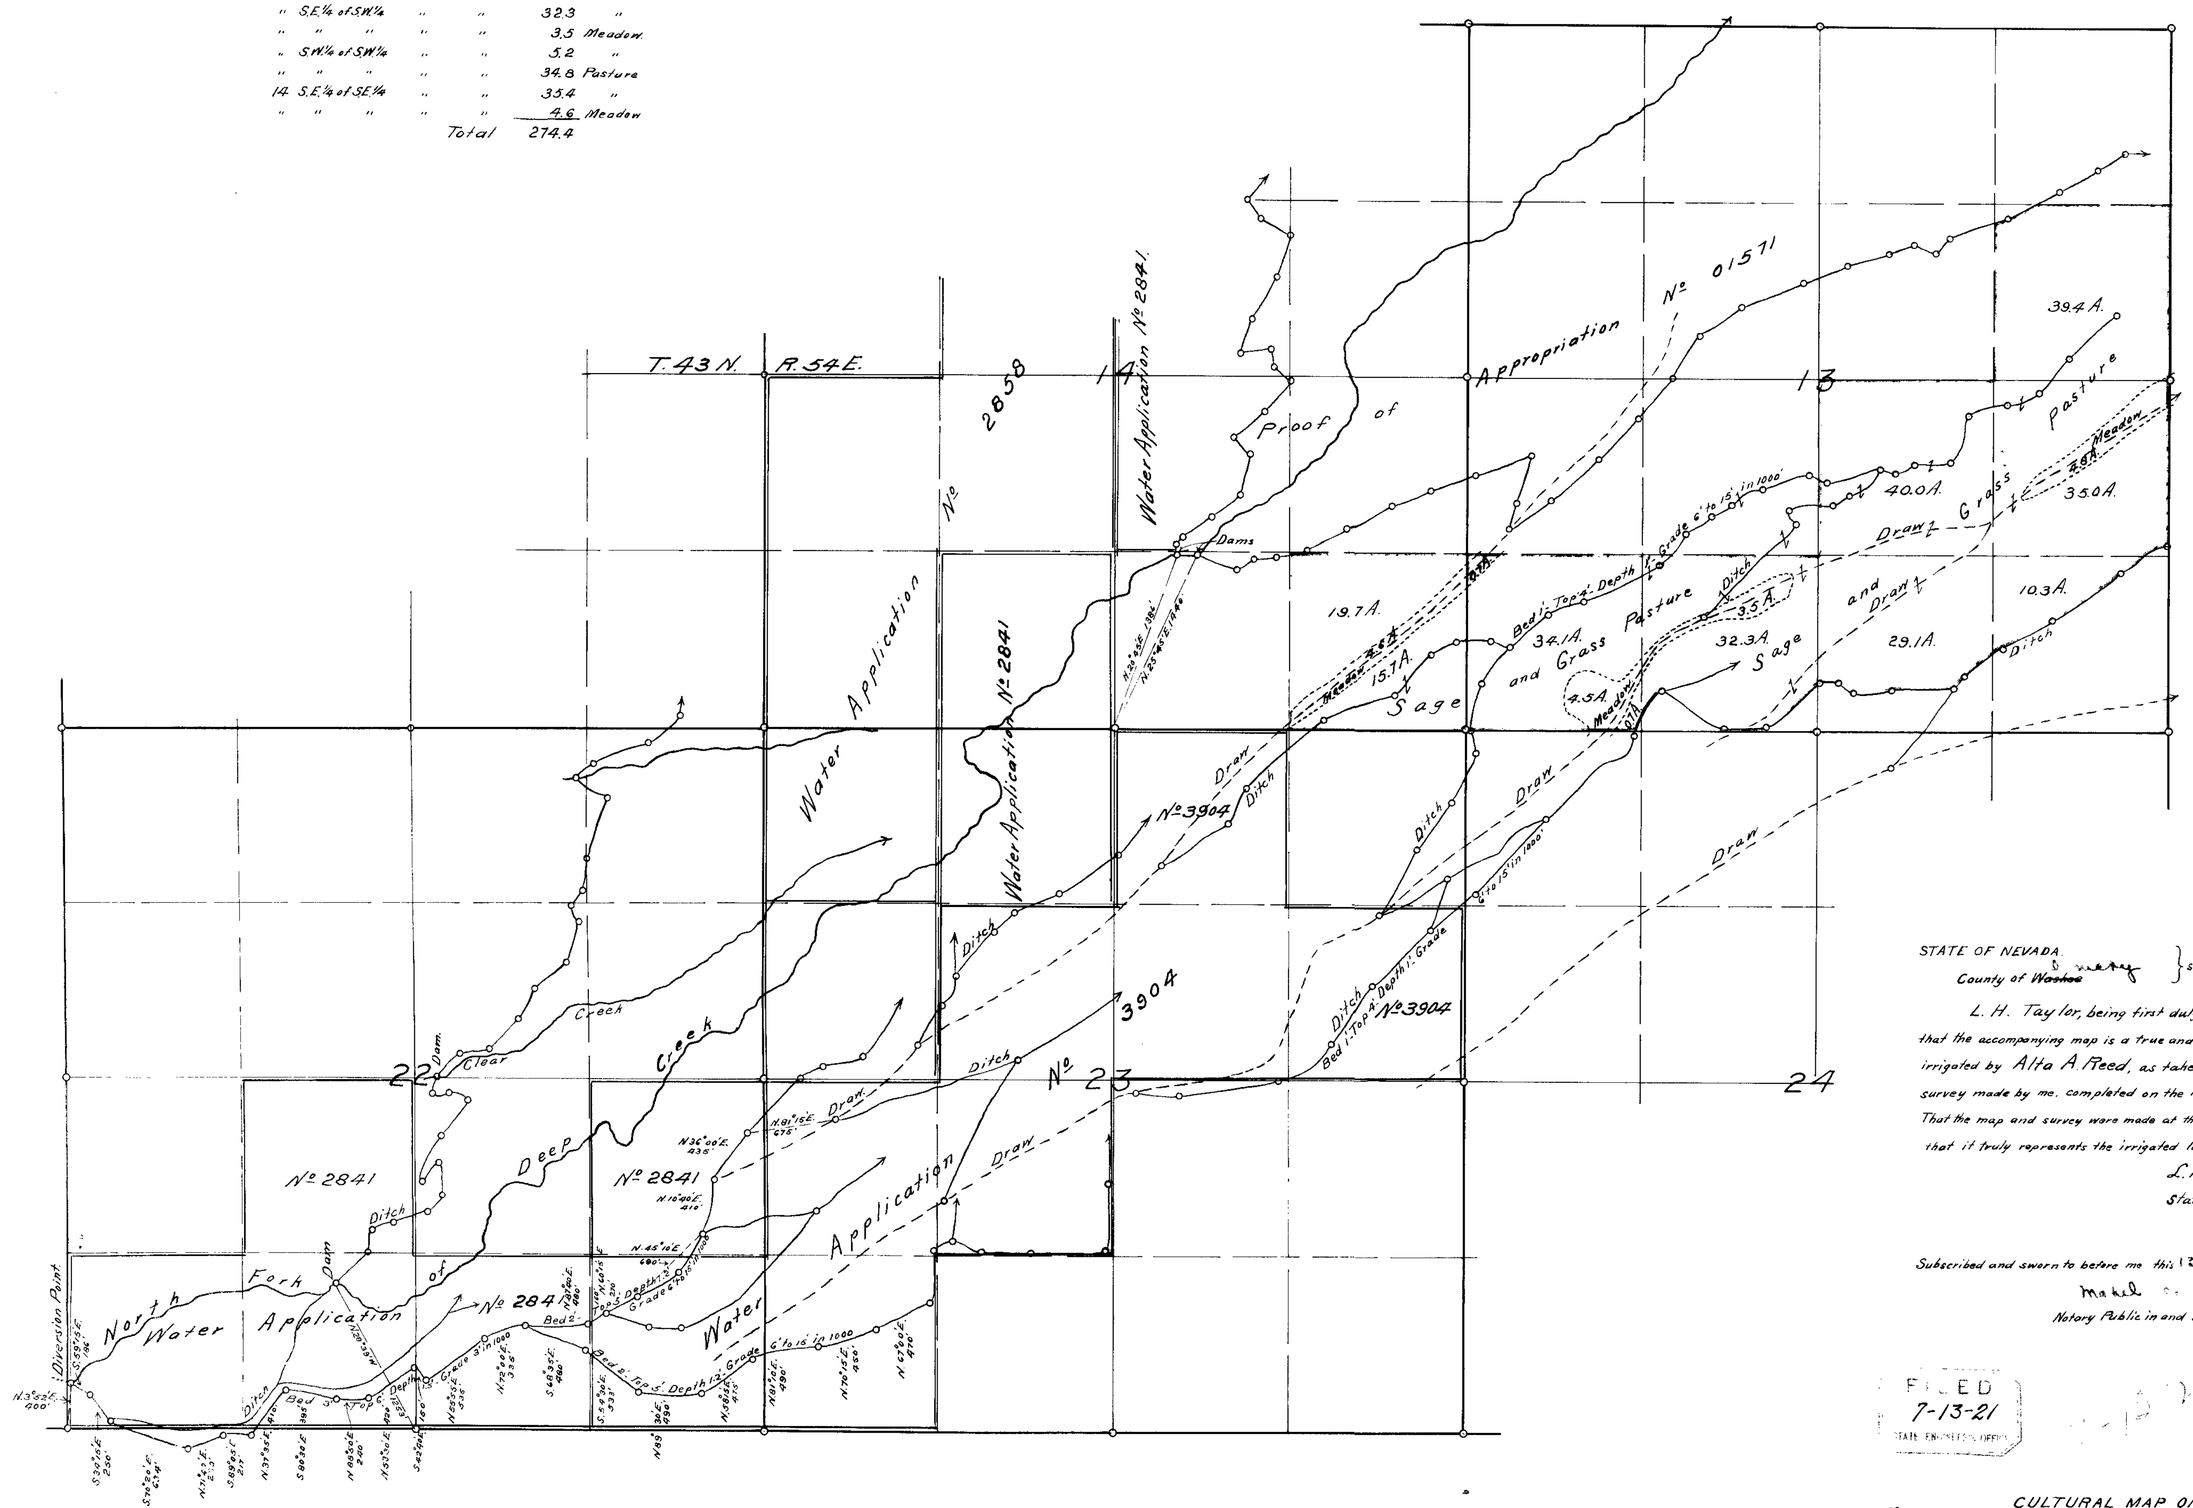

STATE OF NEVADA.

L. H. Taylor, being first duly sworn, deposes and says that the accompanying map is a true and accurate plat of the land irrigated by Alta A. Reed, as taken from the field notes of a survey made by me, completed on the 19th. day of June, 1921. That the map and survey were made at the instance of Alta A. Reed, and that it truly represents the irrigated lands of said Alta A. Reed.

L. H. Taylor,
State Water Right Surveyor.

Subscribed and sworn to before me this 13th day of July, 1921

Notary Public in and for ~~Washoe~~ County, Nevada.

FILED
7-13-21
STATE ENGINEER'S OFFICE

1864 Aug. 22, 1922

CULTURAL MAP OF LANDS OF
Alta A. Reed
No. 3905.

Water Source North Fork of Deep Creek
Tributary of Owyhee River
County of Elko.
Scale 1" = 600'

3905