Township No. 10 S. Range No. 46 MT. DIABLO Meridian

Sec.	Sub Division	Township	Range			
13	NE¼ SW¼	10	46			

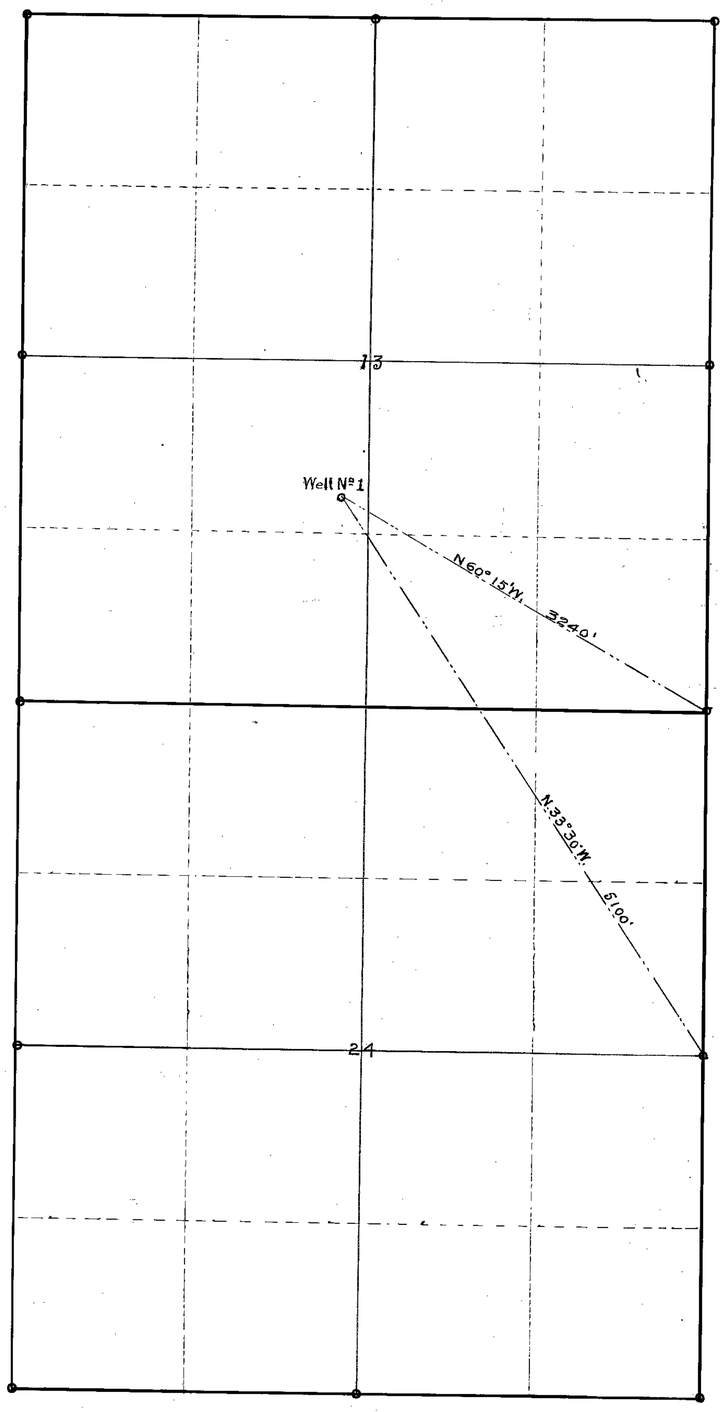

Scale 1 inch = 600 Feet.

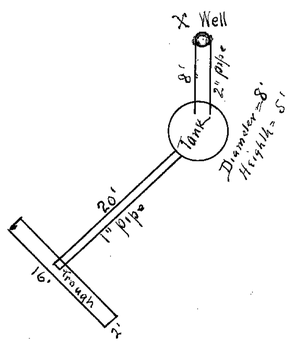

Detail Drawing Showing Diversion of Water at X Well

Scale 1" = 10'

Application No. ~~6681~~ 6725

J.J. Vignola
X Well ~~Well~~

FILED
March 6, 1924
STATE ENGINEER'S OFFICE

STATE of NEVADA
COUNTY of NYE

I Chas A Reno being first duly sworn, depose and say that the above map is a true and accurate plat of the location of X Well ~~Well~~ as taken from the field notes of a survey made by me, completed on the 10th day of July, 1922.

That the map and survey were made at the instance of J.J. Vignola owner of said Wind Mill and that it truly represents the location of said Wind Mill.

Subscribed and sworn to before me, this 9th day of Aug, 1922.

C.W. Thomas
Notary public in and for Nye Co. Nev.

RECEIVED MAR 6 1924

Certificate No. 1233, Bk. 5 issued Sept. 10, 1926 for 0.00156 c.f.s. stock.

6725