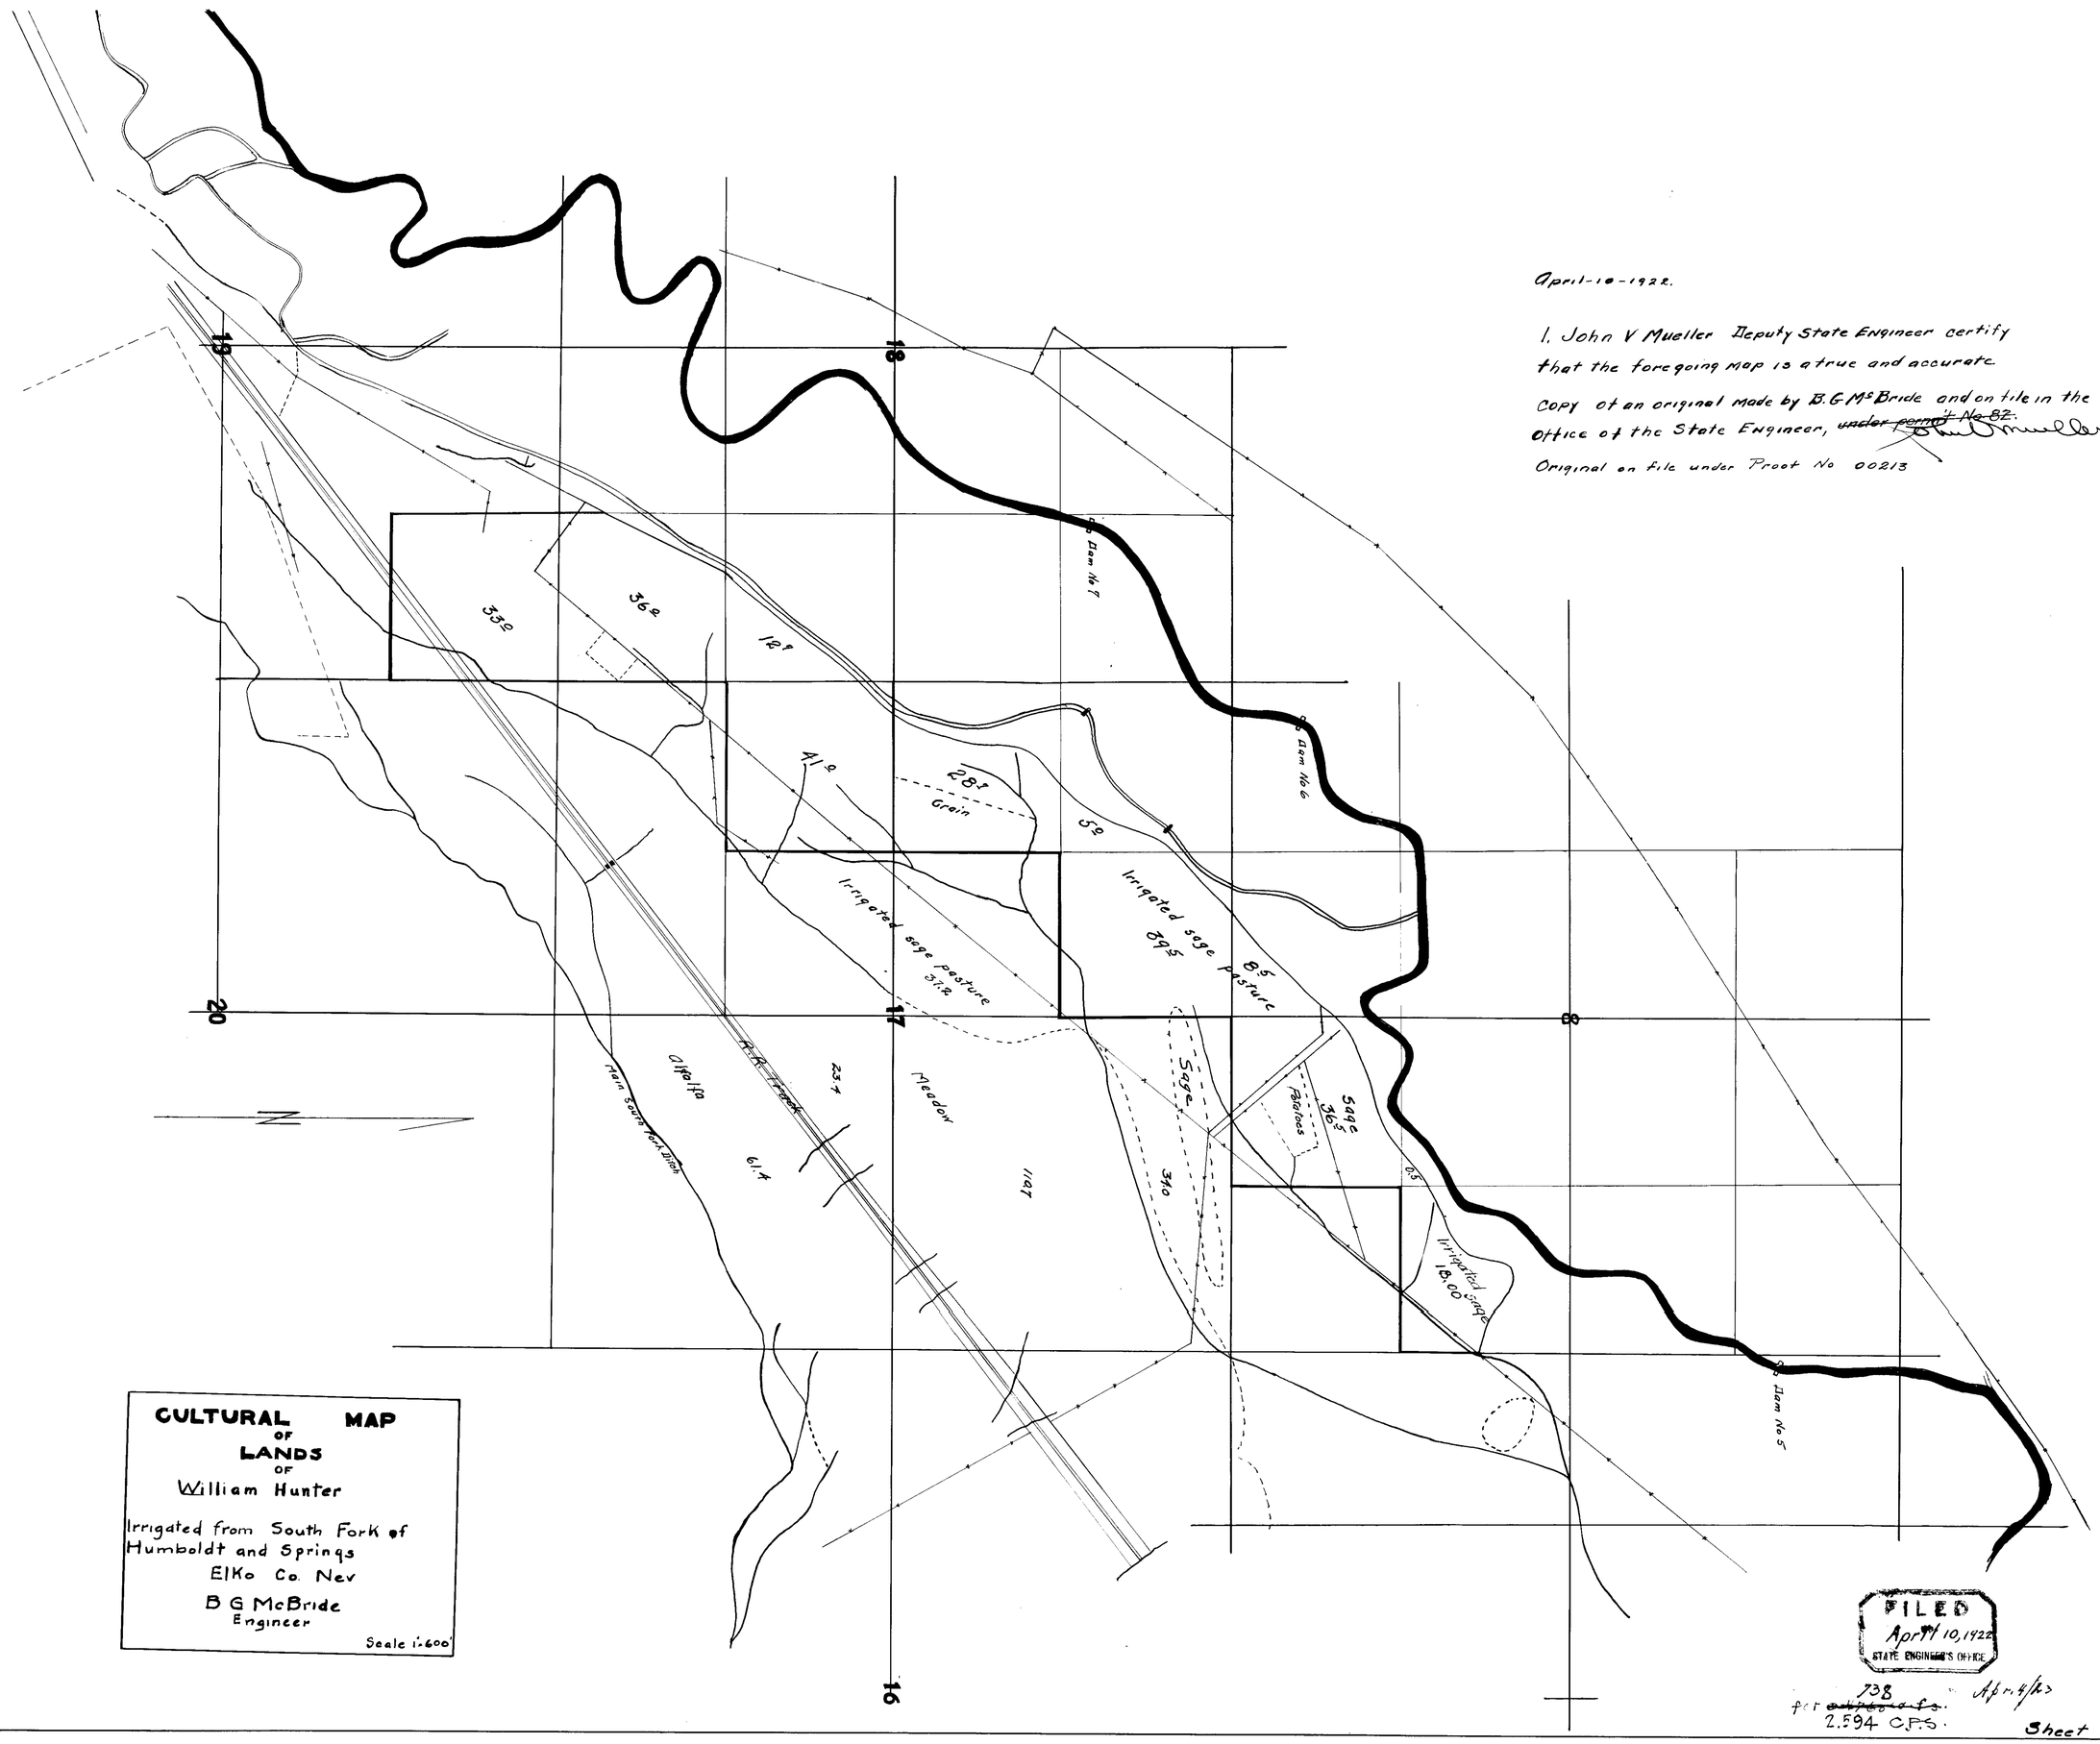

April-10-1922.

I, John V Mueller Deputy State Engineer certify that the foregoing map is a true and accurate copy of an original made by B.G. McBride and on file in the Office of the State Engineer, ~~under permit No 82.~~ John V Mueller

Original on file under Proof No 00213

CULTURAL MAP OF LANDS OF

William Hunter

Irrigated from South Fork of Humboldt and Springs

Elko Co. Nev

B G McBride
Engineer

Scale 1:600'

T.33N. R.54 E.

FILED
April 10, 1922
STATE ENGINEER'S OFFICE

for ~~[illegible]~~ 738 2.594 C.F.S. Apr. 4/23

(S)

Sheet No 1

82

April-10-1922.

I, John V. Mueller Deputy State Engineer certify that the foregoing map is a true and accurate copy of an original made by B G McBride and on file in the office of the State Engineer

Original on file under Proof No 00213

737
for 0.47 c.f.s.

FILED
April 10, 1922
STATE ENGINEER'S OFFICE

Sheet No 2