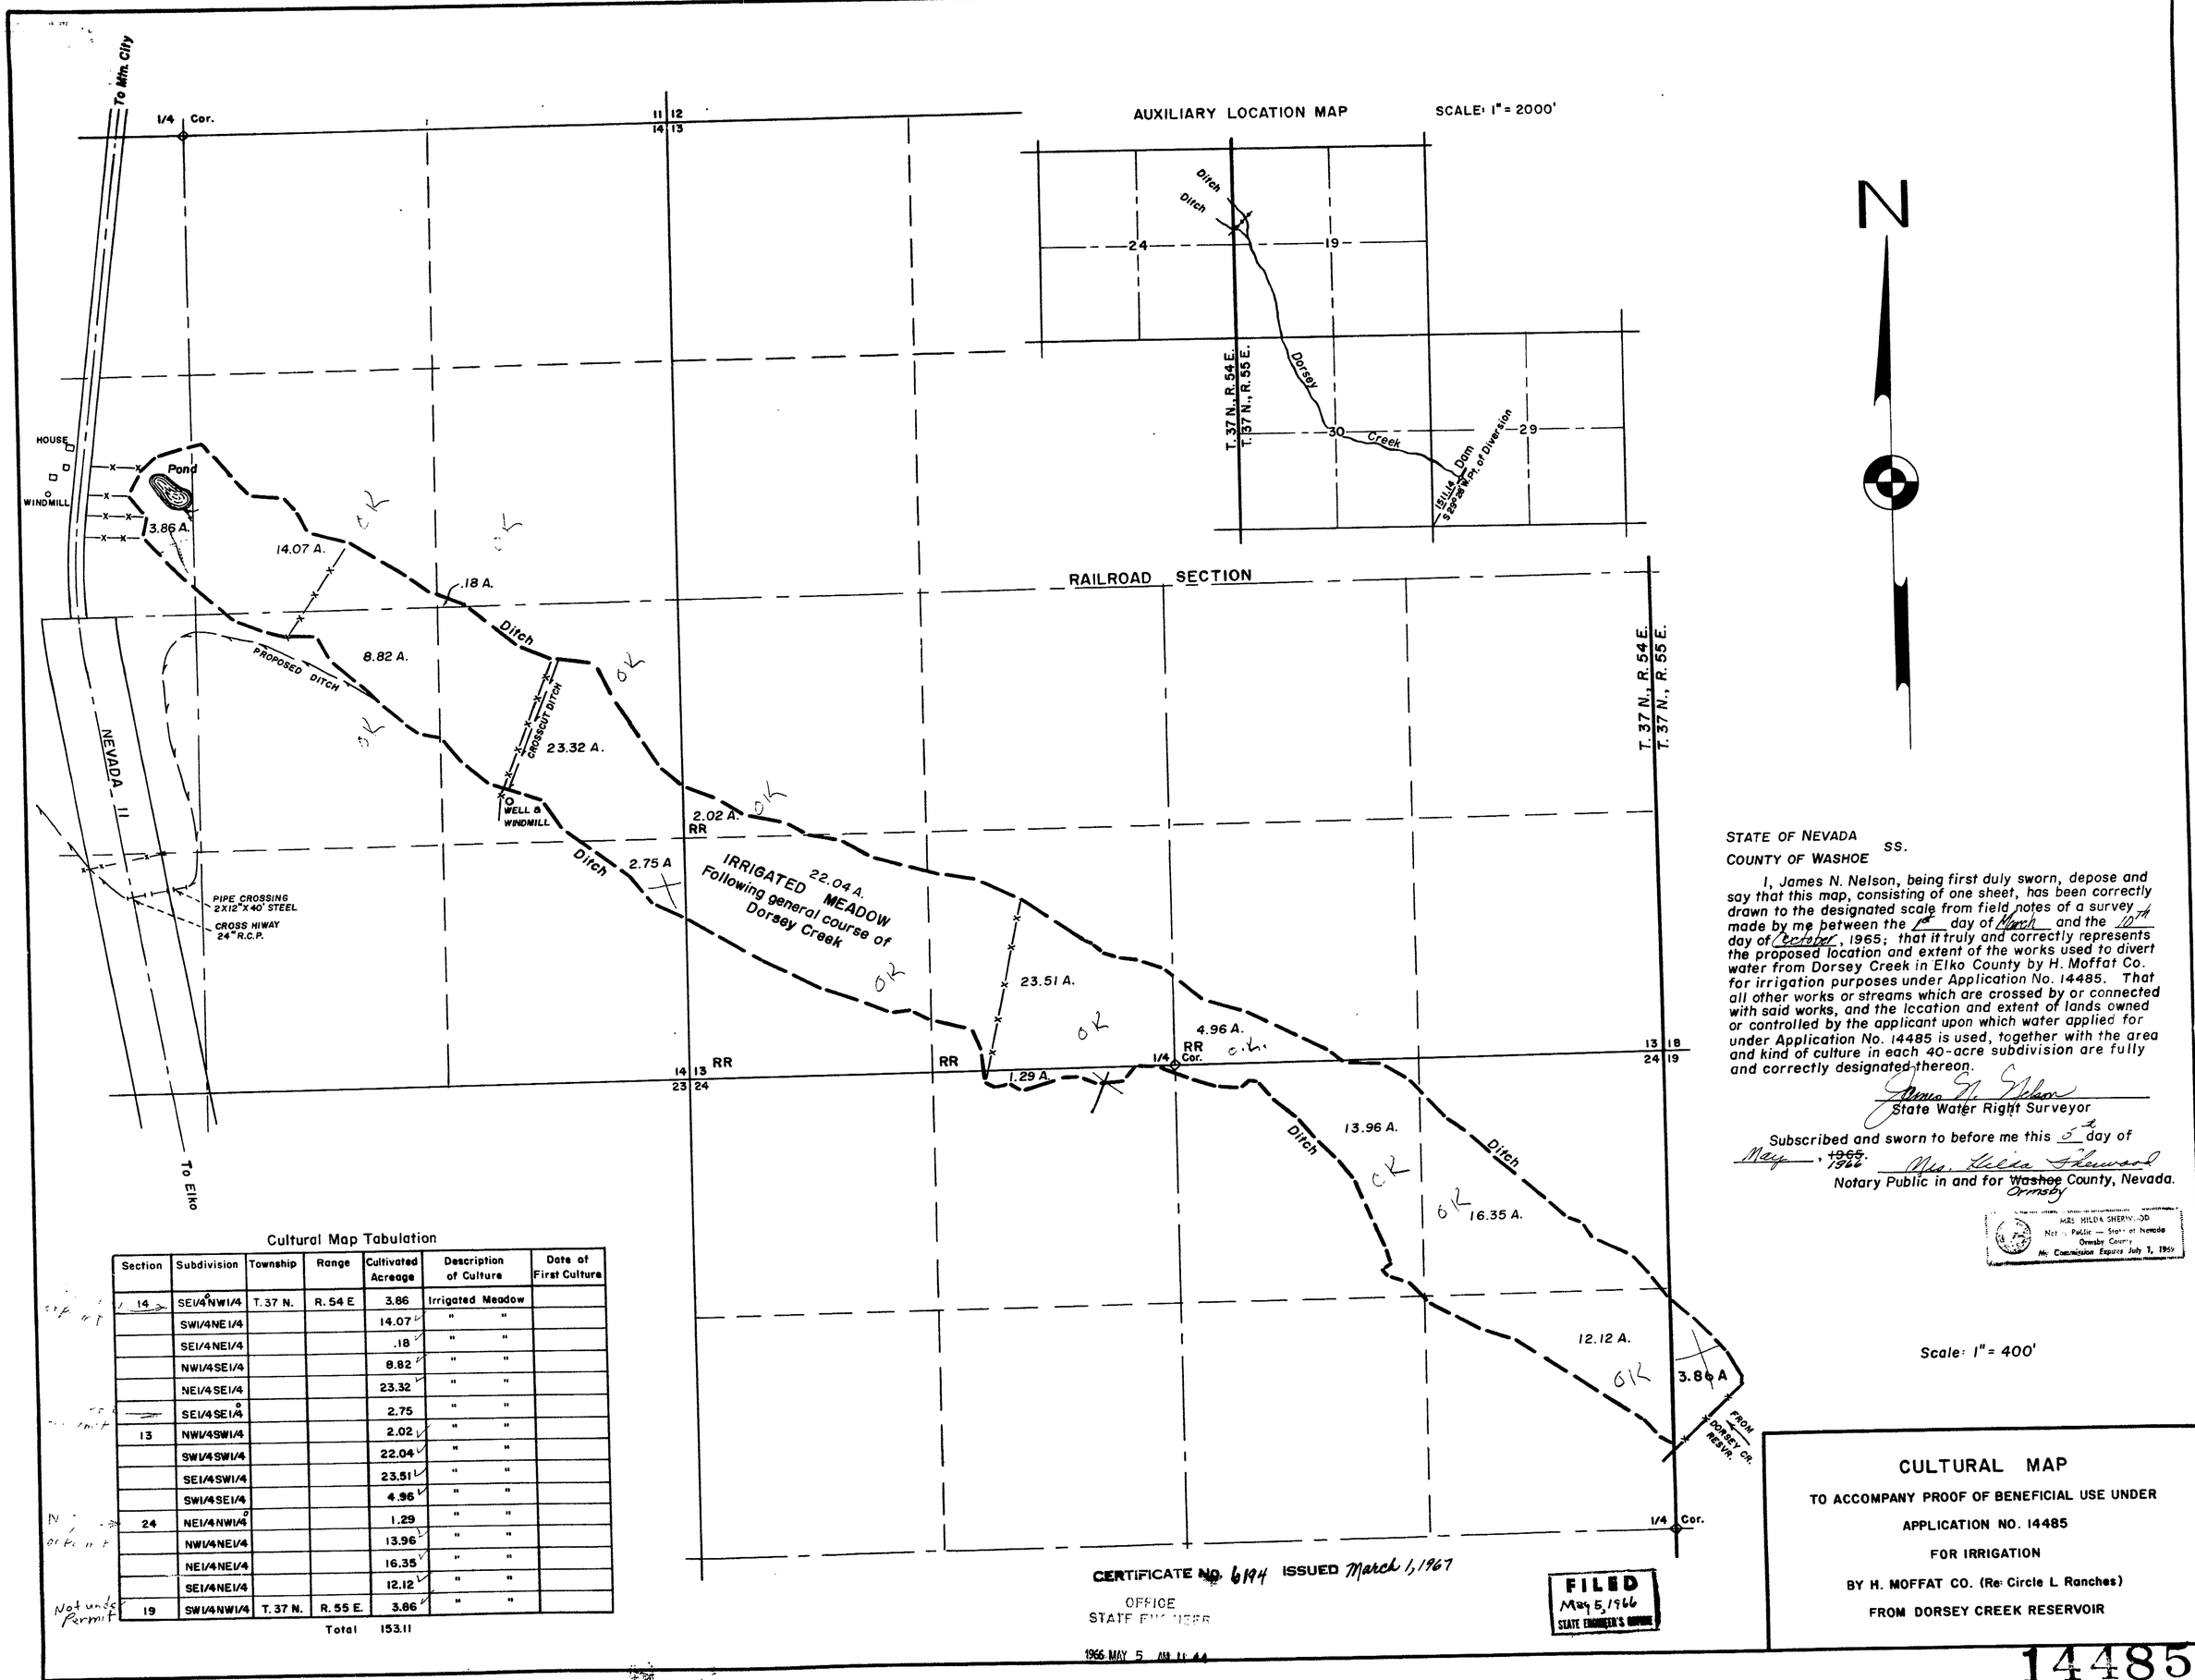

STATE OF NEVADA
COUNTY OF WASHOE SS.

I, James N. Nelson, being first duly sworn, depose and say that this map, consisting of one sheet, has been correctly drawn to the designated scale from field notes of a survey made by me between the 1st day of March and the 10th day of October, 1965; that it truly and correctly represents the proposed location and extent of the works used to divert water from Dorsey Creek in Elko County by H. Moffat Co. for irrigation purposes under Application No. 14485. That all other works or streams which are crossed by or connected with said works, and the location and extent of lands owned or controlled by the applicant upon which water applied for under Application No. 14485 is used, together with the area and kind of culture in each 40-acre subdivision are fully and correctly designated thereon.

James N. Nelson
State Water Right Surveyor

Subscribed and sworn to before me this 5th day of May, ~~1965~~ 1966.

Mrs. Hilda Sherwood
Notary Public in and for ~~Washoe~~ Ormsby County, Nevada.

MRS. HILDA SHERWOOD
Notary Public — State of Nevada
Ormsby County
My Commission Expires July 7, 1969

Scale: 1" = 400'

Cultural Map Tabulation

Section	Subdivision	Township	Range	Cultivated Acreage	Description of Culture	Date of First Culture
14	SE1/4NW1/4	T. 37 N.	R. 54 E	3.86	Irrigated Meadow	
	SW1/4NE1/4			14.07	" "	
	SE1/4NE1/4			.18	" "	
	NW1/4SE1/4			8.82	" "	
	NE1/4SE1/4			23.32	" "	
	SE1/4SE1/4			2.75	" "	
13	NW1/4SW1/4			2.02	" "	
	SW1/4SW1/4			22.04	" "	
	SE1/4SW1/4			23.51	" "	
	SW1/4SE1/4			4.96	" "	
24	NE1/4NW1/4			1.29	" "	
	NW1/4NE1/4			13.96	" "	
	NE1/4NE1/4			16.35	" "	
	SE1/4NE1/4			12.12	" "	
19	SW1/4NW1/4	T. 37 N.	R. 55 E.	3.86	" "	
			Total	153.11		

Not under Permit

CULTURAL MAP

TO ACCOMPANY PROOF OF BENEFICIAL USE UNDER

APPLICATION NO. 14485

FOR IRRIGATION

BY H. MOFFAT CO. (Re: Circle L Ranches)

FROM DORSEY CREEK RESERVOIR

14485