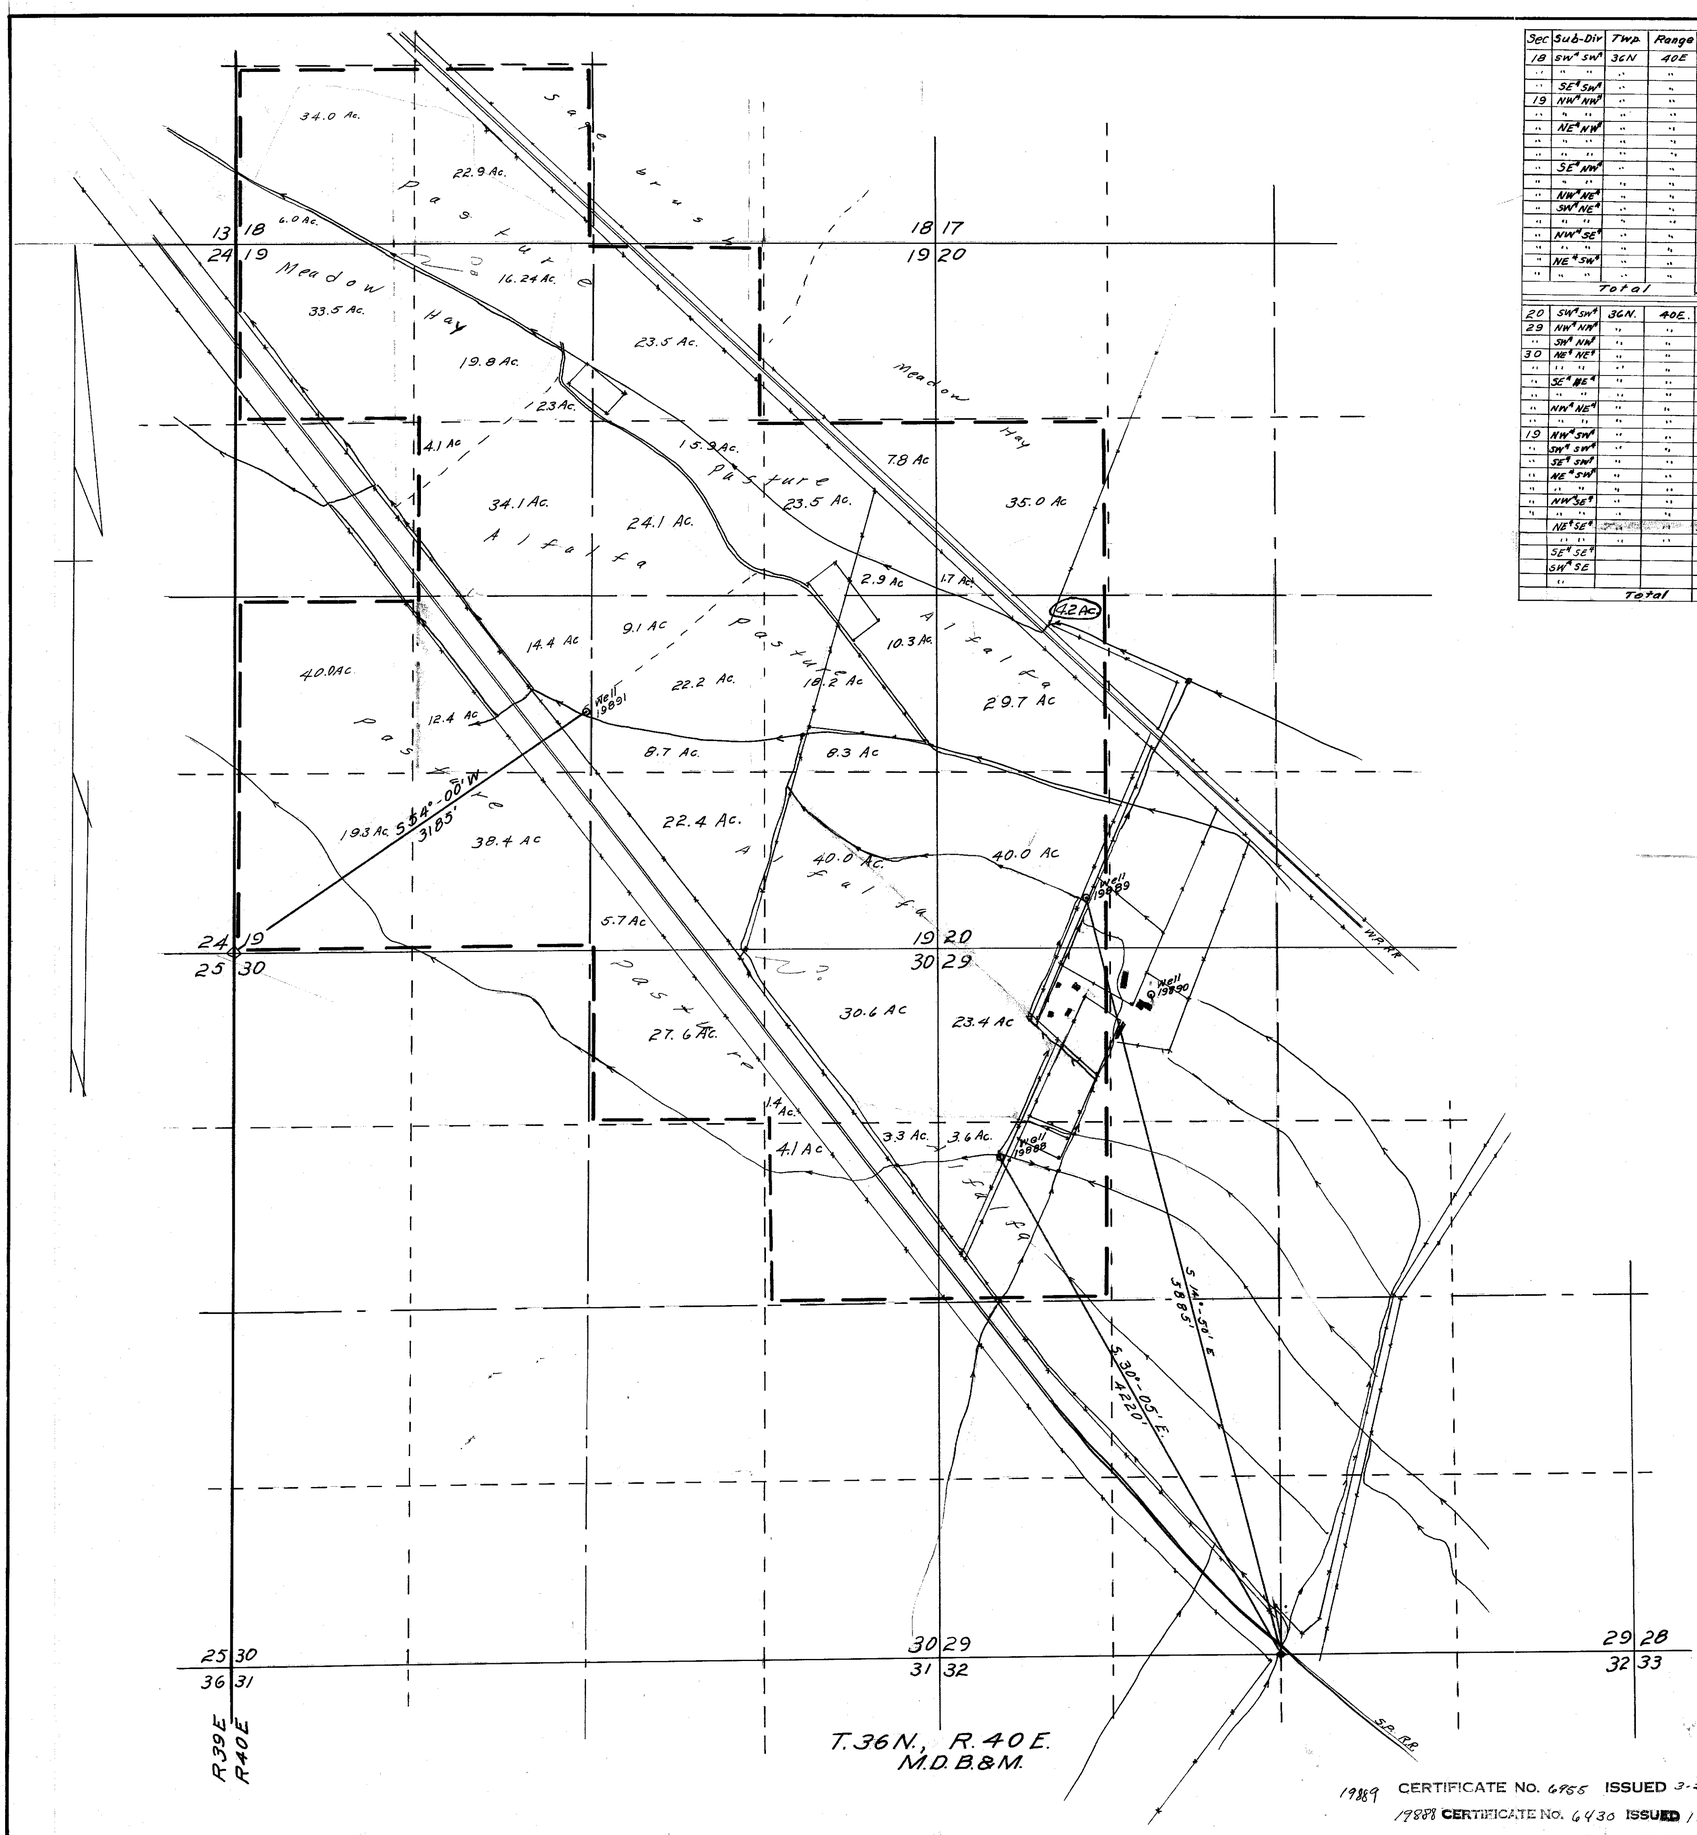

Sec	Sub-Div	Twp.	Range	Acres	Culture	Date
18	SW¼ SW¼	36N	40E	34.0	Pasture	
"	" "	"	"	6.0	Mea. Hay	
"	SE¼ SW¼	"	"	22.9	Pasture	
19	NW¼ NW¼	"	"	1.2	"	
"	" "	"	"	33.5	Mea. Hay	
"	NE¼ NW¼	"	"	19.8	" "	
"	" "	"	"	16.2	Pasture	
"	" "	"	"	2.3	Alfalfa	
"	SE¼ NW¼	"	"	34.1	"	
"	" "	"	"	4.1	Mea. Hay	
"	NW¼ NE¼	"	"	23.5	Pasture	
"	SW¼ NE¼	"	"	15.9	"	
"	" "	"	"	24.1	Alfalfa	
"	NW¼ SE¼	"	"	17.8	"	
"	" "	"	"	22.2	Pasture	
"	NE¼ SW¼	"	"	12.4	" "	
"	" "	"	"	14.4	Alfalfa	
Total				204.4	Well 19891	

20	SW¼ SW¼	36N.	40E.	40.0	Alfalfa	
29	NW¼ NW¼	"	"	23.4	"	
"	SW¼ NW¼	"	"	3.6	"	
30	NE¼ NE¼	"	"	30.6	"	
"	" "	"	"	1.4	Pasture	
"	SE¼ NE¼	"	"	4.1	"	
"	" "	"	"	3.3	Alfalfa	
"	NW¼ NE¼	"	"	1.1	"	
"	" "	"	"	27.6	Pasture	
19	NW¼ SW¼	"	"	40.0	"	
"	SW¼ SW¼	"	"	19.3	"	
"	SE¼ SW¼	"	"	38.4	"	
"	NE¼ SW¼	"	"	12.4	"	
"	" "	"	"	14.4	Alfalfa	
"	NW¼ SE¼	"	"	17.8	"	
"	" "	"	"	22.2	Pasture	
	NE¼ SE¼			18.2		
	" "	"	"	18.6	Alfalfa	
	SE¼ SE¼			40.0	"	
	SW¼ SE			22.4	"	
	"			5.7	Pasture	
		Total		404.5	Well 19888	

Section	Sub-Div.	Township	Range	Acres	Culture	Date of 1st Cult.
20	SW¼ SW¼	36N.	40E	40.0	Alfalfa	
"	NW¼ SW¼	"	"	29.7	"	
"	" "	"	"	4.2	Mea. Hay	
"	SW¼ NW¼	"	"	36.7	" "	
19	SE¼ NE¼	"	"	(7.48)	" "	
"	" "	"	"	23.3	Pasture	
"	" "	"	"	2.9	Alfalfa	
~~"	NE¼ SE¼~~	~~"~~	~~"~~	~~18.0~~	~~"~~	
~~"	" "	"~~	~~"~~	~~18.2~~	~~Pasture~~	
"	SW¼ NE¼	"	"	15.9	"	
"	" "	"	"	24.1	Alfalfa	
~~"	NE¼ SE¼~~	~~"~~	~~"~~	~~17.8~~	~~"~~	
~~"	" "	"~~	~~"~~	~~22.2~~	~~Pasture~~	
Total				~~260.0~~	Well #19889	
				(260.0)		
				18.8	ac.	

Note: See letter, 1-20-69, for corrections - KR

Note: See certificate removing NE¼ SE¼ - TCP 4/16/15 PER KE

STATE OF NEVADA
COUNTY OF HUMBOLDT } SS

I, J.R. Caldwell, being first duly sworn, depose and say that this map has been correctly drawn to the designated scale from field notes of a survey made by me between the 1st and 20th day of January, 1967; that truly and correctly represents the proposed location and extent of the works used to divert water from an underground source, in Humboldt County, Nevda by Nevada Garvey Ranches Inc. for irrigation purposes under Application No. 19888 19889 19891 That the point of diversion, the location, size of the diverting channel, location and description of all measuring devices, the location and extent of lands owned or controlled by the applicant upon which water applied for under Application Nos 19888, 19889, 19891 is used, together with the area and kind of culture in each 40-acre subdivision, and the location and names of all other works or streams which are crossed by or connected with said works are fully and correctly designated thereon.

J.R. Caldwell
State Water Right Surveyor #276

REGISTERED LAND SURVEYOR J. R. CALDWELL No. 276 NEVADA

Subscribed and sworn to me before this 21st day of JANUARY, 1967

William MacDonald
Notary Public in and for Humboldt County, Nevada

WILLIAM MACDONALD
Notary Public — State of Nevada
Humboldt County
My Commission Expires Dec. 17, 1967

Scale 1" = 600'

19889 CERTIFICATE No. 6985 ISSUED 3-27-69
19888 CERTIFICATE No. 6430 ISSUED 1-11-68
19891 CERTIFICATE No. 6595 ISSUED 3-18-68

FILED
Feb. 7, 1967
STATE ENGINEER'S OFFICE

MAP TO ACCOMPANY PROOF OF BENEFICIAL USE

UNDER APPLICATIONS 19888, 19889, 19891
FOR: Irrigation
BY: Nevada Garvey Ranches, Inc.
FROM: Underground
IN: Humboldt County, Nevada

85070 85064T 85061T 85059T 85062T 85068 85060 84138 83763 83762 83760 19891 19889 File under → 19888