SECTION	SUBDIVISION	TOWNSHIP	RANGE	AREA	CULTIVATION	DATE OF CULTURE
31	GOV'T LOT 3	21 S.	54 E.	1.3 AC	MIXED GRAIN	
31	NE¼ SW¼	21 S.	54 E.	33.7 AC	MIXED GRAIN	
31	NW¼ SE¼	21 S.	54 E.	16.5 AC	MIXED GRAIN	
31	GOV'T LOT 4	21 S.	54 E	39.2 AC	BARLEY	
31	SE¼ SW¼	21 S.	54 E.	39.5 AC	BARLEY	

129.7 ACRES

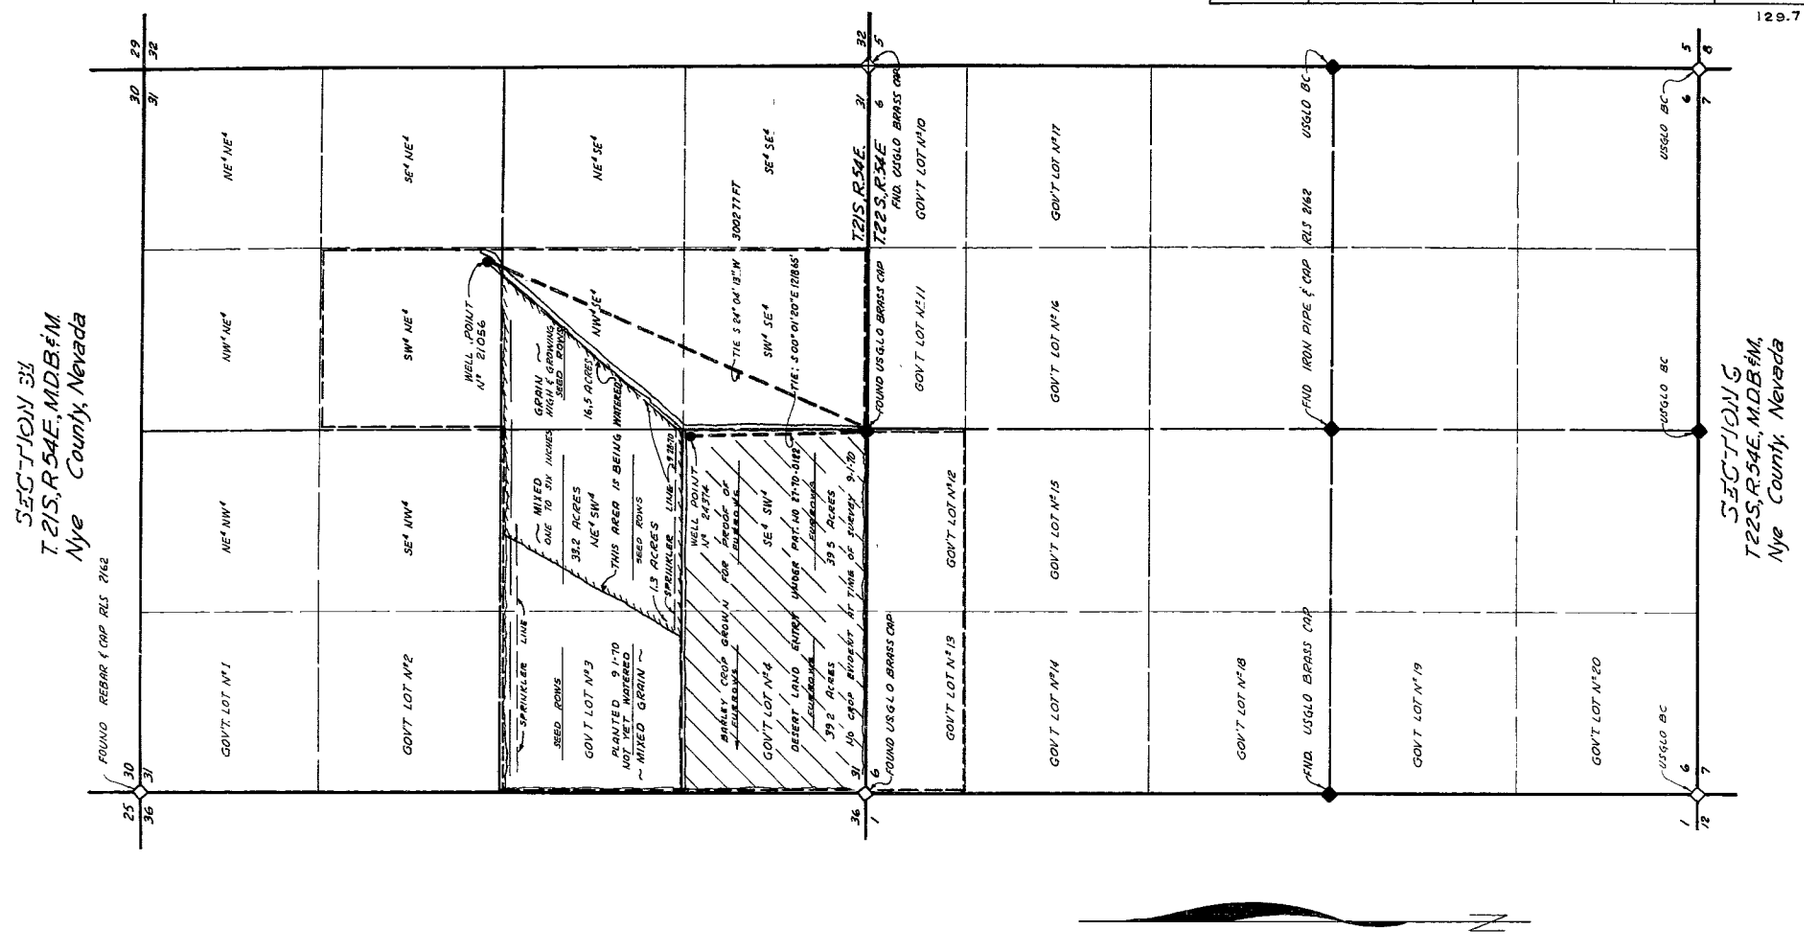

STATE OF NEVADA }
COUNTY OF CLARK } ss

I, RICHARD J. BAUGHMAN, BEING FIRST DULY SWORN, DEPOSE AND SAY THAT THIS MAP, CONSISTING OF ONE SHEET, HAS BEEN CORRECTLY DRAWN TO THE DESIGNATED SCALE FROM FIELD NOTES OF A SURVEY MADE UNDER MY SUPERVISION AND DIRECTION ON THE 24th DAY OF SEPTEMBER, 1970, THAT IT TRULY AND CORRECTLY REPRESENTS THE LOCATION AND EXTENT OF THE WORKS USED TO DIVERT WATER FROM AN UNDERGROUND SOURCE, PAHRUMP VALLEY BASIN, NYE COUNTY, NEVADA BY BEN A. SANCHEZ FOR IRRIGATION AND DOMESTIC PURPOSES UNDER APPLICATION NO. ~~20156~~ 21056. THAT THE POINT OF DIVERSION, THE LOCATION, SIZE AND GRADES OF THE DIVERTING CHANNEL, LOCATION AND DESCRIPTION OF ALL MEASURING DEVICES, THE LOCATION AND EXTENT OF LANDS OWNED OR CONTROLED BY THE APPLICANT UPON WHICH WATER APPLIED FOR UNDER APPLICATION NO. ~~20156~~ 21056 IS USED, TOGETHER WITH THE AREA AND KIND OF CULTURE IN EACH 40 ACRE SUBDIVISION, AND THE LOCATION AND NAMES OF ALL OTHER WORKS OR STREAMS WHICH ARE CROSSED BY OR CONNECTED WITH SAID WORKS ARE FULLY AND CORRECTLY DESIGNATED THEREON.

Richard J. Baughman
STATE WATER RIGHT SURVEYOR

REGISTERED PROFESSIONAL ENGINEER STATE OF NEVADA
RICHARD J. BAUGHMAN
CIVIL
No. 2162

SUBSCRIBED AND SWORN TO BEFORE ME THIS 24TH DAY OF SEPTEMBER, 1970

Notary Public State of Nevada
CLARK COUNTY
J D HAUGHT
My Commission Expires Apr 9 1974

J D Haught
NOTARY PUBLIC IN AND FOR
SAID COUNTY AND STATE

MY COMMISION EXPIRES APRIL 9TH 1974

FILED
OCT 9 1970
STATE ENGINEER'S OFFICE

1970 OCT 9 AM 8 23

21056 CERTIFICATE No. 7580 ISSUED 1-5-71

600 500 400 300 200 100 0 500 1000 1500 2000 2500
SCALE 1" = 600'

MAP TO ACCOMPANY PROOF OF BENEFICIAL USE UNDER PERMIT NO ~~20156~~ 21056
SEE LETTER OF 11/6/70

BY: BEN A SANCHEZ
FOR: IRRIGATION AND DOMESTIC PURPOSES
FROM: AN UNDERGROUND SOURCE - PAHRUMP VALLEY BASIN NYE COUNTY, NEVADA

BAUGHMAN, HAUGHT & TURNER
PROFESSIONAL ENGINEERS AND LAND SURVEYORS
536 EAST SAHARA AVENUE LAS VEGAS, NEVADA

21056