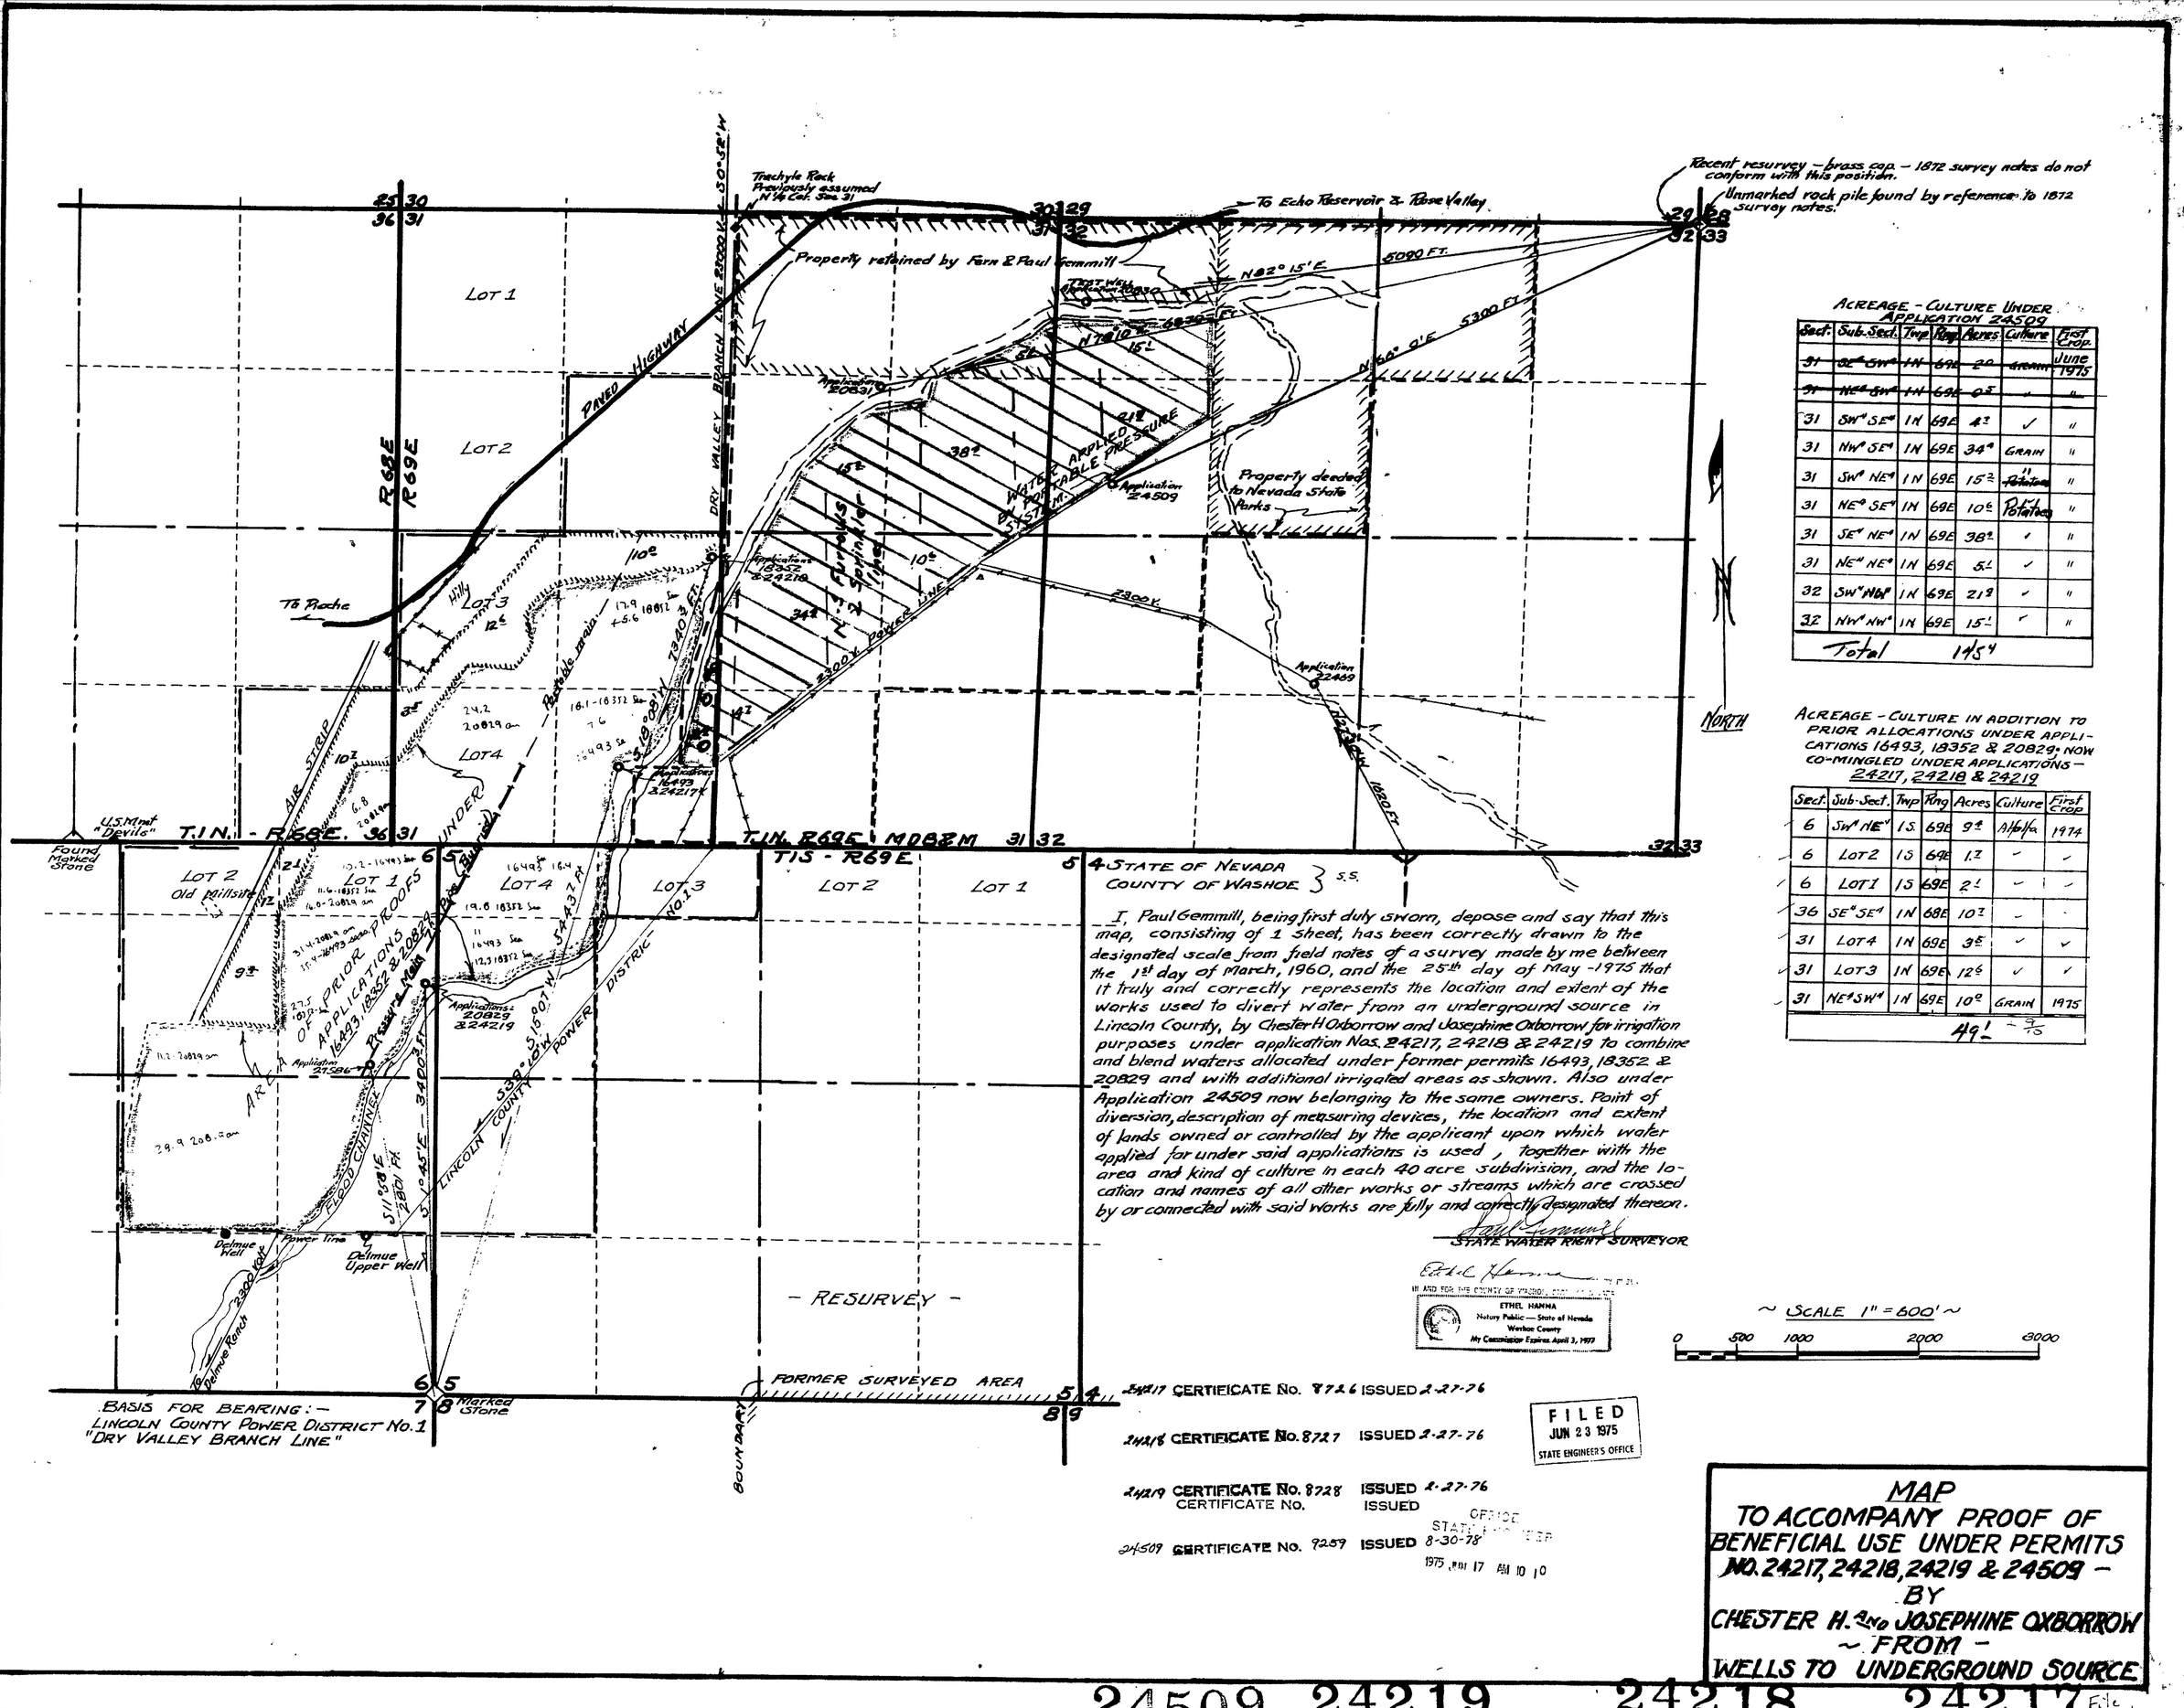

ACREAGE - CULTURE UNDER APPLICATION 24509

Sect.	Sub. Sect.	Twp	Rng	Acres	Culture	First Crop
~~31~~	~~SE⁴ SW⁴~~	~~1N~~	~~69E~~	~~2a~~	~~Grain~~	~~June 1975~~
~~31~~	~~NE⁴ SW⁴~~	~~1N~~	~~69E~~	~~0.5~~	~~"~~	~~"~~
31	SW⁴ SE⁴	1N	69E	4.3	✓	"
31	NW⁴ SE⁴	1N	69E	34.9	GRAIN	"
31	SW⁴ NE⁴	1N	69E	15.2	~~Potatoes~~ "	"
31	NE⁴ SE⁴	1N	69E	10.6	Potatoes	"
31	SE⁴ NE⁴	1N	69E	38.2	✓	"
31	NE⁴ NE⁴	1N	69E	5.1	✓	"
32	SW⁴ NW⁴	1N	69E	21.9	✓	"
32	NW⁴ NW⁴	1N	69E	15.1	✓	"
Total				145.4		

ACREAGE - CULTURE IN ADDITION TO PRIOR ALLOCATIONS UNDER APPLICATIONS 16493, 18352 & 20829; NOW CO-MINGLED UNDER APPLICATIONS - 24217, 24218 & 24219

Sect.	Sub. Sect.	Twp	Rng	Acres	Culture	First Crop
6	SW⁴ NE⁴	1S	69E	9.4	Alfalfa	1974
6	LOT 2	1S	69E	1.7	✓	✓
6	LOT 1	1S	69E	2.1	✓	✓
36	SE⁴ SE⁴	1N	68E	10.7	✓	✓
31	LOT 4	1N	69E	3.5	✓	✓
31	LOT 3	1N	69E	12.6	✓	✓
31	NE⁴ SW⁴	1N	69E	10.0	GRAIN	1975
				49.1		

STATE OF NEVADA
COUNTY OF WASHOE } S.S.

I, Paul Gemmill, being first duly sworn, depose and say that this map, consisting of 1 sheet, has been correctly drawn to the designated scale from field notes of a survey made by me between the 1st day of March, 1960, and the 25th day of May - 1975 that it truly and correctly represents the location and extent of the works used to divert water from an underground source in Lincoln County, by Chester H Oxborrow and Josephine Oxborrow for irrigation purposes under application Nos. 24217, 24218 & 24219 to combine and blend waters allocated under former permits 16493, 18352 & 20829 and with additional irrigated areas as shown. Also under Application 24509 now belonging to the same owners. Point of diversion, description of measuring devices, the location and extent of lands owned or controlled by the applicant upon which water applied for under said applications is used, together with the area and kind of culture in each 40 acre subdivision, and the location and names of all other works or streams which are crossed by or connected with said works are fully and correctly designated thereon.

Paul Gemmill
STATE WATER RIGHT SURVEYOR

Ethel Hanna
IN AND FOR THE COUNTY OF WASHOE, STATE OF NEVADA
ETHEL HANNA
Notary Public — State of Nevada
Washoe County
My Commission Expires April 3, 1977

~ SCALE 1" = 600' ~
0 500 1000 2000 3000

24217 CERTIFICATE No. 8726 ISSUED 2-27-76
24218 CERTIFICATE No. 8727 ISSUED 2-27-76
24219 CERTIFICATE No. 8728 ISSUED 2-27-76
CERTIFICATE No. ISSUED
24509 CERTIFICATE No. 9259 ISSUED 8-30-78

FILED
JUN 23 1975
STATE ENGINEER'S OFFICE

OFFICE STATE ENGINEER
1975 JUN 17 AM 10 10

MAP
TO ACCOMPANY PROOF OF BENEFICIAL USE UNDER PERMITS NO. 24217, 24218, 24219 & 24509 - BY CHESTER H. AND JOSEPHINE OXBORROW ~ FROM ~ WELLS TO UNDERGROUND SOURCE

24509 24219 24218 24217 File