SECTION	SUB-DIVISION	TOWNSHIP	RANGE	CULTIVATED ACREAGE	DESCRIPTION OF CULTURE	DATE OF FIRST CULTURE
8	SE¼NW¼	T20S	R53E	33.86	GRASS	
"	NE 4 NW 4	"	"	40	"	
				73.86		

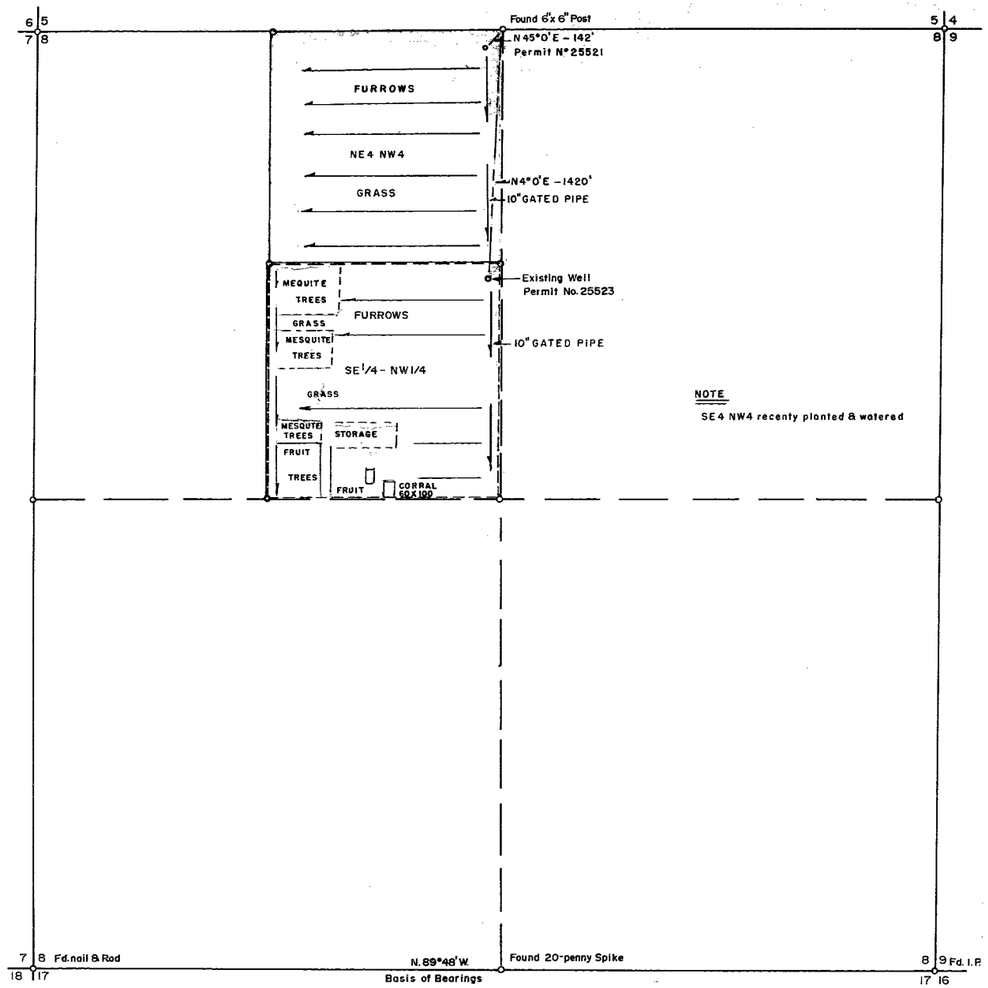

Note:
Basis of Bearings - South Line Section 8.

State of Nevada
County of Washoe } ss.

I, J.V. Caselli, being first duly sworn depose and say that this map consisting of 1 sheet, numbered from 0 to 1 inclusive, has been correctly drawn to the designated scale from field notes of a survey made by me between the 10 day of January and the 11 day of January, 1974, that it truly and correctly represents the proposed location and extent of the works to divert water from Underground Source, in NYE COUNTY by RONNY E. FLOYD, for irrigation purposes, under Application No. 25521 25523. That the point of diversion, the location, size of the diverting channel, location and description of all measuring devices, the location and extent of lands owned or controlled by the applicant upon which water applied for under Application No. 25523 is used together with the area and kind of culture in each 40 acre subdivision and the location ~~and name of all other wells or streams~~ which are crossed or connected with said work are fully and correctly designated thereon.

J. V. Caselli
~~Registered Surveyor~~

Subscribed and sworn to before me this 14th day of June, 1974

Gladys E. Anderson Carson City
NOTARY PUBLIC IN AND FOR COUNTY, NEVADA

GLADYS E. ANDERSON
Notary Public — State of Nevada
Carson City
My Commission Expires July 2, 1977

25521 CERTIFICATE No. 8533 ISSUED 7-29-75

25523 CERTIFICATE No. 8534 ISSUED 7-29-75

OFFICE
STATE ENGINEER
1974 JUN 14 AM 11 22

FILED
JUN 14 1974
STATE ENGINEER'S OFFICE

0 400 800 1200 1600 2000

MAP TO ACCOMPANY
PROOF OF BENEFICIAL USE - UNDER
PERMIT NO. 25523-25521
FOR
DOMESTIC & IRRIGATION
FROM
UNDERGROUND SOURCE
BY
RONNY E. FLOYD

SCALE 1" = 400'

SURVEYED BY — J.V. CASELLI

25523 25521