CULTURAL MAP TABULATION						
SEC-TION	SUBDIVISION	TWN.	RGE.	CULTI-TED ACREAGE	DESCRIPTION OF CULTURE	DATE OF FIRST CULTURE
22	NW4 NE4	40N	33E	33.5	ALF, APPLE ORCHARD	
"	NE4 NE4	"	"	39.5	ALFALFA	
"	SW4 NE4	"	"	32.2	"	
"	SE4 NE4	"	"	39.4	"	
23	NW4 NW4	"	"	38.8	"	
"	NE4 NW4	"	"	38.5	"	
"	SW4 NW4	"	"	39.4	"	
"	SE4 NW4	"	"	39.7	"	
"	NW4 NE4	"	"	39.4	"	
"	NE4 NE4	"	"	39.7	"	
"	SW4 NE4	"	"	39.3	"	
"	SE4 NE4	"	"	31.0	"	

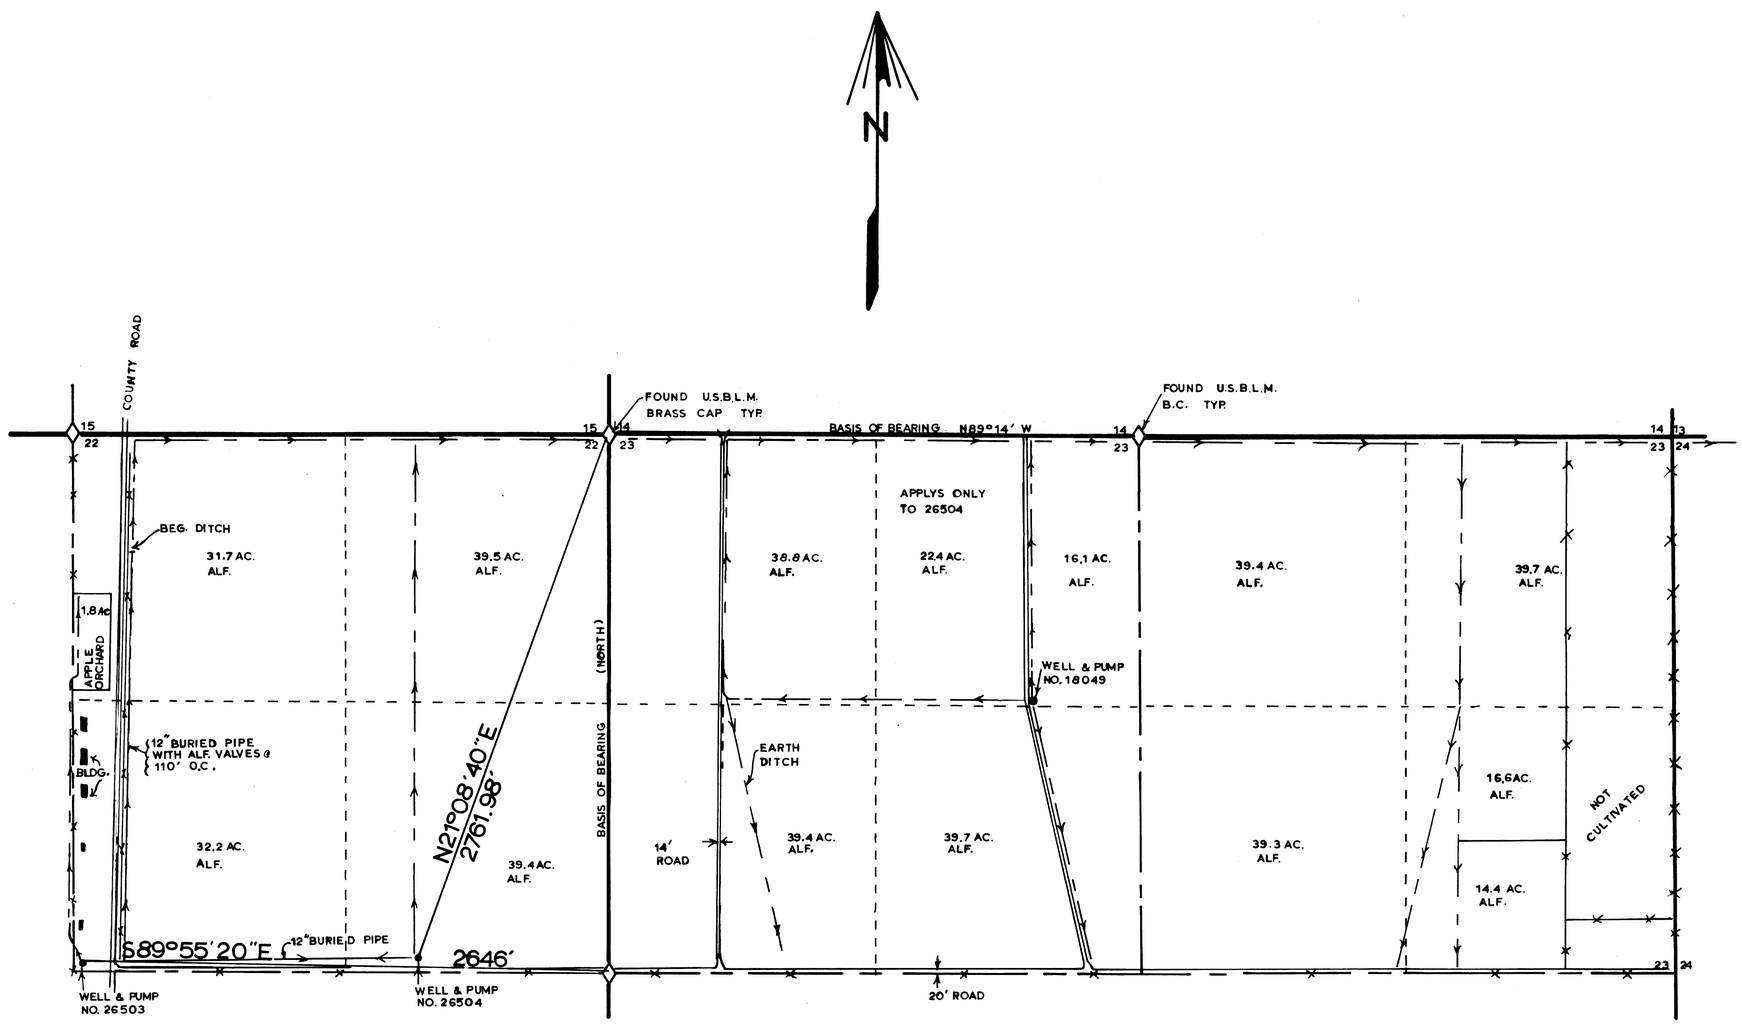

STATE OF NEVADA
COUNTY OF HUMBOLDT } S.S.

I C.H. KETCHAM, BEING FIRST DULY SWORN, DEPOSE AND SAY THAT THIS MAP, CONSISTING OF 1 SHEET, HAS BEEN CORRECTLY DRAWN TO THE DESIGNATED SCALE FROM FIELD NOTES OF A SURVEY MADE BY ME, ON THE _____ DAY OF _____, 1972; THAT IT TRULY AND CORRECTLY REPRESENTS THE PROPOSED LOCATION AND EXTENT OF THE WORKS USED TO DIVERT WATER FROM UNDERGROUND IN HUMBOLDT COUNTY, BY WALTER CLARNO FOR IRRIGATION PURPOSES UNDER APPLICATION NO.(S) 26503, 26504 THAT THE POINT OF DIVERSION, THE LOCATION, SIZE OF DIVERTING CHANNEL, LOCATION AND DESCRIPTION OF ALL MEASURING DEVICES, THE LOCATION AND EXTENT OF LANDS OWNED OR CONTROLLED BY THE APPLICANT UPON WHICH WATER APPLIED FOR UNDER APPLICATION NO.(S) 26503, 26504 IS USED, TOGETHER WITH THE AREA AND KIND OF CULTURE IN EACH 40-ACRE SUBDIVISION, AND THE LOCATION AND NAMES OF ALL OTHER WORKS OR STREAMS WHICH ARE CROSSED BY OR CONNECTED WITH SAID WORKS ARE FULLY AND CORRECTLY DESIGNATED THEREON.

C. H. Ketcham
STATE WATER-RIGHT SURVEYOR R.L.S. 3049

SUBSCRIBED AND SWORN TO BEFORE ME THIS 31st DAY OF October, 1972.

Barbara A. Ketcham
NOTARY PUBLIC HUMBOLDT COUNTY, NEVADA

BARBARA A. KETCHAM
Notary Public — State of Nevada
Humboldt County
My Commission Expires Mar. 12, 1975

0' 100' 200' 300' 400' 800' 2000'
SCALE — 1" = 400'

CERTIFICATE No. 8063 ISSUED 4-6-73
CERTIFICATE No. 8307 ISSUED 6-21-74

FILED
DEC 11 1972
STATE ENGINEER'S OFFICE

MAP
TO ACCOMPANY PROOF of BENEFICIAL USE UNDER APPLICATION No. 26503, & 26504 for IRRIGATION.
By: WALTER CLARNO
From: UNDERGROUND

C.H. "PETE" KETCHAM — REGISTERED LAND SURVEYORS
P.O. BOX 461 WINNEMUCCA, NEVADA

T40N R33E M.D.B.&M.

~~05554~~ ~~05553~~ ~~05552~~ ~~05551~~ 26504 26503