Note: Bearings shown are related to a geodetic azimuth carried from Nev. Highway Dept. 2nd order triangulation station ZEPHER carried into the M.C. at which point bearings are true.

Course and distance tie to point of diversion is approximate due to inability to accurately locate end of intake pipe. Tie to pump is precise, obtained by transit and tape traverse.

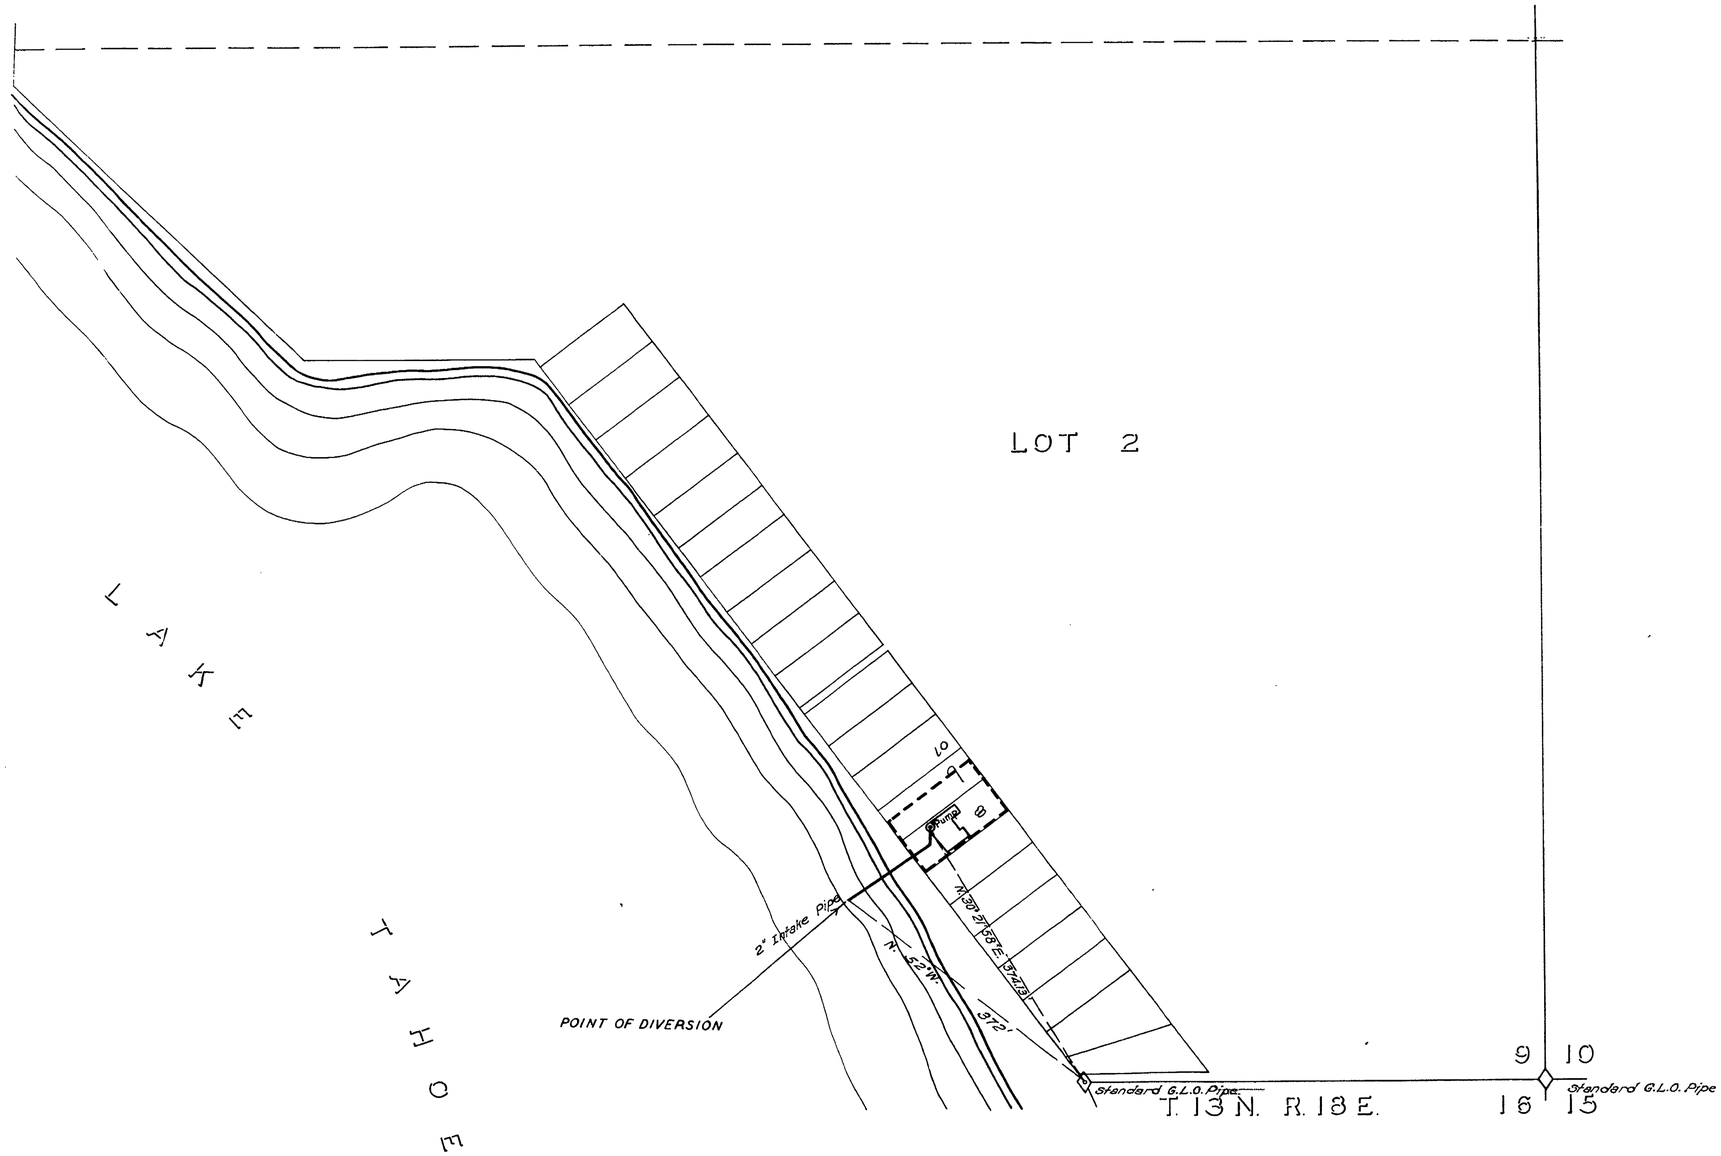

STATE OF NEVADA.
County of Washoe ss.

I, Robert F. Guinn, being first duly sworn, depose and say that this map, consisting of 1 sheet has been correctly drawn to the designated scale from field notes of a survey made under my supervision and direction between the 15th day of June, and the 15th day of July, 1947; that it truly and correctly represents the location and extent of the works used to divert water from Lake Tahoe, in Douglas County, by Alice A. Hagarty for domestic purposes under application No. 11976. That the point ~~(or proposed point)~~ of diversion, the location, size and grades of the diverting channel, location and description of all measuring devices, the location and extent of lands owned or controlled by the applicant upon which water applied for under application No. 11976 is used ~~(or to be used)~~, together with the area and kind of culture in each 40-acre subdivision, and the location and names of all other works or streams which are crossed by or connected with said works are fully and correctly designated thereon.

Robert F. Guinn
State Water Right Surveyor

Subscribed and sworn to before me this 17th day of October, 1947.

Notary Public in and for Washoe County, Nevada.

0 660 FEET
SCALE 1" = 100'

3292 Issued 10/28/49 For 0.0008 c.f.s.

FILED
October 20, 1947
STATE ENGINEER'S OFFICE

MAP
TO ACCOMPANY APPLICATION NO.
11976
TO APPROPRIATE WATER FROM
LAKE TAHOE
FOR DOMESTIC PURPOSES BY
ALICE A. HAGARTY
AND PROOF OF BENEFICIAL USE

11976