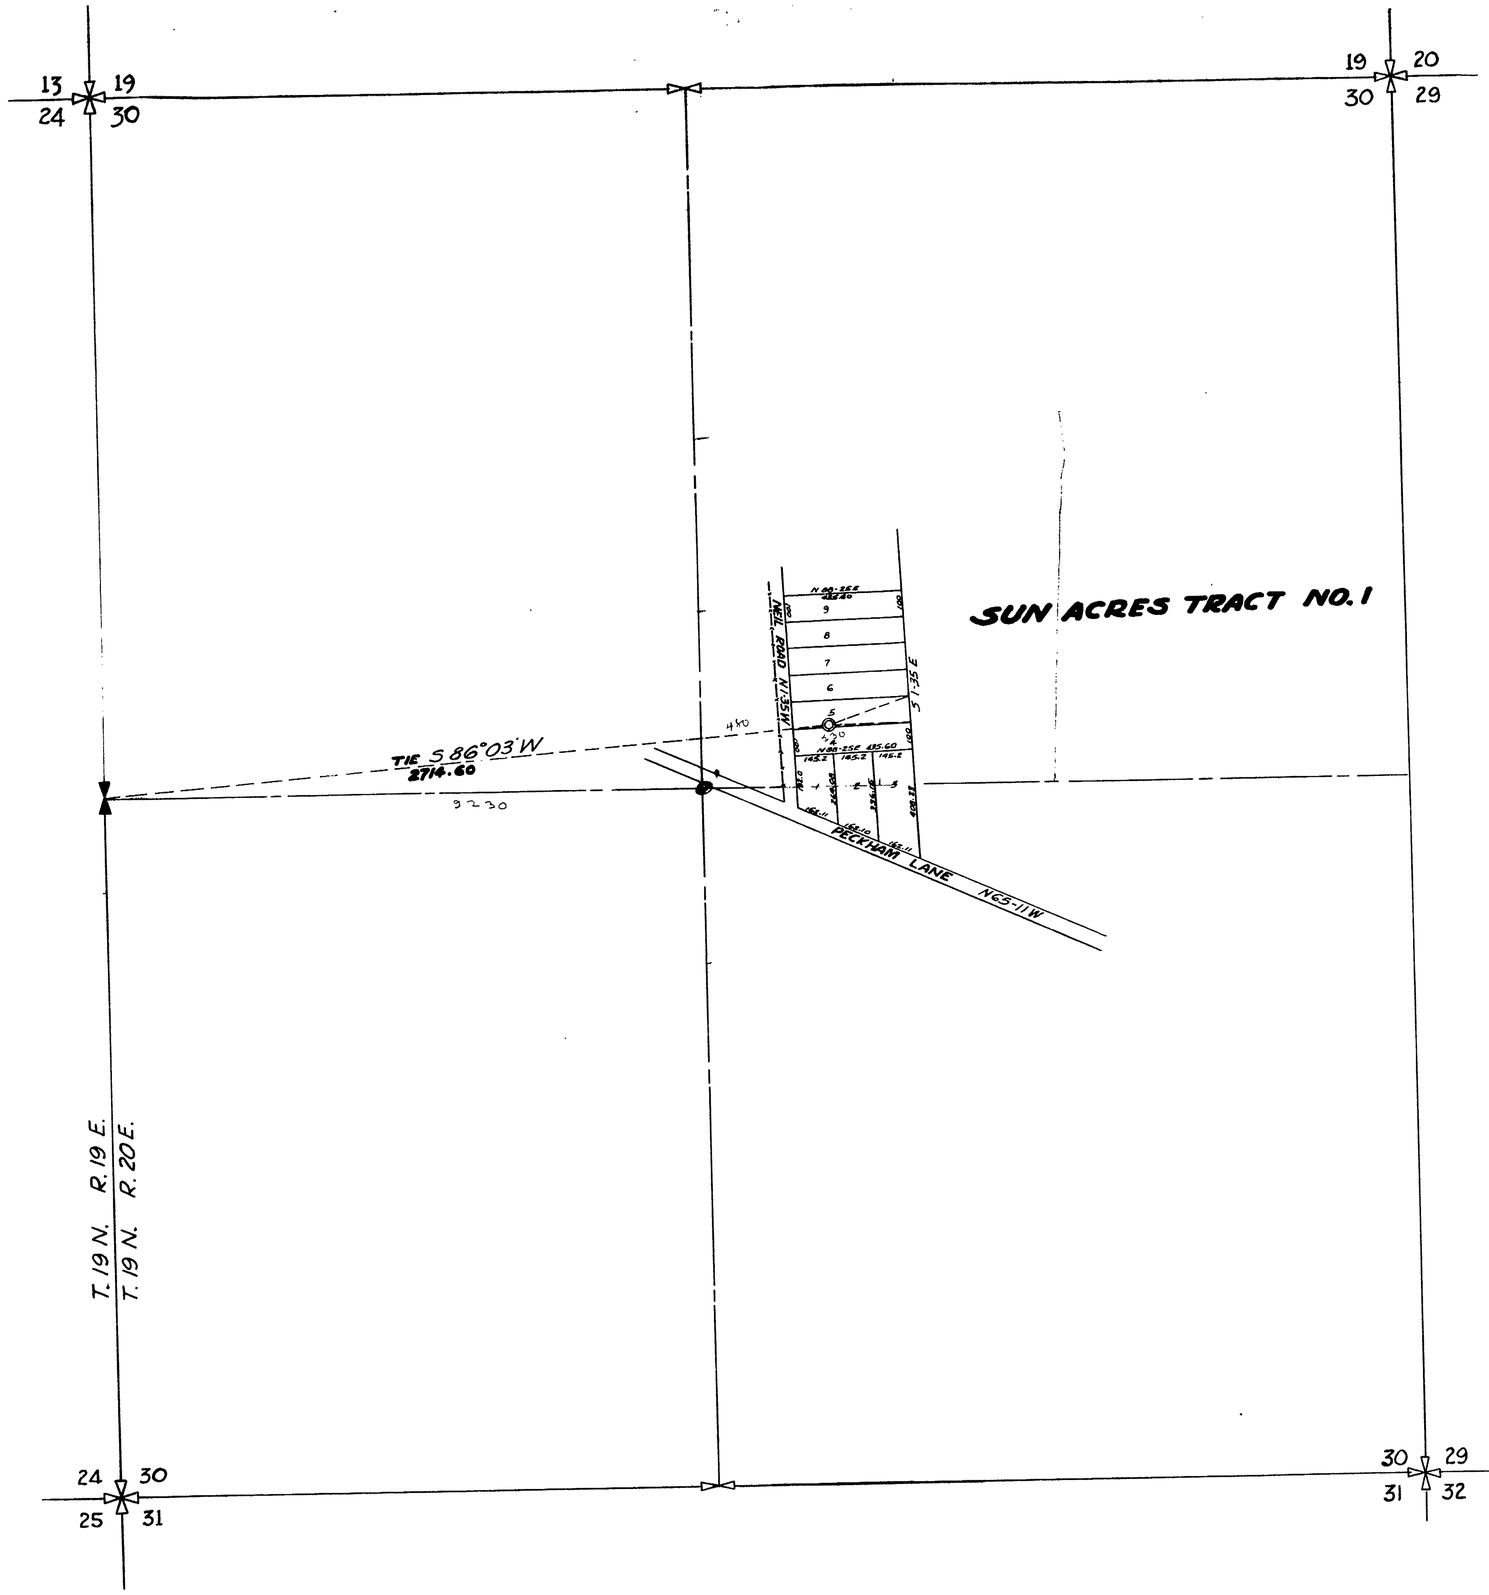

STATE OF NEVADA } SS
COUNTY OF WASHOE }

I, Peter G. Guisti, being first duly sworn, depose and say, that this map, consisting of one sheet, has been correctly drawn to the designated scale from field notes of a survey made under my direction between March 3rd & March 20, 1954; that it truly and correctly represents the location of the well to be used by Graham Brooks for agricultural and domestic purposes; that the said well is located in Lot 5, Sun Acres Tract No. 1 situate in the SW¼ of NE¼, Sec. 30, T19N R20E ~~M.D.B.&M.~~

Peter G. Guisti
STATE WATER RIGHT SURVEYOR

Subscribed and sworn to before me this 12th day of May 1954

Notary Public in and for the County of Washoe, Nevada. My commision expires February 21, 1956

Martha M. Marlo

FILED
OCT. 27, 1954
STATE ENGINEER'S OFFICE

OFFICE STATE ENGINEER
OCT 27 '54

CERTIFICATE No. 5363 ISSUED July 31, 1962

MAP TO ACCOMPANY
APPLICATION TO APROPRIATE
UNDERGROUND WATER
Class - Municipal FOR
~~AGRICULTURAL~~ & DOMESTIC
USE
BY GRAHAM BROOKS
SCALE: 1" = 300'

15836