Township 21 North, Range 19 East, M.D.B. & M.

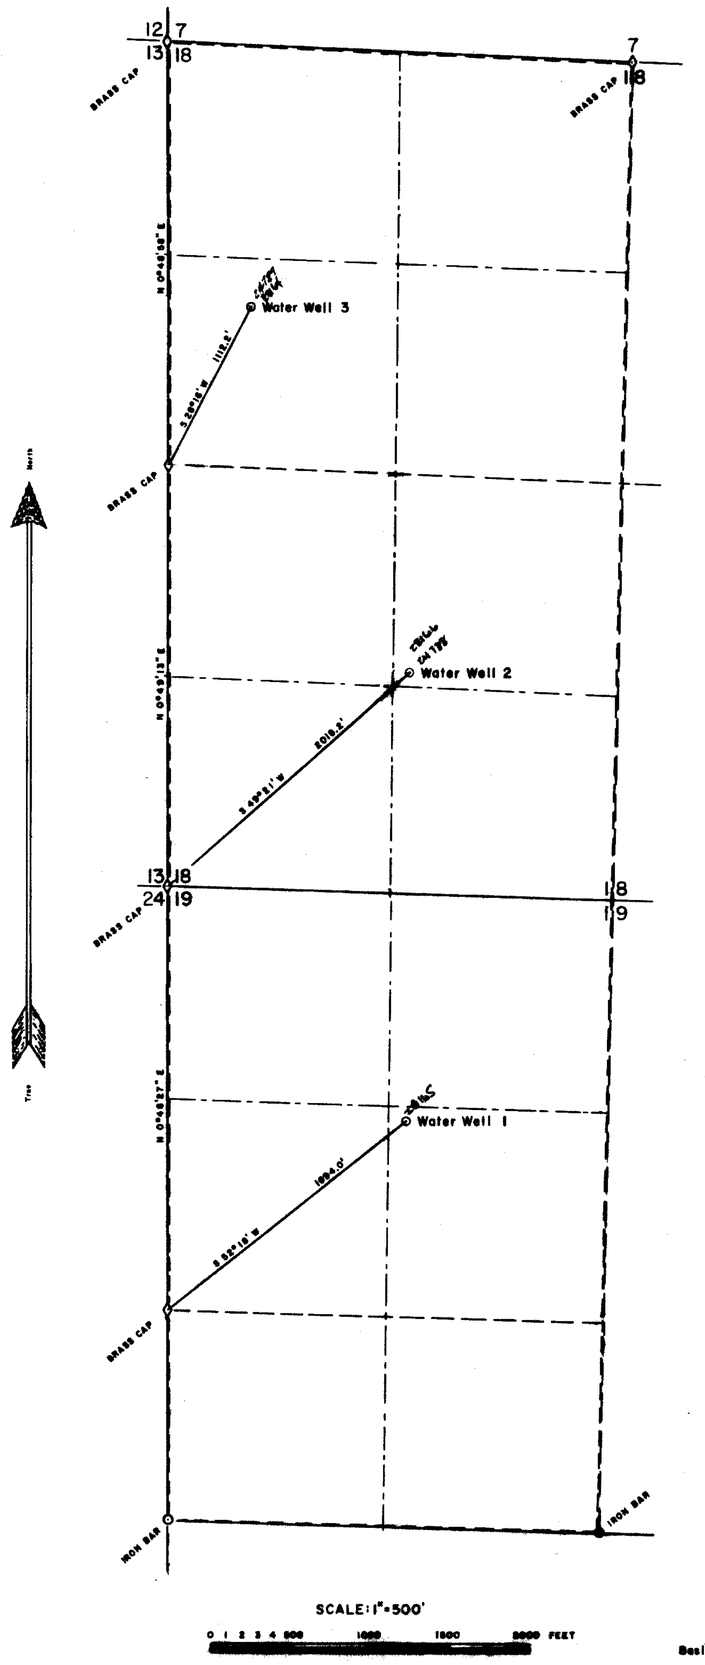

SCALE: 1" = 500'

0 1 2 3 4 500 1000 1500 2000 FEET

Basis of bearing = Reno city survey

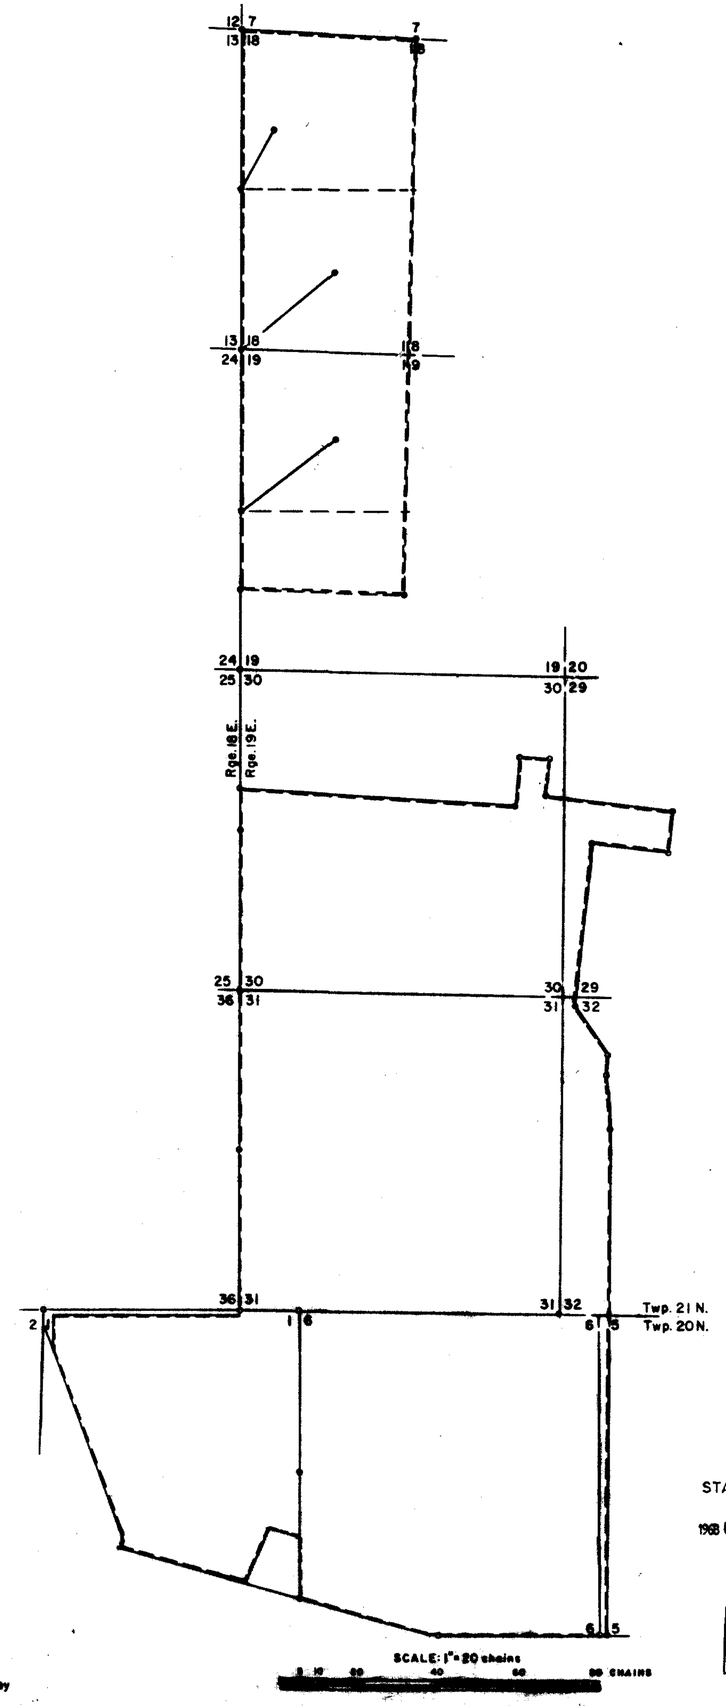

SCALE: 1" = 20 chains

0 10 20 40 60 80 CHAINS

STATE OF NEVADA
COUNTY OF WASHOE SS

I, *Keith N. Meador*, being first duly sworn, dispose and say that this map, consisting ~~of one~~ sheet, has been correctly drawn to the designated scale from field notes of a survey made by me on November 23rd., 1968; that it truly represents the proposed location and extent of works to be used to divert water from underground sources, in Washoe County, by RENO/STEAD DEVELOPMENT COMPANY for irrigation, industrial and domestic purposes. That the proposed point of diversion, the approximate location of the diverting pipes and the boundary of all lands wherein the waters are to be used, are fully and correctly designated thereon.

Keith N. Meador
State Water-Right Surveyor

Scribed and sworn to before me this 2nd day of ~~November~~ December, 1968.

Mrs. Hilda Sherwood
Notary Public in and for Washoe County, Nevada

MRS. HILDA SHERWOOD
Notary Public — State of Nevada
Ormsby County
My Commission Expires July 1, 1969

OFFICE
STATE ENGINEER

1968 DEC 2 PM 4 14

FILED
DEC 2 1968
STATE ENGINEER'S OFFICE

S

MAP To ACCOMPANY APPLICATION
to
APPROPRIATE WATER
for
IRRIGATION, INDUSTRIAL and DOMESTIC
USES by
RENO/STEAD DEVELOPMENT COMPANY
From an UNDERGROUND SOURCE

71154T
71153T
70872T
70871T 69395T 69394T 68815T 68814T 28166 28165 28164 24790 24789 24788