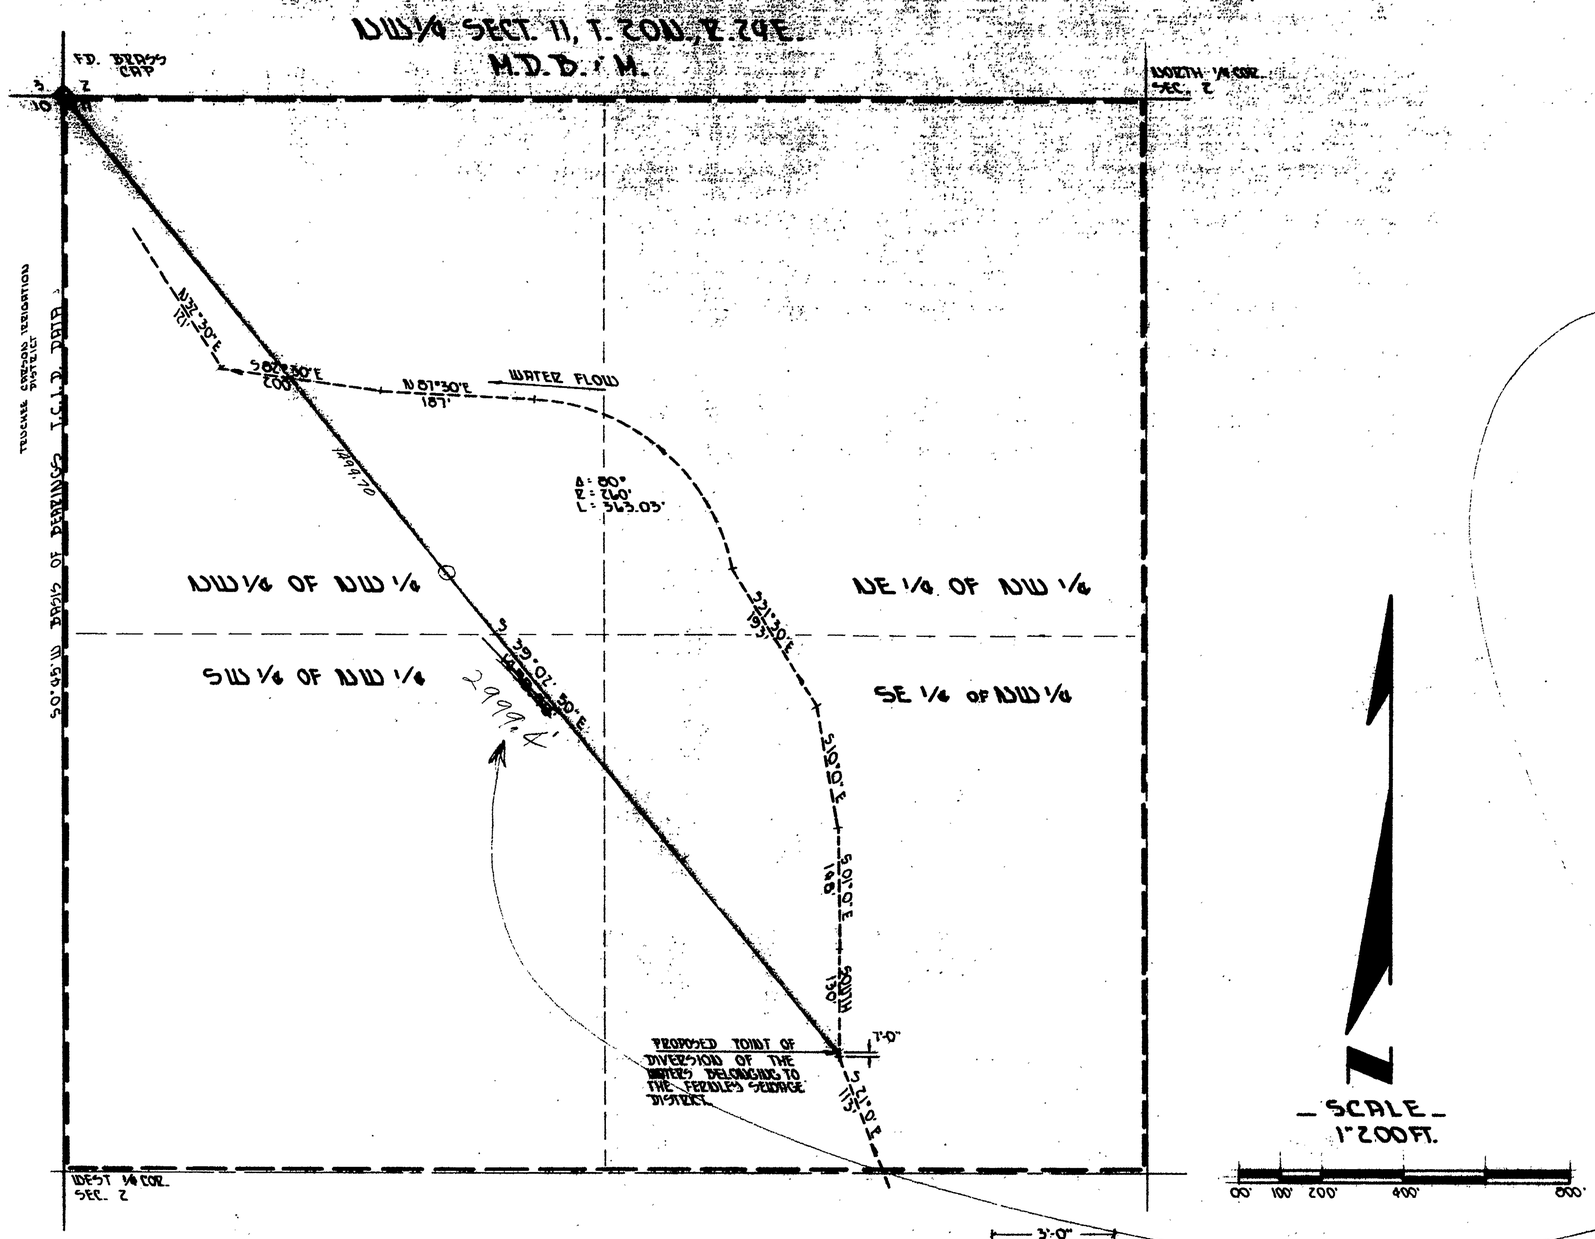

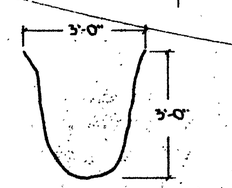

DETAIL OF THE CONCRETE DITCH USED BY FERNLEY SEWAGE DISTRICT

FILED
JUN 30 1970
STATE ENGINEER'S OFFICE

CERTIFICATE No. 8933 ISSUED 2-11-77

OFFICE STATE ENGINEER
1970 JUN 30 AM 11 56

OFFICE STATE ENGINEER
1970 JUN 22 AM 10 56

OFFICE STATE ENGINEER
1970 MAY 18 AM 10 56

OFFICE STATE ENGINEER
1970 JUN 5 PM 1 56

TO ACCOMPANY APPLICATION TO APPROPRIATE WATER FOR MINING AND MILLING PURPOSES.

STATE OF NEVADA }
COUNTY OF LYON } SS

I, WALLACE A. COOPER, BEING FIRST DULY SWORN, DEPOSE AND SAY THAT THIS MAP CONSISTING OF 1 SHEET, HAS BEEN CORRECTLY DRAWN TO THE DESIGNED SCALE FROM FIELD NOTES OF A SURVEY MADE BY ME, BETWEEN THE 10TH DAY OF APRIL, AND THE 11TH DAY OF APRIL, 1970; THAT IT TRULY AND CORRECTLY REPRESENTS THE PROPOSED LOCATION AND EXTENT OF THE WORKS USED TO DIVERT WATER FROM THE SMALL CONCRETE DITCH AND POINT OF WATER APPROPRIATE, IN LYON COUNTY, BY

NEVADA CEMENT COMPANY

FOR ~~MINING AND MILLING~~ MANUFACTURING PURPOSES. THAT THE PROPOSED POINT OF DIVERSION AND RETURN THE LOCATION OF THE MILL THE APPROXIMATE SIZE AND CAPACITY OF THE DIVERTING CHANNEL AND THE LOCATION AND NAMES OF ALL OTHER WORKS OR STREAMS WHICH ARE CROSSED BY OR CONNECTED WITH SAID WORKS ARE FULLY AND CORRECTLY DESIGNATED HEREON.

Wallace A. Cooper
WALLACE A. COOPER R.L.S. 749 S.W.R.S. 321

SUBSCRIBED AND SWORN TO BEFORE ME THIS 21 DAY OF APRIL, 1970.
NOTARY PUBLIC IN AND FOR COUNTY, NEVADA.

Robert J. Graham
ROBERT J. GRAHAM
Notary Public — State of Nevada
Churchill County
My Commission Expires Aug. 2, 1977

SEE LETTER OF AUG 4, 1970
25577

TO ACCOMPANY APPLICATION TO APPROPRIATE WATER FOR ~~MINING AND MILLING~~ MANUFACTURING PURPOSES.

BY NEVADA CEMENT COMPANY FROM SMALL CONCRETE DITCH BELONGING TO FERNLEY SEWAGE DISTRICT

WALLACE A. COOPER S.W.R.S. 321 R.L.S. 749

DRAWN BY: D.A. MELLO APRIL 13, 1970

25577