Section	Subdivision	Township	Range	Cultivated Acreage	Description of Culture	Date of First Culture
23	SW 1/4 NW 1/4	6 N.	56 E.	40 Acs.	Yellow Clover, Grass	
23	SE 1/4 NW 1/4	6 N.	56 E.	5 "	"	
Permit No.'s 21964 & 25202		Total Acreage:		45 Acs.		

23	SW 1/4 NW 1/4	6 N.	56 E.	40 Acs.	Yellow Clover, Grass	
23	SE 1/4 NW 1/4	6 N.	56 E.	5 "	"	
23	SE 1/4 NW 1/4	6 N.	56 E.	21 "	Pasture	
Permit No. 25203		Total Acreage:		66 Acs.		

T. 6 N., R. 56 E., M.D.B.&M.

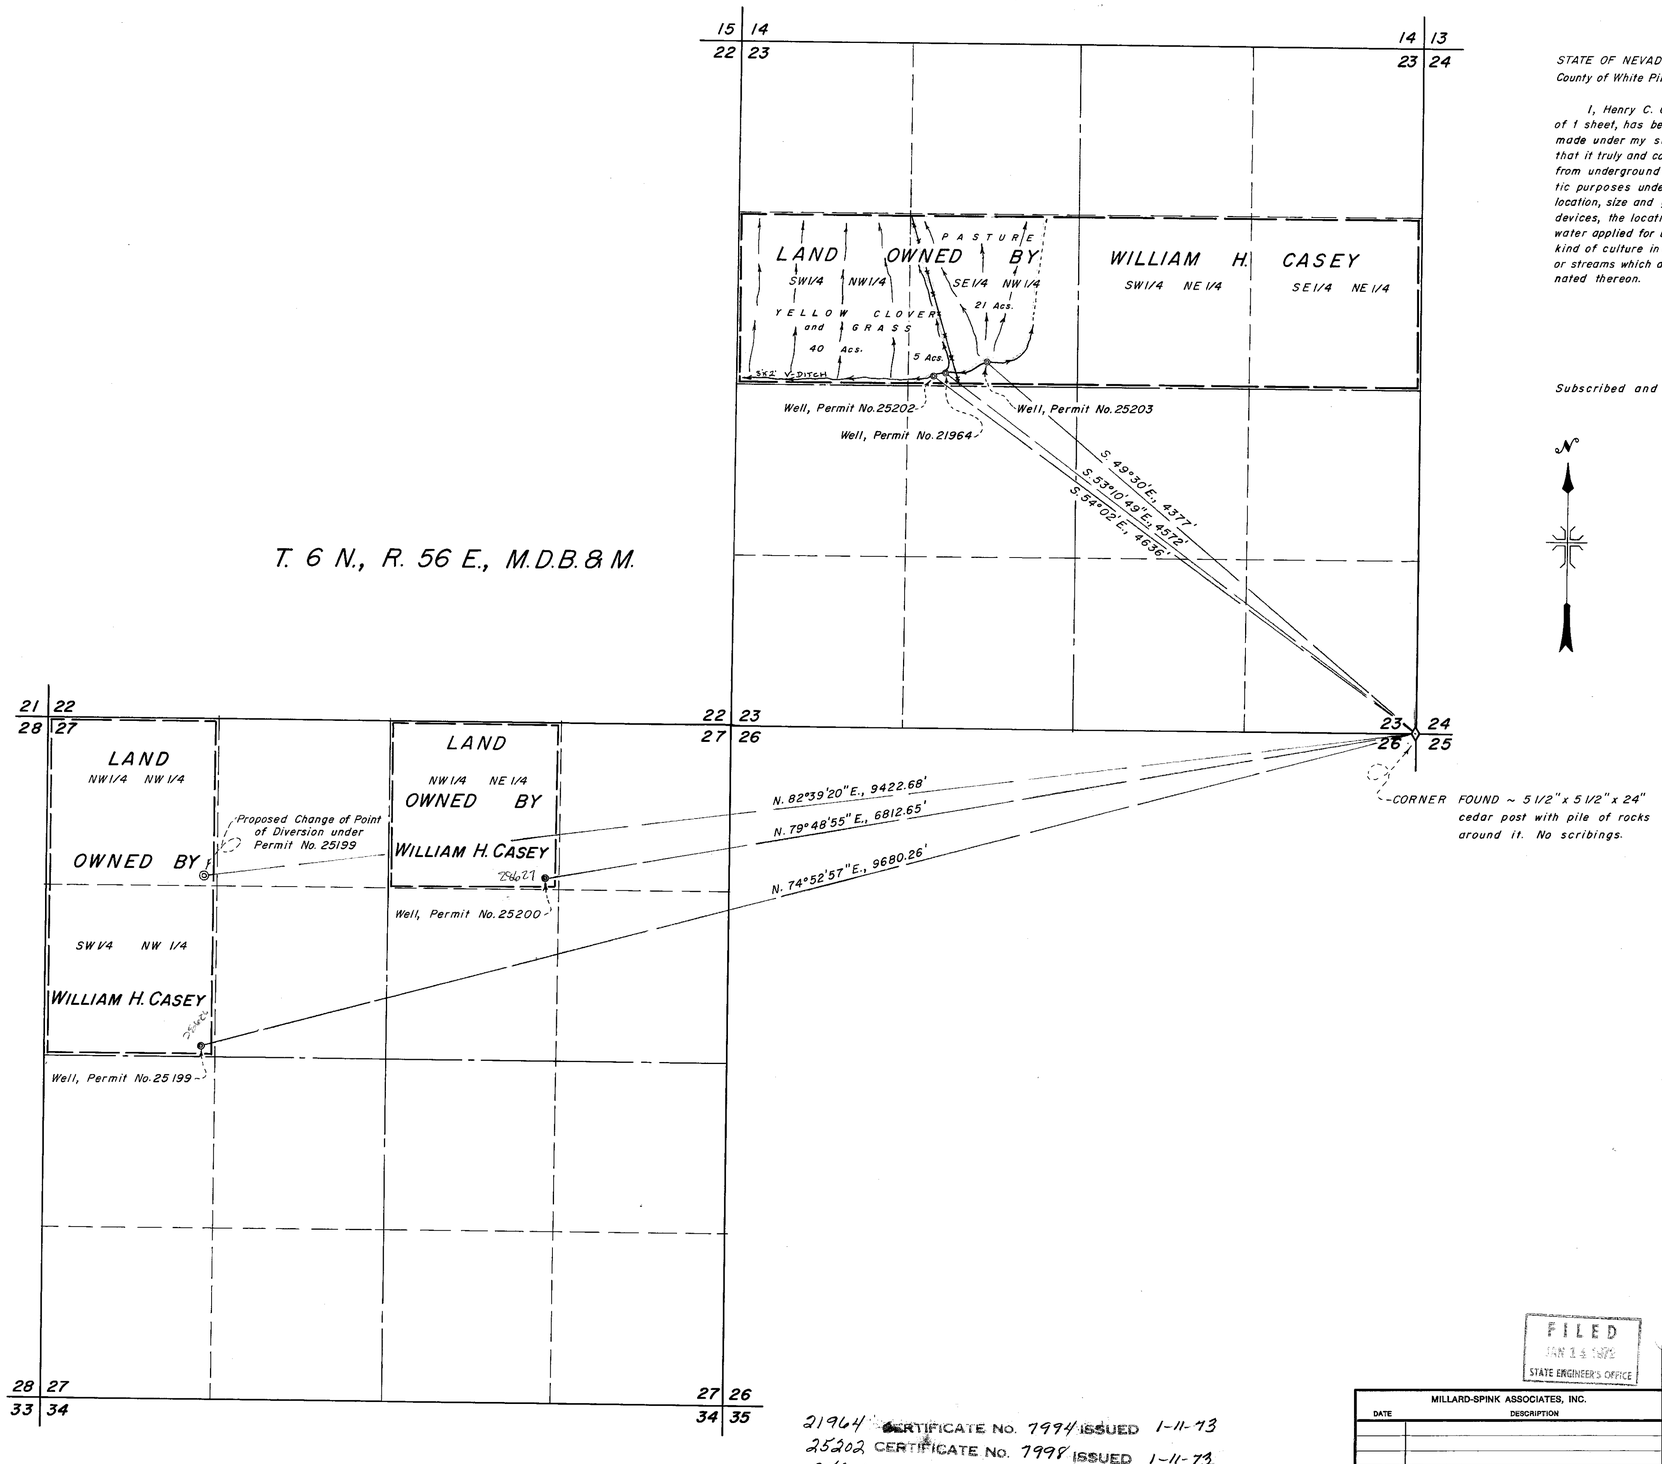

STATE OF NEVADA,
County of White Pine } s.s.

I, Henry C. Conrad, being first duly sworn, depose and say that this map consisting of 1 sheet, has been correctly drawn to the designated scale from field notes of a survey made under my supervision and direction between the 7th and 9th days of December, 1971, that it truly and correctly represents the location and extent of the works used to divert water from underground sources in Nye County by William H. Casey for irrigation and domestic purposes under permit No.'s 21964, 25202 & 25203. That the point of diversion, the location, size and grades of the diverting channel, location and description of all measuring devices, the location and extent of lands owned or controlled by the applicant upon which water applied for under permit No.'s 21964, 25202 & 25203 is used, together with the area and kind of culture in each 40-acre subdivision, and the location and names of all other works or streams which are crossed by or connected with said works are fully and correctly designated thereon.

Henry C. Conrad
State Water Right Surveyor

Subscribed and sworn to before me this 16th day of December, 1971.

Ingrid A. Flavish
Notary Public in and for White Pine County, Nevada.

INGRID A. FLAVISH
Notary Public - State of Nevada
White Pine County, Nevada
My commission expires July 1, 1972

N

0 600 1200 1800 2400
Scale 1" = 600'

FILED
JAN 14 1972
STATE ENGINEER'S OFFICE

21964 CERTIFICATE No. 7994 ISSUED 1-11-73
25202 CERTIFICATE No. 7998 ISSUED 1-11-73
25203 CERTIFICATE No. 7999 ISSUED 1-11-73

MILLARD-SPINK ASSOCIATES, INC.	
DATE	DESCRIPTION
FIELD H.C.C.	CHECK
DETAIL	APPROVED
DESIGN	FILE No.
TRACING I.A.K.	DR'G. No.

MAP TO ACCOMPANY PROOF OF BENEFICIAL USE UNDER PERMIT No's 21964, 25202 and 25203

FOR IRRIGATION & DOMESTIC (S)

BY WILLIAM H. CASEY

FROM UNDERGROUND SOURCES

MILLARD - SPINK ASSOCIATES, INC.
ENGINEERS - PLANNERS - SURVEYORS
ELY, NEVADA DEC. 16, 1971

I-812

76825 28627 28626 ~~25503~~ ~~25502~~ WHR 6/9/08 25203 25202 21964 26480 File under