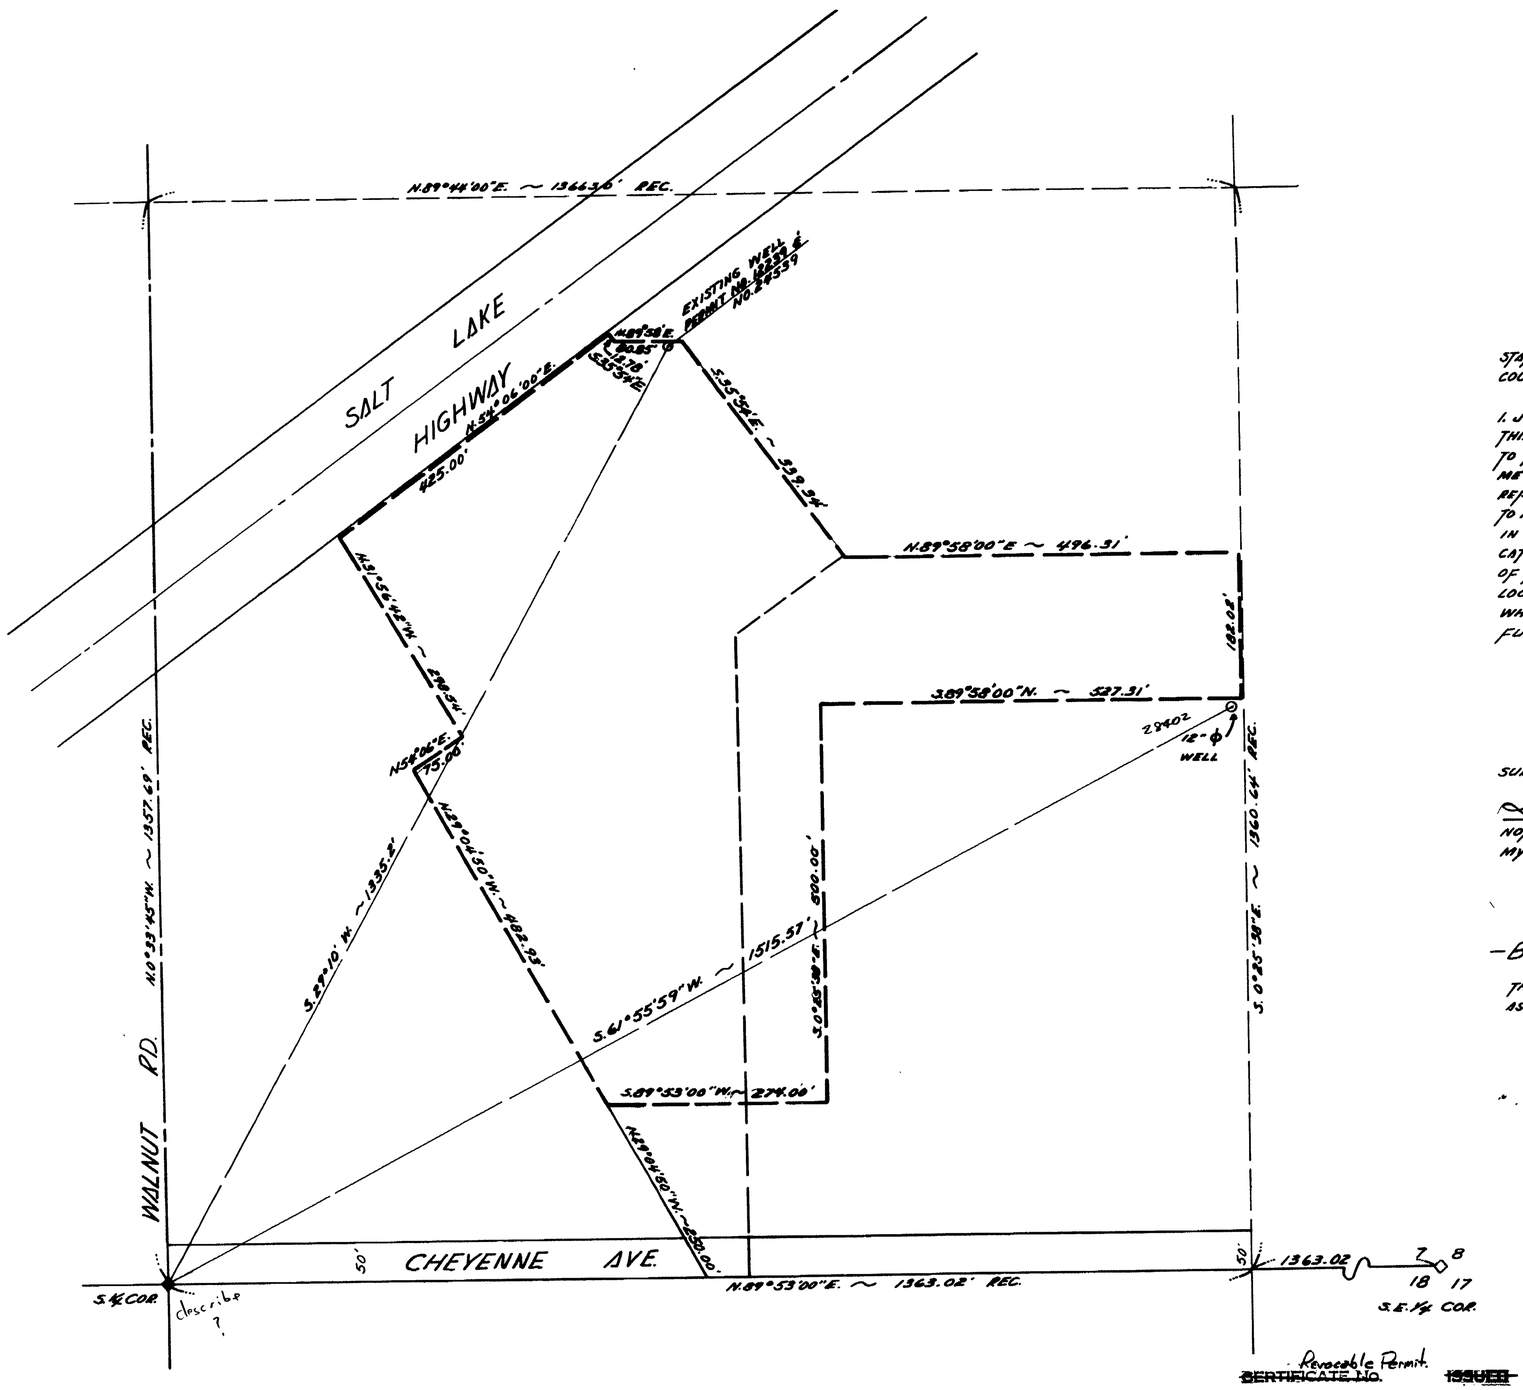

SCALE 1" = 100'

STATE OF NEVADA }
COUNTY OF CLARK } S.S.

I, JAY M. RASSLER, BEING FIRST DULY SWORN, DEPOSE AND SAY THAT THIS MAP, CONSISTING OF ONE SHEET, HAS BEEN CORRECTLY DRAWN TO THE DESIGNATED SCALE FROM FIELD NOTES OF A SURVEY MADE BY ME ON THE 24TH DAY OF MAY 1974; THAT IT TRULY AND CORRECTLY REPRESENTS THE PROPOSED LOCATION AND EXTENT OF THE WORKS USED TO DIVERT WATER FROM AN LAS VEGAS VALLEY UNDERGROUND BASIN IN CLARK COUNTY, NEVADA, BY STEWART BROTHERS COMPANY FOR APPLICATION TO CHANGE THE POINT OF DIVERSION AND APPLY FOR EXTENTION OF TIME; THAT THE PROPOSED POINT OF DIVERSION, THE APPROXIMATE LOCATION AND SIZE OF THE DIVERTING CHANNEL, AND ALL OTHER WORKS WHICH WILL CROSS OR CONNECT WITH THE PROPOSED WORKS, ARE FULLY AND CORRECTLY DESIGNATED HEREON.

Jay M. Rassler
JAY M. RASSLER, R.P.E.
STATE WATER RIGHTS SURVEYOR
Nº 431

SUBSCRIBED AND SWORN TO BEFORE ME THIS 31st DAY OF May, 1974.

NOTARY PUBLIC IN AND FOR CLARK COUNTY, NEVADA.
MY COMMISSION EXPIRES JAN. 28, 1977.

-BASIS OF BEARINGS-

THE SOUTH LINE OF THE S.W.¼ S.E.¼, SECTION 7, T.20S., R.62E., AS SHOWN ON FILE 3, PAGE 21, CLARK COUNTY RECORDS, NEVADA.

GRAPHIC SCALE IN HUNDREDS OF FEET

0 1 2 3 4 5

Revocable Permit.
~~CERTIFICATE NO.~~ ~~ISSUED~~

OFFICE
STATE E[illegible]
1974 MAY 10 PM 2 26

FILED
JUN 1 0 1974
STATE ENGINEER'S OFFICE

28402

MAP TO ACCOMPANY APPLICATION TO CHANGE POINT OF DIVERSION OF WATER FROM THE LAS VEGAS UNDERGROUND BASIN BY STEWART BROS. CO., CLARK COUNTY, NEV.

28402