CONTINUED

33	SW¼ SE¼	43N	37E	40.0*	ALFALFA	
"	SE¼ SE¼	"	"	37.9*	"	
"	NW¼ NW¼	"	"	39.1* → Besides of Pond reduce to 39.0		
"	NE¼ NW¼	"	"	39.1*	"	
"	SW¼ NW¼	"	"	39.4*	"	
"	SE¼ NW¼	"	"	39.4*	"	
"	NW¼ SW¼	"	"	39.1*	"	
"	NE¼ SW¼	"	"	39.4*	"	
"	SW¼ SW¼	"	"	38.5*	"	
"	SE¼ SW¼	"	"	39.1*	"	

~~486.46~~ TOTAL
98 ~~0.46~~
.0
486.46

486.46
.1
486.36

CULTURAL MAP TABULATION

SEC-TION	SUBDIVISION	TWN.	RGE.	CULTI-TED ACREAGE	DESCRIPTION OF CULTURE	DATE OF FIRST CULTURE
32	NE¼ SE¼	43N	37E	39.1*	ALFALFA	
"	NW¼ SE¼	"	"	40.0*	"	
"	SW¼ SE¼	"	"	40.0*	"	
"	SE¼ SE¼	"	"	36.6*	"	
34	SW¼ NW¼	"	"	39.4*	WHEAT	
"	NW¼ SW¼	"	"	39.4*	BARLEY	
4	NE¼ NE¼	42N	"	33.79*	WHEAT	
"	NW¼ NE¼	"	"	33.79*	"	
"	SW¼ NE¼	"	"	33.79*	"	
"	SE¼ NE¼	"	"	33.79	"	
33	NE¼ NE¼	43N	"	36.7*	ALFALFA	
"	NW¼ NE¼	"	"	39.1*	"	
"	SW¼ NE¼	"	"	39.1*	"	
"	SE¼ NE¼	"	"	36.7*	"	
"	NE¼ SE¼	"	"	35.4*	"	
"	NW¼ SE¼	"	"	38.8*	"	

CONTINUED

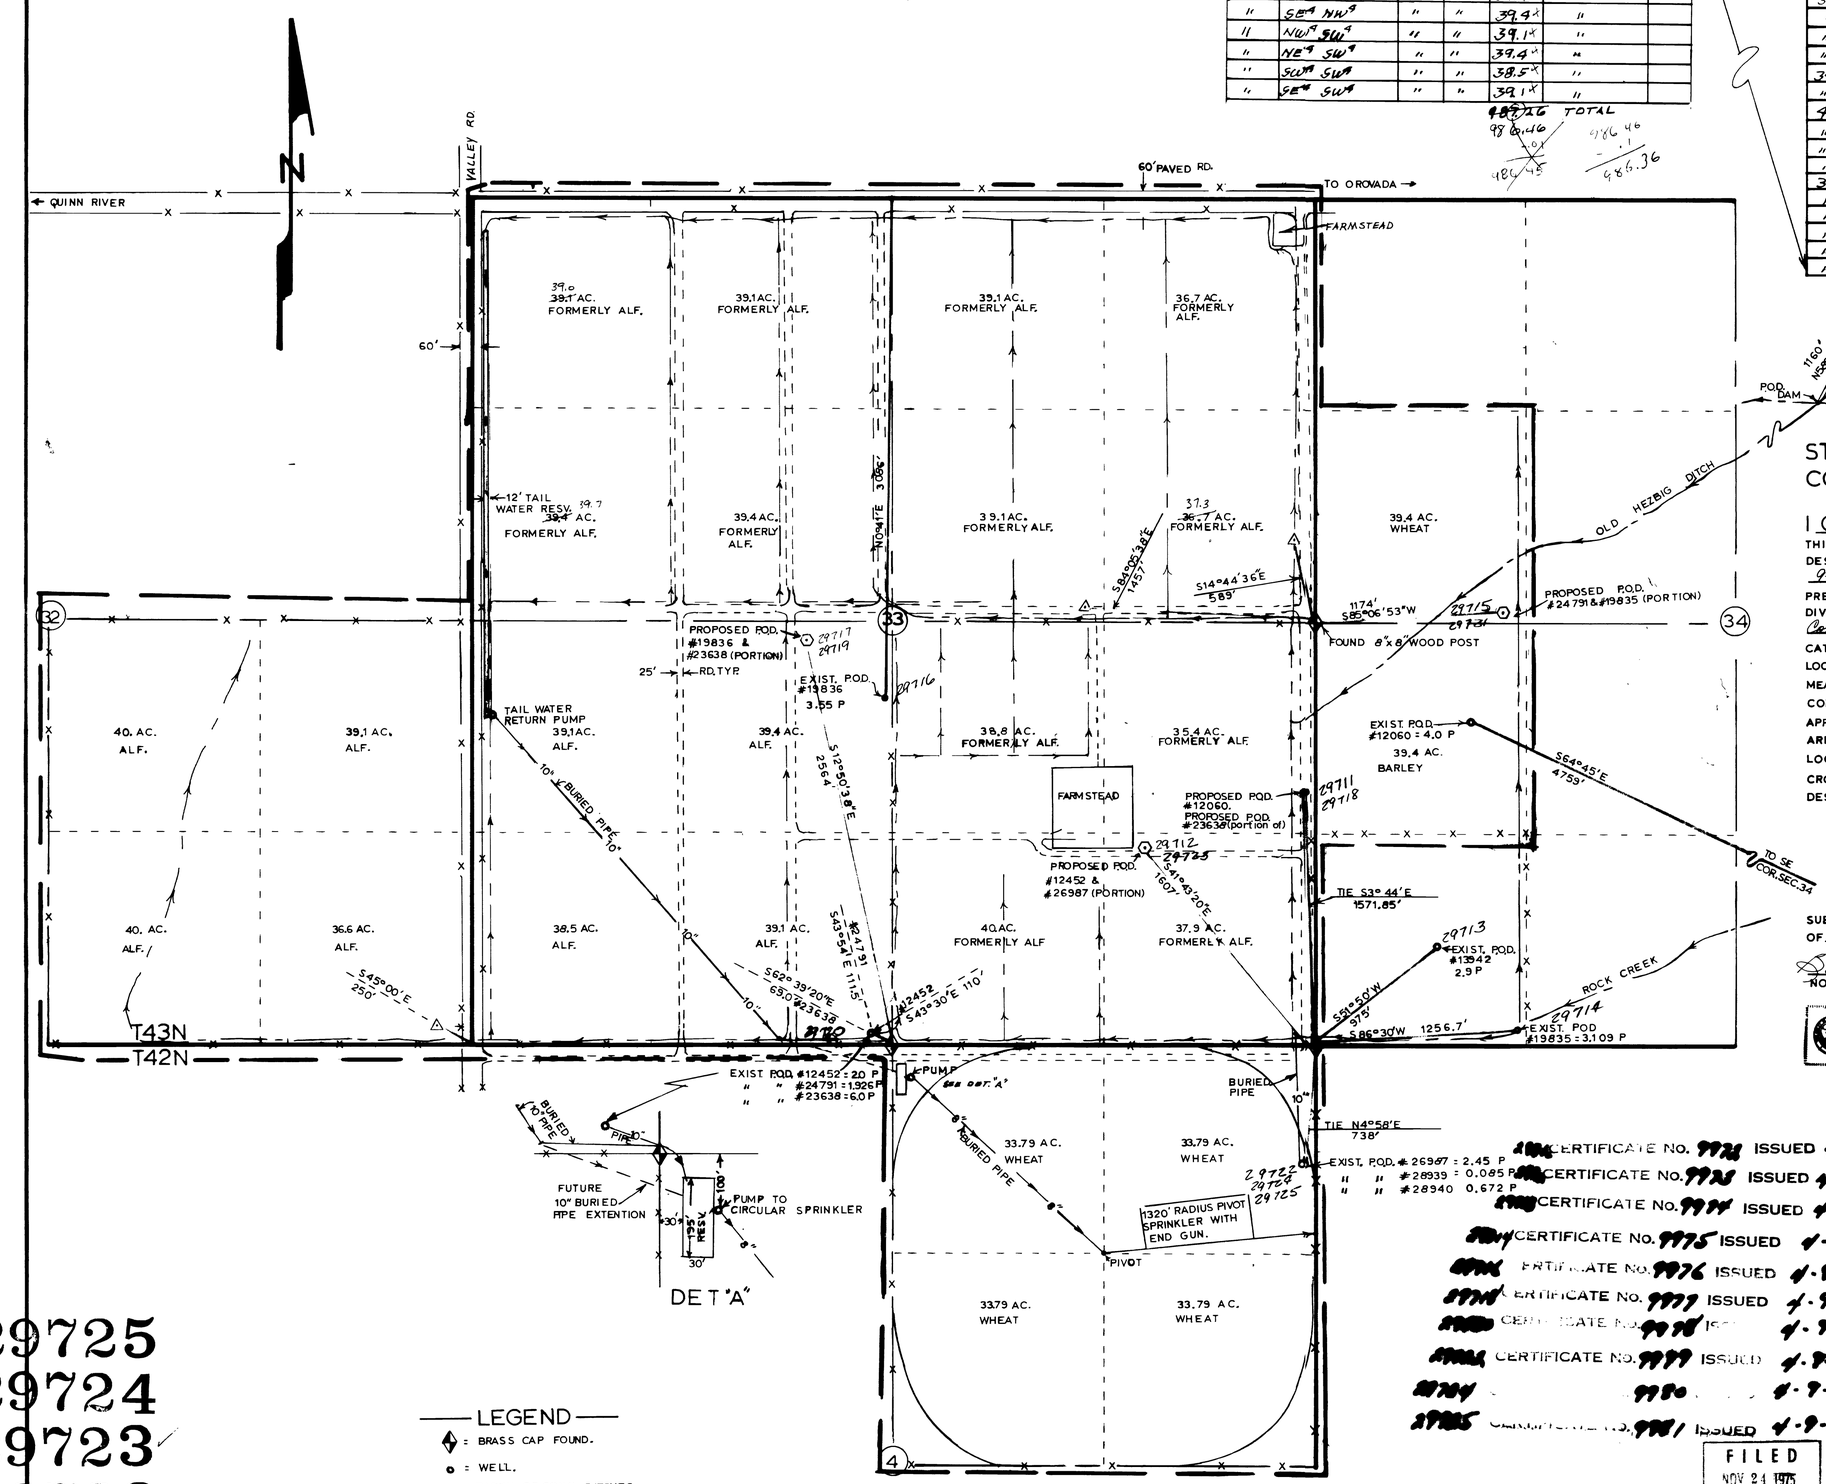

STATE OF NEVADA
COUNTY OF HUMBOLDT } S.S.

I C.H. KETCHAM, BEING FIRST DULY SWORN, DEPOSE AND SAY THAT THIS MAP, CONSISTING OF 1 SHEET, HAS BEEN CORRECTLY DRAWN TO THE DESIGNATED SCALE FROM FIELD NOTES OF A SURVEY MADE BY ME, ON THE 9-72 DAY OF 7-2, 1975; THAT IT TRULY AND CORRECTLY REPRESENTS THE PROPOSED LOCATION AND EXTENT OF THE WORKS USED TO DIVERT WATER FROM Underground & Rock Creek IN Humboldt COUNTY, BY Conn. Gen. Life Ins. Co. FOR Irrigation PURPOSES UNDER APPLICATION NO.(S) See title block. THAT THE POINT OF DIVERSION, THE LOCATION, SIZE OF DIVERTING CHANNEL, LOCATION AND DESCRIPTION OF ALL MEASURING DEVICES, THE LOCATION AND EXTENT OF LANDS OWNED OR CONTROLLED BY THE APPLICANT UPON WHICH WATER APPLIED FOR UNDER APPLICATION NO.(S) See title block IS USED, TOGETHER WITH THE AREA AND KIND OF CULTURE IN EACH 40-ACRE SUBDIVISION, AND THE LOCATION AND NAMES OF ALL OTHER WORKS OR STREAMS WHICH ARE CROSSED BY OR CONNECTED WITH SAID WORKS ARE FULLY AND CORRECTLY DESIGNATED THEREON.

C.H. Ketcham
STATE WATER-RIGHT SURVEYOR R.L.S. 3049

SUBSCRIBED AND SWORN TO BEFORE ME THIS 18th DAY OF August, 1975.

Barbara A. Ketcham
NOTARY PUBLIC HUMBOLDT COUNTY, NEVADA

BARBARA A. KETCHAM
Notary Public State of Nevada
Humboldt County
My Commission Expires March 12, 1979

CERTIFICATE NO. 9973 ISSUED 4-9-82
CERTIFICATE NO. 9974 ISSUED 4-9-82
CERTIFICATE NO. 9975 ISSUED 4-9-82
CERTIFICATE NO. 9976 ISSUED 4-9-82
CERTIFICATE NO. 9977 ISSUED 4-9-82
CERTIFICATE NO. 9978 ISSUED 4-9-82
CERTIFICATE NO. 9979 ISSUED 4-9-82
9980 4-9-82
CERTIFICATE NO. 9981 ISSUED 4-9-82

FILED
NOV 24 1975
STATE ENGINEER'S OFFICE

SCALE — 1" = 500'

LEGEND
◆ : BRASS CAP FOUND.
o : WELL.
→ : EARTH OR CONC. DITCHES.
P : PERMITTED FLOW C.F.S.
M : MEASURED FLOW C.F.S.
▬ : PROPOSED P.O.U.
△ : POSSIBLE WELL SITE.
⊙ : PROPOSED WELL.

MAP
TO ACCOMPANY APPLICATION TO CHANGE P.O.U. & P.B.U. #5441, 12060, 13942, 19835, 26987, 28939, 28940, 12452, 24791, 23638, 19836 & TO CHANGE P.O.D. 12060, CHG. Portion P.O.D. (0.21cfs) #23638

From: UNDERGROUND & ROCK CREEK
For: CONN. GEN. LIFE INS. CO. 8-15-75

C.H. "PETE" KETCHAM — REGISTERED LAND SURVEYORS
P.O. BOX 461 WINNEMUCCA, NEVADA

REV. 10-2-75
REV. 11-19-75

T42N & T43N R37E M.D.B.M.

29725 29724 29723 29722 29721 29720 29719 29718 29717 29716 29715 29714 29713 29712 29711 29710 ← File under