SECTION	SUBDIVISION	TOWNSHIP	RANGE	CULTIVATED ACREAGE	DESCRIPTION OF CULTURE
10	NW1/4 SE1/4	12 N.	20 E.	9.60	FAIRWAYS & GREENS
"	NE1/4 SE1/4	"	"	5.79	"
"	SE1/4 SE1/4	"	"	~~24.19~~ 12.81	"
"	SW1/4 SE1/4	"	"	9.17	"
15	NE1/4 NE1/4	"	"	19.20	"
"	NW1/4 NE1/4	"	"	.07	"
"	SE1/4 NE1/4	"	"	12.01	"
14	SW1/4 NW1/4	"	"	5.64	"
TOTAL ACREAGE				~~85.67~~ 77.29	

PORTION OF

SEC. 10, 14 & 15 T. 12 N., R. 20 E., M.D.B. & M.

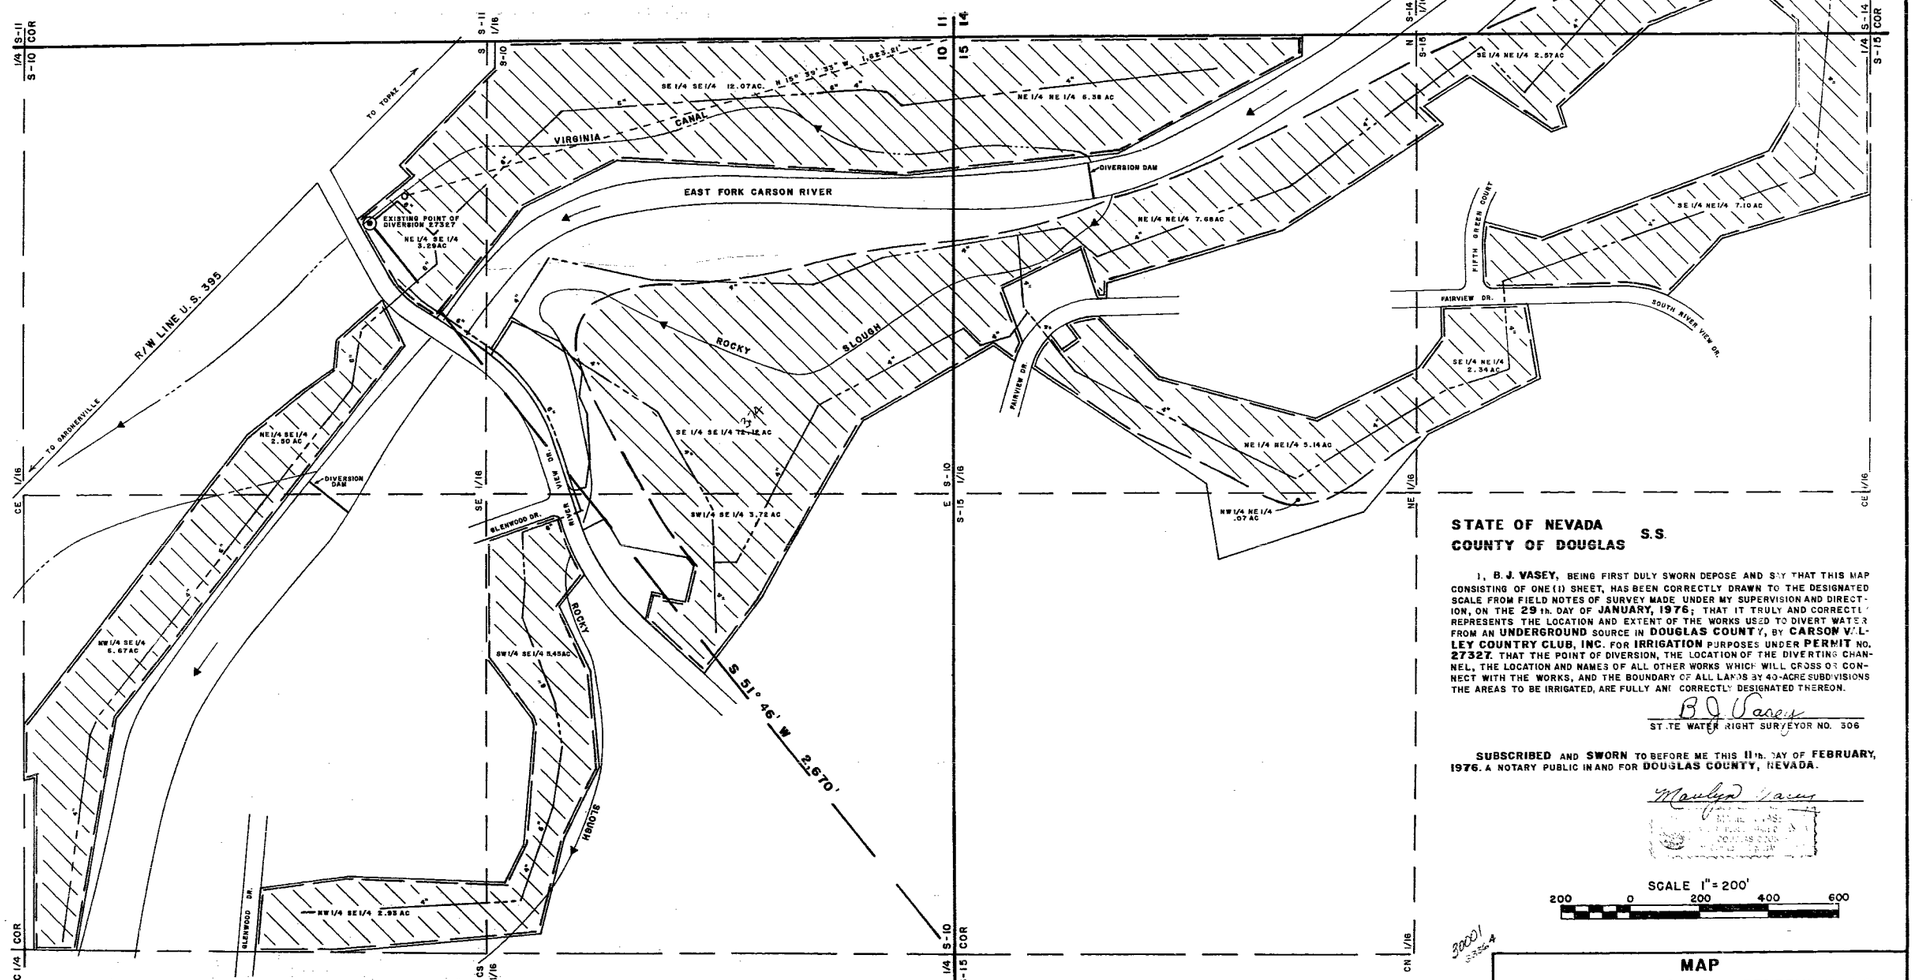

STATE OF NEVADA
COUNTY OF DOUGLAS S.S.

I, **B. J. VASEY,** BEING FIRST DULY SWORN DEPOSE AND SAY THAT THIS MAP CONSISTING OF ONE (1) SHEET, HAS BEEN CORRECTLY DRAWN TO THE DESIGNATED SCALE FROM FIELD NOTES OF SURVEY MADE UNDER MY SUPERVISION AND DIRECTION, ON THE **29** TH. DAY OF **JANUARY, 1976;** THAT IT TRULY AND CORRECTLY REPRESENTS THE LOCATION AND EXTENT OF THE WORKS USED TO DIVERT WATER FROM AN **UNDERGROUND** SOURCE IN **DOUGLAS COUNTY,** BY **CARSON VALLEY COUNTRY CLUB, INC.** FOR **IRRIGATION** PURPOSES UNDER **PERMIT** NO. **27327.** THAT THE POINT OF DIVERSION, THE LOCATION OF THE DIVERTING CHANNEL, THE LOCATION AND NAMES OF ALL OTHER WORKS WHICH WILL CROSS OR CONNECT WITH THE WORKS, AND THE BOUNDARY OF ALL LANDS BY 40-ACRE SUBDIVISIONS THE AREAS TO BE IRRIGATED, ARE FULLY AND CORRECTLY DESIGNATED THEREON.

B J Vasey
STATE WATER RIGHT SURVEYOR NO. 306

SUBSCRIBED AND **SWORN** TO BEFORE ME THIS 11TH. DAY OF **FEBRUARY, 1976.** A NOTARY PUBLIC IN AND FOR **DOUGLAS COUNTY, NEVADA.**

Marilyn Vasey

SCALE 1" = 200'

200 0 200 400 600

NOTE:
IRRIGATION OF GOLF COURSE, BY SPRINKLER SYSTEM

LEGEND:
PLACE OF USE
SPRINKLER SYSTEM
MAIN LINES

BASIS OF BEARING:
NORTH RIGHT OF WAY LINE DRESSLERVILLE ROAD GARDNERVILLE RANCHOS UNIT NO. 1

FILED
FEB 17 1976
STATE ENGINEER

30001 CERTIFICATE NO. 10669 ISSUED 6/1/73

33364 CERTIFICATE NO. 10674 ISSUED 6/1/73

VASEY-SCOTT ENGINEERING CO. INC.
2989 HWY 50 EAST
CARSON CITY, NEVADA 89701
702/883:1600

MAP
TO SUPPORT THE PROOF OF BENEFICIAL USE AND TO ACCOMPANY APPLICATION TO CHANGE THE PLACE OF USE
UNDER
PERMIT 27327
BY
CARSON VALLEY COUNTRY CLUB INC.
FROM AN **UNDERGROUND** SOURCE
FOR **IRRIGATION** PURPOSES **GOLF COURSE**
IN **DOUGLAS COUNTY, NEVADA**

33364 30001