SECTIONS 15, 16 & 21
TOWNSHIP 4 SOUTH, RANGE 36 EAST, M.D.B.&M.
ESMERALDA COUNTY, NEVADA

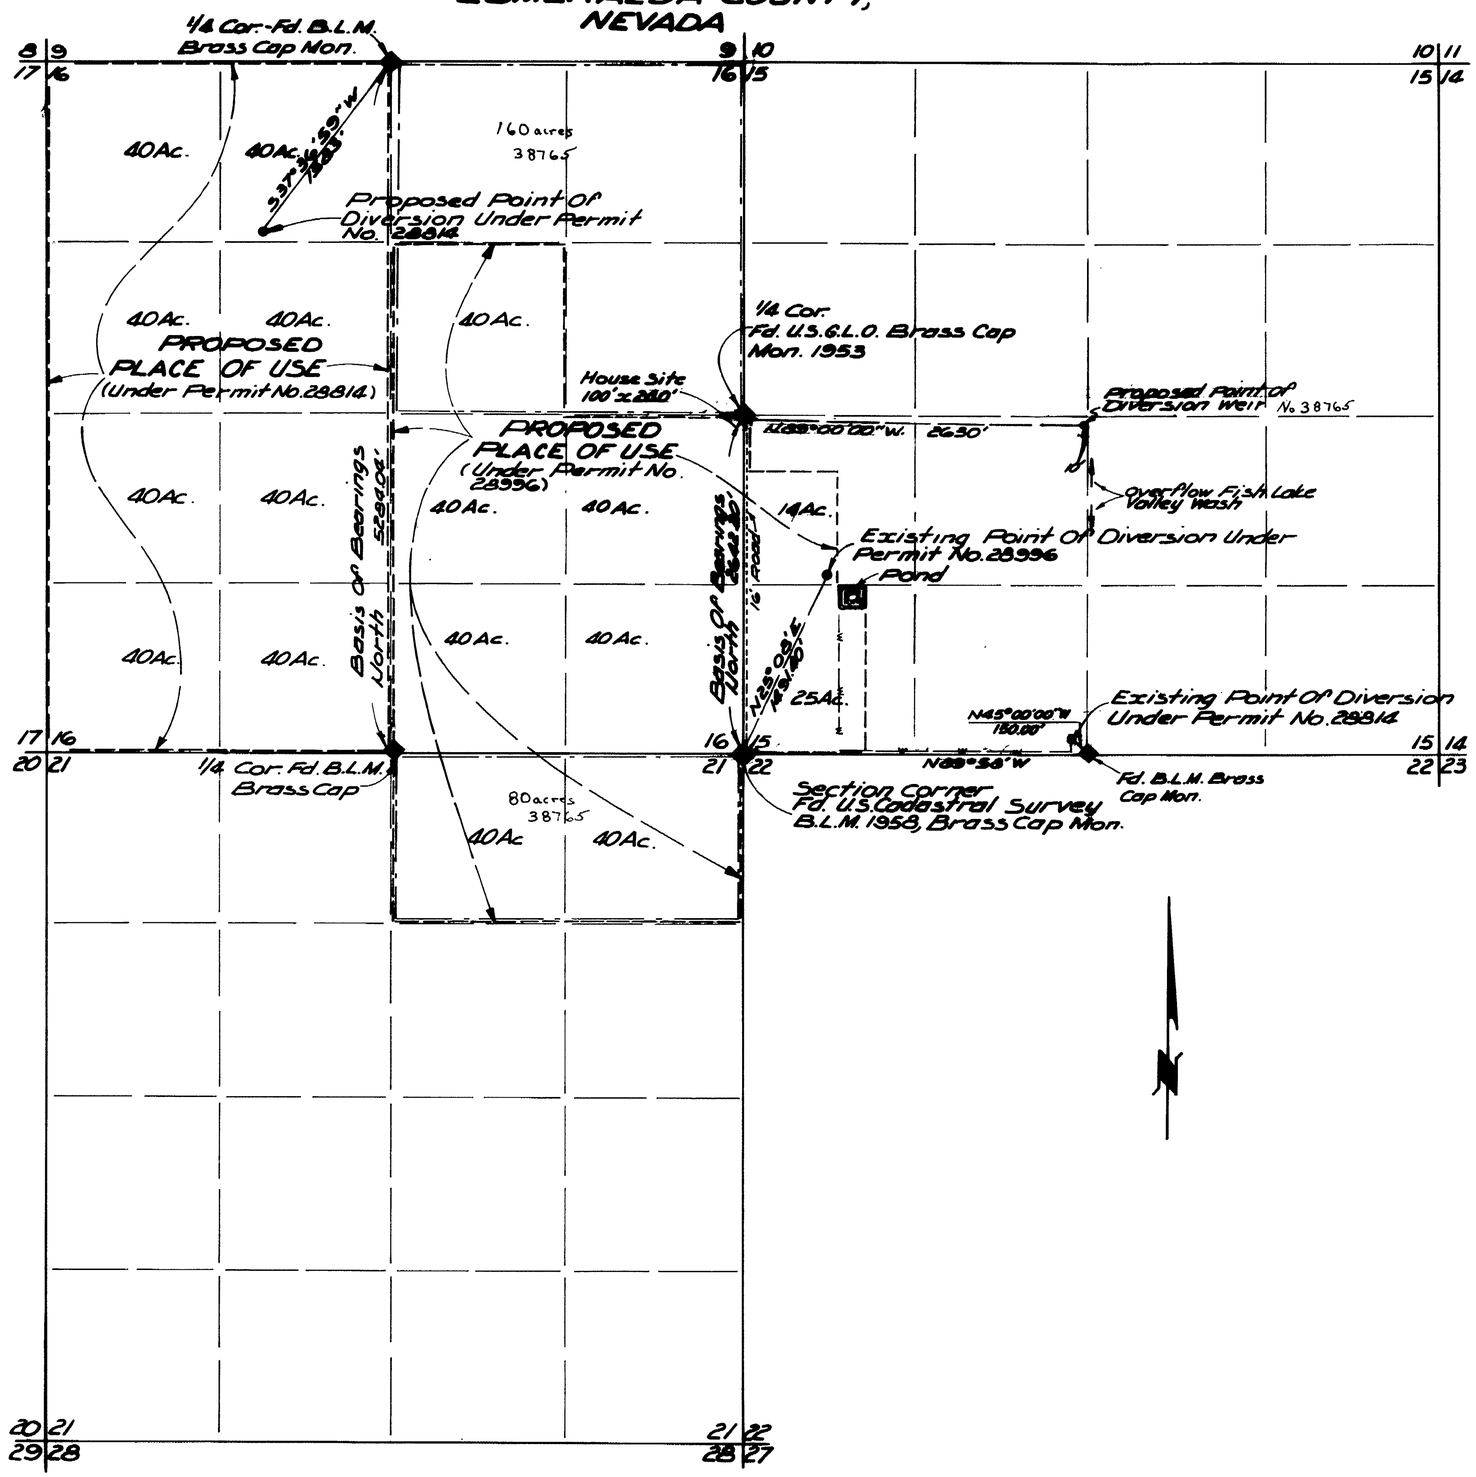

STATE OF NEVADA
County Of Esmeralda } SS

I, Roger D. Glidden, being first duly sworn, depose and say that this map, consiting of one sheet, has been correctly drawn to the designated scale from field notes of a survey made under my supervision and direction between the 5th day of January, and the 7th day of January 1979; that it truly and correctly represents the proposed location and extent of the works used to divert water from Underground Sources, in Esmeralda County, by James P. Wallace for Irrigation and Domestic purposes. Under Application [redacted] and Application [redacted]. That the proposed point of diversion, the approximate location and size of the diverting channel, all resivoirs or basins, the location and names of all other work which will cross or connect with the proposed works, and the boundary of all lands, showing by 40-acre subdivisions the areas proposed to be irrigated, are fully and correctly designated thereon.

Roger D. Glidden
State Water Right Surveyor

Subscribed and sworn to before me this 15th day of January 1979.

Janet L. Glidden
Notary Public In and for Inyo County, California.

JANET L. GLIDDEN
Commission Expires 1980

0 500 1000 1500 2000 2500
Scale 1" = 600'

FILED
DEC 12 1979
STATE ENGINEER'S OFFICE

Prepared By
GLIDDEN ENGINEERING
[redacted] Bishop, Ca.
[redacted]

MAP TO ACCOMPANY
[redacted]
Application for
~~PLACE OF USE~~
~~AND~~
Permission To ~~Change Point Of Diversion~~ Appropriate water
Agent: JAMES P. WALLACE
for: V. IRENE WALLACE
From: UNDERGROUND SOURCES & SURFACE SOURCES (Fish Lake Valley Wash)

38765