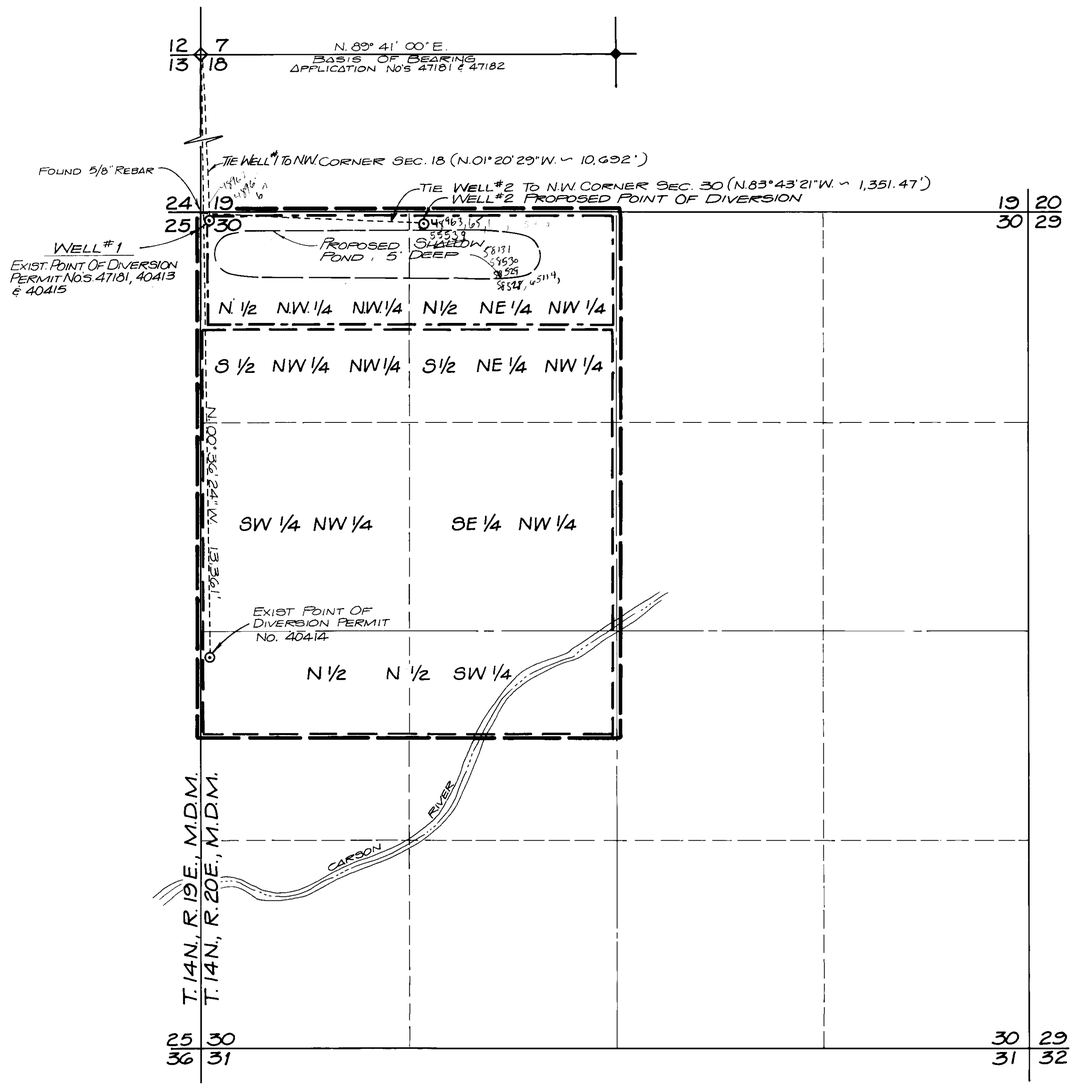

STATE OF NEVADA }
COUNTY OF WASHOE } SS.

I, BARRY W. HICKERSON, BEING FIRST DULY SWORN DEPOSE AND SAY THAT THIS MAP CONSISTING OF ONE SHEET HAS BEEN CORRECTLY DRAWN TO THE DESIGNATED SCALE MADE UNDER MY SUPERVISION AND DIRECTION BETWEEN THE 18TH DAY OF MARCH AND THE 22ND DAY OF MARCH, 1985; THAT IT DULY AND CORRECTLY REPRESENTS THE PROPOSED LOCATION AND EXTENT OF THE WORKS USED TO DIVERT WATER FROM UNDERGROUND SOURCES IN DOUGLAS COUNTY, BY THEODORE H. STOKES FOR COMMERCIAL FISH RAISING PURPOSES, QUASI-MUNICIPAL AND RECREATIONAL PURPOSES. THAT THE PROPOSED POINT OF DIVERSION AND THE BOUNDARY OF ALL LANDS, SHOWING BY 40-ACRE SUBDIVISIONS THE AREA TO BE USED, ARE FULLY AND CORRECTLY DESIGNATED THEREON.

Barry W. Hickerson
BARRY W. HICKERSON
STATE WATER RIGHTS SURVEYOR No. 593

SUBSCRIBED AND SWORN TO BEFORE ME THIS 1ST DAY OF April 1985.
NOTARY PUBLIC IN AND FOR THE COUNTY OF WASHOE, NEVADA.

DONNA L. CHOUTEAU
Notary Public - State of Nevada
Washoe County

Donna L. Chouteau
NOTARY PUBLIC

NOTES:

(1) WELL TIE INFORMATION AND BASIS OF BEARING TAKEN FROM MAP TO ACCOMPANY APPLICATION No's. 47181 AND 47182.

(2) THE PURPOSE OF THIS MAP IS TO:
- A - PERMIT No. 40413 - CHANGE PLACE OF USE.
- B - PERMIT No. 40414 - CHANGE PLACE OF USE AND POINT OF DIVERSION
- C - PERMIT No. 40415 - CHANGE PLACE OF USE
- D - PERMIT No. 47181 - CHANGE PLACE OF USE AND POINT OF DIVERSION

SCALE: 1" = 500'

0 250 500 1000 1500 2000

LEGEND

- EXIST. PLACE OF USE PERMIT No's 47181 & 40415
- EXIST. PLACE OF USE PERMIT No's 40413 & 40414
- PROPOSED PLACE OF USE

48962 Jan. 48967

MAP TO ACCOMPANY APPLICATION
BY
THEODORE H. STOKES
TO APPROPRIATE WATER AND
TO CHANGE THE POINT OF DIVERSION
AND PLACE OF USE
OF PERMIT Nos 40413, 40414, 40415 & 47181
FROM AN UNDERGROUND SOURCE

FILED
APR 04 1985
STATE ENGINEER'S OFFICE

TRI-STATE SURVEYING
1150 CORPORATE BLVD.
RENO, NEVADA 89502

DATE: MARCH 1985
SHEET 1 OF 1

84000
83999
83998
83997
83996
~~78201~~
~~78200~~
~~78199~~
~~78198~~
76309T
74763 T
73122T
68890
68339
67951

66867T 65114 64996T 63108T 60103T 58530 58528 58131 55539 54101 48967 48966 48965 48964 48963 48962