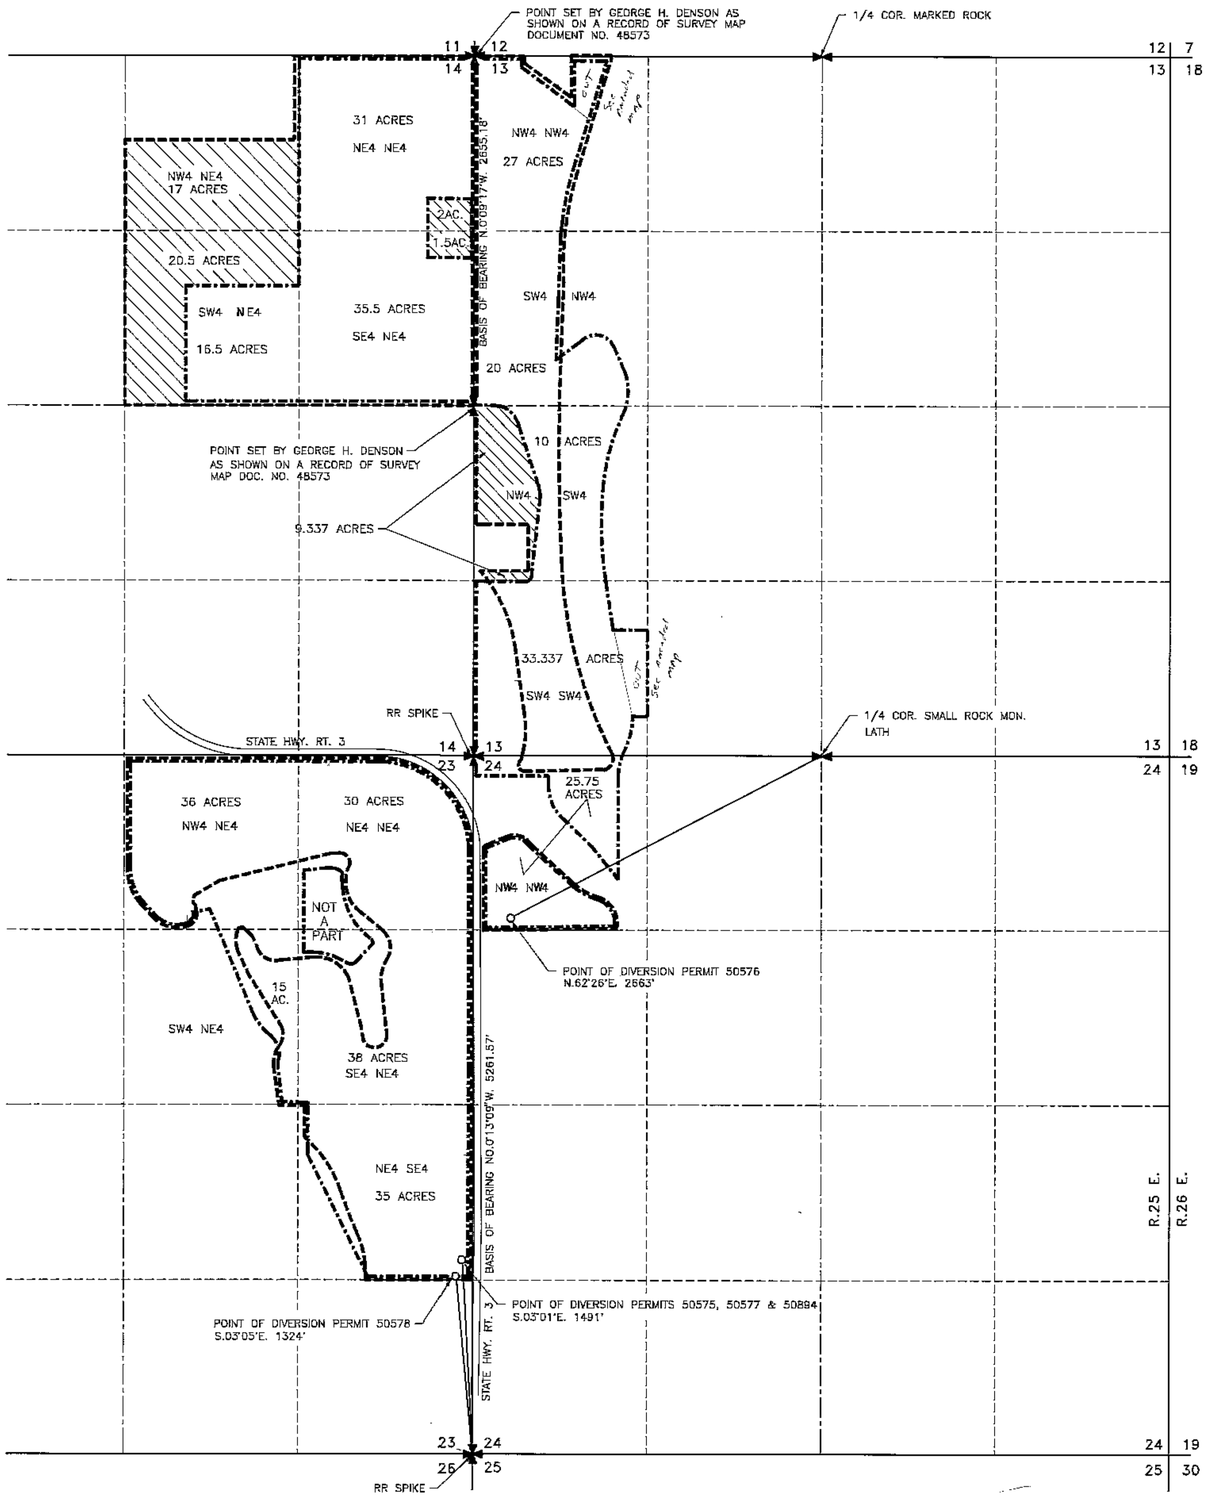

T.12 N., R.25 E., M.D.B.& M.

CULTURAL MAP TABULATION						
SECTION	SUBDIVISION	TOWNSHIP	RANGE	CULTIVATED ACREAGE	DESCRIPTION OF CULTURE *	DATE OF FIRST CULTURE **
13	NW4 NW4	T.12 N.	R.25 E.	~~27~~ AC. 20	NONE	———
13	SW4 NW4	T.12 N.	R.25 E.	20 AC.	ALFALFA & GRAIN	1985 (Partial)
13	NW4 SW4	T.12 N.	R.25 E.	10 AC.	"	"
13	SW4 SW4	T.12 N.	R.25 E.	~~33.337~~ AC. 39	"	1985 (Partial)
14	NE4 NE4	T.12 N.	R.25 E.	31 AC.	NONE	———
14	SE4 NE4	T.12 N.	R.25 E.	35.5 AC.	NONE	———
14	SW4 NE4	T.12 N.	R.25 E.	16.5 AC.	NONE	———
23	NW4 NE4	T.12 N.	R.25 E.	36 AC.	ALFALFA & GRAIN	1985
23	NE4 NE4	T.12 N.	R.25 E.	30 AC.	"	"
23	SW4 NE4	T.12 N.	R.25 E.	15 AC.	"	"
23	SE4 NE4	T.12 N.	R.25 E.	38 AC.	"	"
23	NE4 SE4	T.12 N.	R.25 E.	35 AC.	"	"
24	NW4 NW4	T.12 N.	R.25 E.	25.75 AC.	"	"

TOTAL ACREAGE=353.087 AC.

* PERMITTEE ALTERNATES BETWEEN ALFALFA AND GRAIN

** DATE OF FIRST CULTURE BY CURRENT OWNER

STATE OF NEVADA

CARSON CITY S.S.

I, BRUCE R. SCOTT, BEING FIRST DULY SWORN, DEPOSE AND SAY THAT THIS MAP, CONSISTING OF ONE SHEET, HAS BEEN CORRECTLY DRAWN TO THE DESIGNATED SCALE, FROM RECORD INFORMATION ON FILE AT THE DIVISION OF WATER RESOURCES AND FIELD NOTES OF A SURVEY MADE UNDER MY SUPERVISION ON THE 14TH DAY OF JULY, 1988; THAT IT TRULY AND CORRECTLY REPRESENTS THE PROPOSED LOCATION AND EXTENT OF THE WORKS USED TO DIVERT WATER FROM UNDERGROUND SOURCES IN LYON COUNTY, NEVADA BY HAMLETT GROUP LTD. PARTNERSHIP, FOR IRRIGATION AND DOMESTIC PURPOSES; THAT THE PROPOSED POINTS OF DIVERSION AND THE BOUNDARY OF ALL LANDS SHOWING BY 40-ACRE SUBDIVISIONS ARE FULLY AND CORRECTLY SHOWN HEREON.

Bruce R. Scott 7/3/91

STATE WATER RIGHT SURVEYOR NO. 427

SUBSCRIBED AND SWORN TO BEFORE ME THIS 3rd DAY OF July, 1991.
NOTARY PUBLIC IN AND FOR CARSON CITY, NEVADA.

Carol L. Walton

CAROL L. WALTON
NOTARY PUBLIC NEVADA
CARSON CITY
My Appt. Expires Jan 1, 1994

BASIS OF BEARING:
BASED ON A RECORD OF SURVEY MAP ON FILE AT THE LYON COUNTY RECORDER DOCUMENT NO. 48573.

N.0°09'17"W. FOR POINT OF DIVERSION UNDER PERMIT 50576.
N.0°13'09"W. FOR POINTS OF DIVERSION UNDER PERMITS 50575, 50577, 50578 & 50894.

LEGEND

EXISTING PLACE OF USE

PROPOSED PLACE OF USE

ACREAGE TO BE STRIPPED FOR TRANSFER TO PROPOSED PLACE OF USE, TOTAL ACRES=50.337 ACRES

0 600 1200 1800 FEET

SCALE: 1" = 600' 56594-99

56594 CERTIFICATE NO. 14202 ISSUED 9-7-95
56595 CERTIFICATE NO. 14203 ISSUED 9-7-95
56596 CERTIFICATE NO. 14204 ISSUED 9-7-95
56597 CERTIFICATE NO. 14205 ISSUED 9-7-95
56598 CERTIFICATE NO. 14206 ISSUED 9-7-95
56599 CERTIFICATE NO. 14207 ISSUED 9-7-95

'91 JUL 26 P2:54
STATE ENGINEER'S OFFICE

FILED
JUL 26 1991
STATE ENGINEER'S OFFICE

MAP
TO ACCOMPANY APPLICATIONS TO CHANGE THE PLACE USE OF PERMITS 50575,50576,50577,50578 & 50894 AND THE POINT OF DIVERSION OF A PORTION OF PERMIT 50575
BY

HAMLETT GROUP LTD. PARTNERSHIP

FOR IRRIGATION AND DOMESTIC PURPOSES
FROM UNDERGROUND SOURCES IN LYON COUNTY, NEVADA

RESOURCE CONCEPTS INC.
340 North Minnesota Street, Carson City, Nevada 89703-4152 (702) 883-1600
ENGINEERING • PLANNING • RESOURCE MANAGEMENT

REVISION

JOB. NO 87-019-01
DATE 6-24-91
DRAWN BY MLM

Sheet 1 of 1

85420
85419
T
85233T
82680
82679
82678
82677
82676
82675

81855T 81853T 81852T 81851T 81850T 81849T 77075 77074 77073 77072 77071 77070 56599 56598 56597 56596 56595 56594