82266T 82851T ~~83334T~~ 83335T
~~83334T~~
81256T
80887T 81984T
80161
79871 T
79566T
78879T
78146T
77936T
77935T
77766T
77755T
77507T
77041T
76601
~~76598~~
76718T
76717T
76716T
76620T
76520T
76415T
76407T
75659T
75370T
75368T
74782T
74781T
74169T
73774T
73770T
73025T
73024T
72262T
72224T
71213T
70667T
70566T
~~[illegible]~~
70538T
70667T
70203T
69677T
69674T

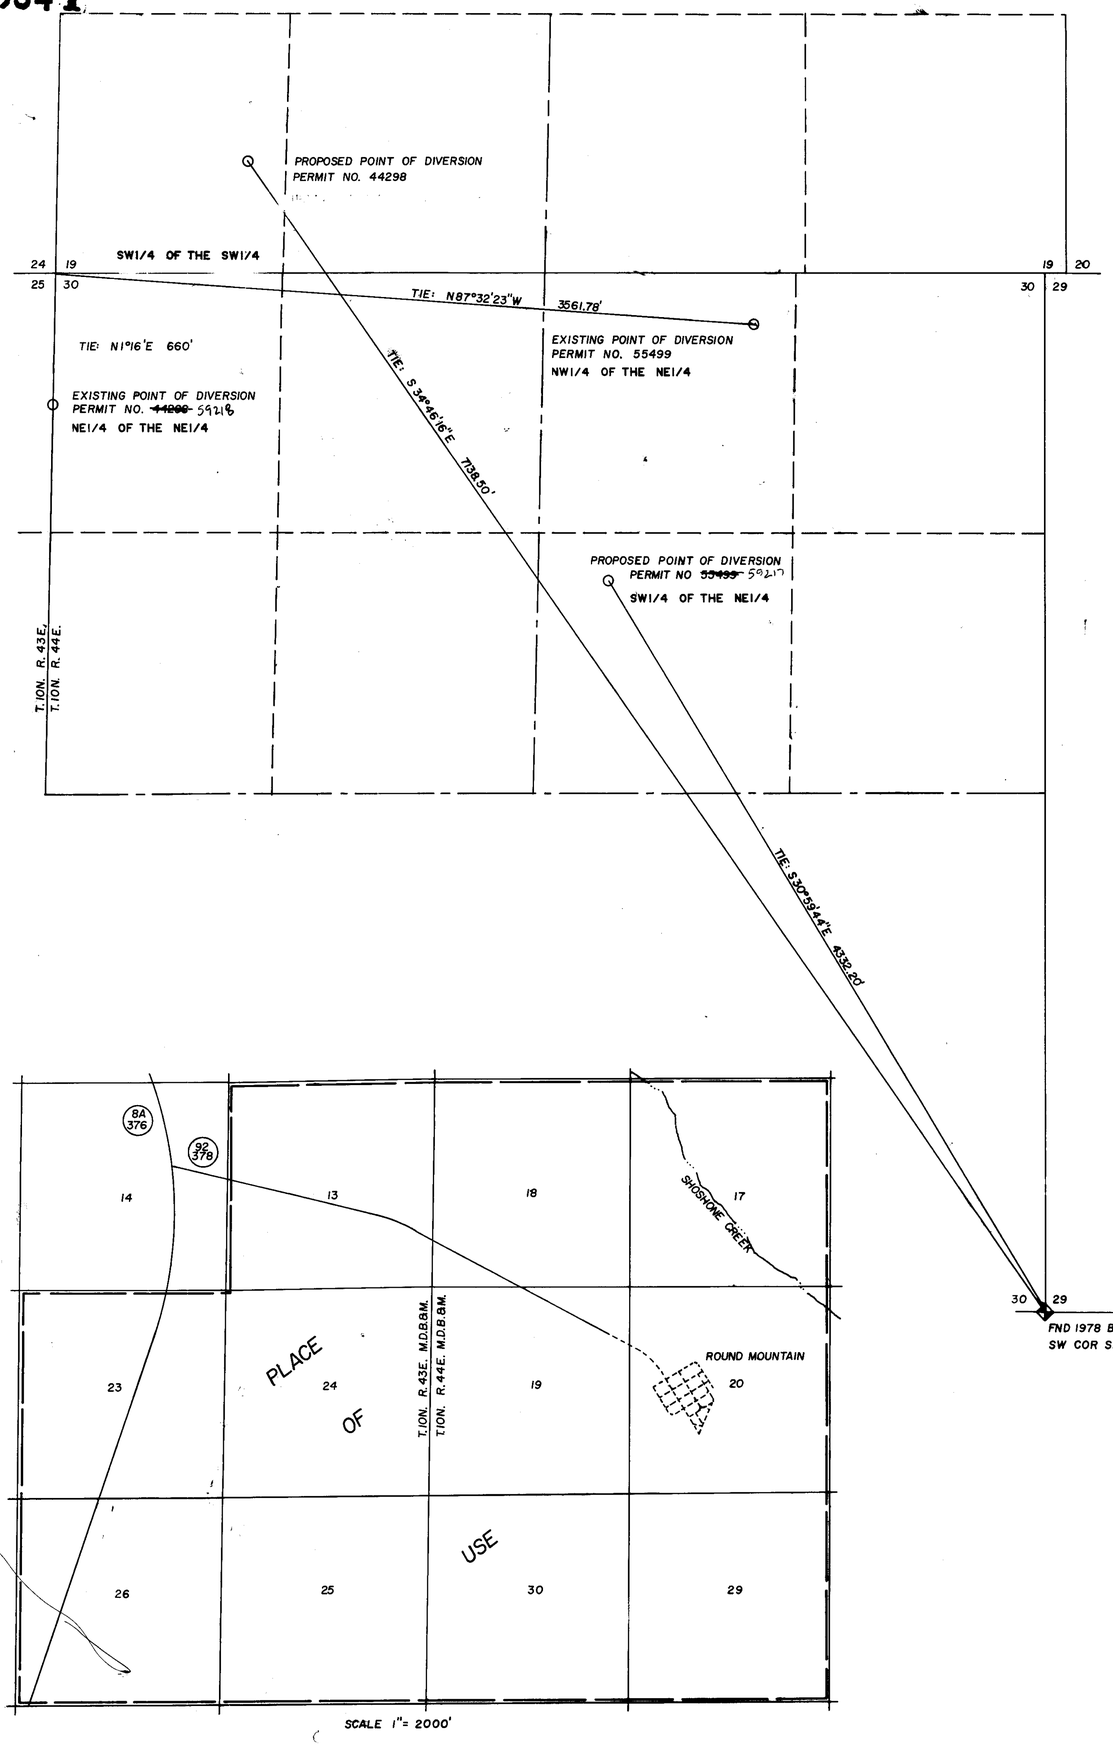

N

BASIS OF BEARING

WEST ALONG THE SOUTH LINE OF THE SW 1/4 OF SECTION 29, T.10N., R.44E., M.D.B.&M. AS PER THE G.L.O. PLAT APPROVED 6/29/81

30 29 WEST 2640.83'

FND 1978 BRASS CAP B.L.M.
SW COR SEC 29

FND. 1978 BRASS CAP B.L.M.
S 1/4 COR SEC 29

ACREAGE TABULATION						
SECTION	TOWN-SHIP	RANGE	SUBDIVISION	EXISTING ACREAGE OF USE	PROPOSED ACREAGE OF USE	DUTY AC.-FT.

MAP
TO ACCOMPANY APPLICATION TO CHANGE THE POINT OF DIVERSION
OF PERMIT NO. 44298 AND PERMIT NO. 55499

STATE OF NEVADA
COUNTY OF CHURCHILL

I, LOWELL D. EMERY, BEING FIRST DULY SWORN DEPOSE AND SAY THAT THIS MAP, CONSISTING OF 1 SHEETS, NUMBERED 1 TO 1 INCLUSIVE, HAS BEEN CORRECTLY DRAWN TO THE DESIGNATED SCALE FROM FIELD NOTES OF A SURVEY MADE BY ME OR UNDER MY SUPERVISION AND DIRECTION, BETWEEN THE 1st DAY OF DECEMBER, AND THE 1st DAY OF DECEMBER, 1993; THAT IT TRULY AND CORRECTLY REPRESENTS THE PROPOSED LOCATION AND EXTENT OF THE WORKS USED TO DIVERT WATER FROM AN UNDERGROUND SOURCE IN NYE COUNTY, BY ROUND MOUNTAIN GOLD INC. FOR MINING, MILLING, & DOMESTIC PURPOSES. THAT THE PROPOSED POINT OF DIVERSION, THE APPROXIMATE LOCATION AND SIZE OF THE DIVERTING CHANNEL OR OTHER CONDUIT, THE PLACE AND MANNER OF USE, AND THE LOCATION AND NAMES OF ALL OTHER WORKS OR STREAMS WHICH ARE CROSSED BY OR CONNECTED WITH THE SAID WORKS, ARE FULLY AND CORRECTLY DESIGNATED THEREON.

PROFESSIONAL LAND SURVEYOR, STATE OF NEVADA
LOWELL D. EMERY
12-10-93
No. 1261

Lowell D. Emery PLS / S.W.R.S
LOWELL D. EMERY SWRS 536

ON THIS 10TH DAY OF DEC., 1993, LOWELL D. EMERY PERSONALLY APPEARED BEFORE ME, A NOTARY PUBLIC, WHO ACKNOWLEDGED THAT HE EXECUTED THE ABOVE INSTRUMENT

RICHARD G. KUJALA
Notary Public - State of Nevada
Appointment Recorded in Churchill County
MY APPOINTMENT EXPIRES MAY 5, 1997

Richard G. Kujala
NOTARY PUBLIC

STATE ENGINEER'S OFFICE
'93 DEC 20 P3:50

SCALE 1"= 400'
0 400 800 1200 1600

59217 59218

FILED
DEC 20 1993
STATE ENGINEER'S OFFICE

EMERY & ASSOCIATES

MAP
TO ACCOMPANY APPLICATION TO CHANGE THE POINT OF DIVERSION OF PERMIT NO. 44298 AND PERMIT NO. 55499
BY: ROUND MOUNTAIN GOLD INC. (INCORPORATED 1/1/1985)
FROM: AN UNDERGROUND SOURCE

DRAWN BY: R. KUJALA
DATE: DEC., 1993
SCALE: 1"= 400'

SURVEYED BY:
LOWELL D. EMERY, SWRS 536
P.O. BOX 84
FALLON, NV 89406

69670T 69604T 69603T 68894T 68475T 68461T 68460T 67190T 67189T 67188T 67187T 67022T 59218 59217