WATER TO BE TRANSFERRED UNDER THE ORR DITCH DECREE

NORTH

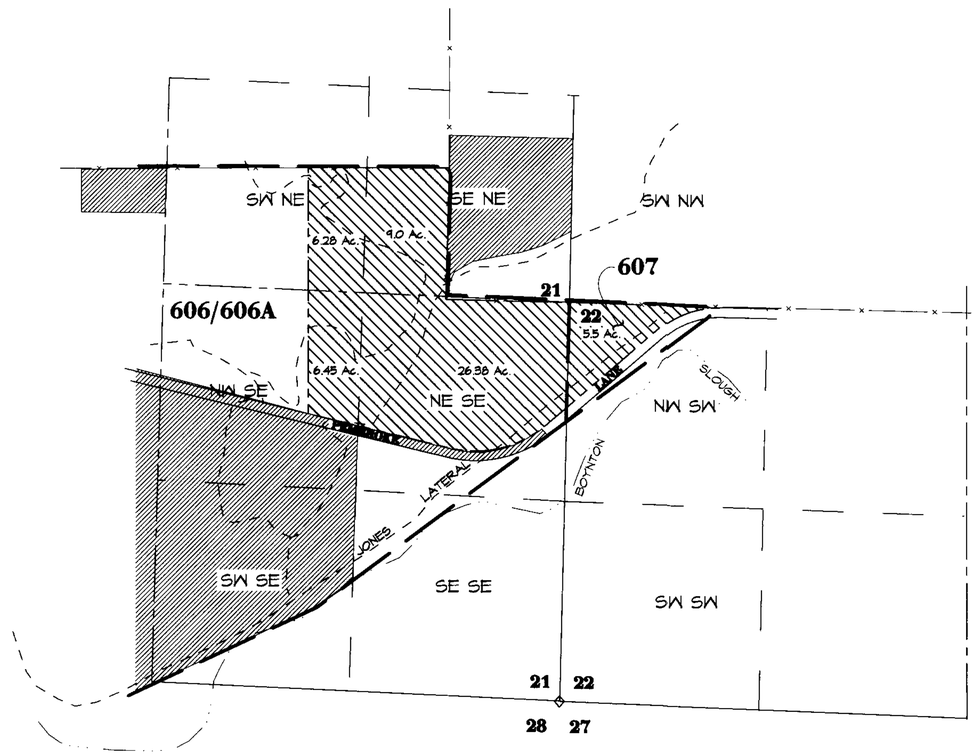

EXISTING PLACE OF USE
SECTIONS 21 & 22
T.19N., R.20E., M.D.M.

AREAS TO BE STRIPPED BY THIS APPLICATION

SECTION	TOWNSHIP	RANGE	SUBDIVISION	AREA
21	19N	20E	SE NE	9.0 Ac.
21	19N	20E	SW NE	6.28 Ac.
21	19N	20E	NW SE	6.45 Ac.
21	19N	20E	NE SE	26.38 Ac.
22	19N	20E	NW SW	5.50 Ac.

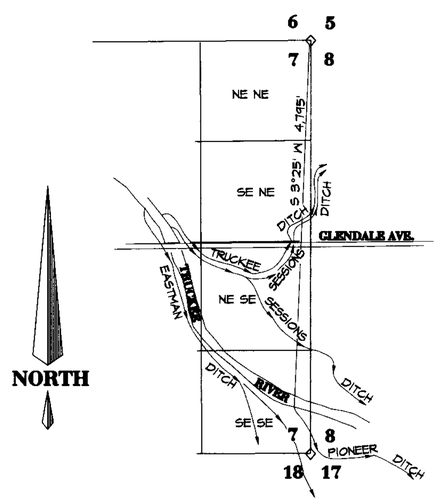

EXISTING POINT OF DIVERSION
SECTION 7
T.19N., R.20E., M.D.M.

(PER ORR DITCH DECREE)

SCALE 1" = 1000'

BASIS OF BEARINGS:

TIES TO THE POINTS OF DIVERSION ARE DEPICTED AS INDICATED WITHIN THE ORR DITCH DECREE.

STATE OF NEVADA
COUNTY OF WASHOE S.S.

I, GEORGE G. LINDESMITH, BEING DULY SWORN, DEPOSE AND SAY THAT THIS MAP CONSISTING OF 1 SHEET, HAS BEEN CORRECTLY DRAWN TO THE DESIGNATED SCALE, FROM DATA AVAILABLE IN THE OFFICE SIERRA PACIFIC POWER COMPANY, LOCATED AT RENO, NEVADA, THAT IT TRULY REPRESENTS THE PROPOSED CHANGES IN THE POINT OF DIVERSION, PLACE AND MANNER OF USE, OF THE WATERS OF THE TRUCKEE RIVER, IN WASHOE COUNTY, NEVADA, BY BARKER HOMES FOR SIERRA PACIFIC POWER COMPANY.

PROFESSIONAL LAND SURVEYOR STATE OF NEVADA GEORGE G. LINDESMITH 10-28-96 No.6306

George G. Lindesmith
GEORGE G. LINDESMITH
STATE WATER RIGHT SURVEYOR NO.704

ON October 28, 1996 PERSONALLY APPEARED BEFORE ME, A NOTARY PUBLIC George G. Lindesmith WHO ACKNOWLEDGED THAT HE EXECUTED THE WITHIN INSTRUMENT.

Rae Ann Loving
NOTARY PUBLIC

RAE ANN LOVING
Notary Public - State of Nevada
Appointment Recorded in Washoe County
MY APPOINTMENT EXPIRES APR. 21, 1997

PLACE OF USE AFTER TRANSFER

THE CERTIFIED WATER SERVICE AREA OF SIERRA PACIFIC POWER COMPANY AS DESIGNATED BY THE NEVADA PUBLIC SERVICE COMMISSION AND WHICH MAY BE AMENDED FROM TIME TO TIME.

POINT OF DIVERSION AFTER TRANSFER

EXISTING SIERRA PACIFIC POWER COMPANY POINTS OF DIVERSION AS DESCRIBED IN APPLICATION 58882, AND SHOWN ON THE SUPPORTING MAP ACCOMPANING SAID APPLICATION ON FILE WITH THE STATE ENGINEERS OFFICE.

LEGEND

- 435 — CLAIM BOUNDARY AS INDICATED WITHIN THE ORR DITCH DECREE
- EXISTING PLACE OF USE/PORTION OF AN O.D.D. CLAIM TO BE TRANSFERED UNDER THIS APPLICATION
- PORTION OF A CLAIM PREVIOUSLY TRANSFERED UNDER A PRIOR APPLICATION
- AN ENTIRE CLAIM PREVIOUSLY TRANSFERED UNDER PRIOR APPLICATIONS
- d — PORTION OF A CLAIM THAT IS DRY

SCALE: 1" = 500', OR AS NOTED

0 250 500 1000 1500 2000

TRI STATE SURVEYING, LTD
1925 E. PRATER WAY
SPARKS, NEVADA 89434
(702) 358-94-91 * FAX # 358-3664

STATE ENGINEER'S USE

Springfield 11-13-96 Map Table ✓
Areas to be stripped SECTION 22 · NW SW should be 4.00 acres (1.00 af/ac).

FILED
OCT 30 1996
STATE ENGINEER'S OFFICE

MAP TO ACCOMPANY APPLICATION TO CHANGE POINT OF DIVERSION, PLACE AND MANNER OF USE, FROM IRRIGATION TO MUNICIPAL AND DOMESTIC USE BY

BARKER HOMES
FROM
THE WATERS OF THE TRUCKEE RIVER IN WASHOE COUNTY, NEVADA

62546 62545