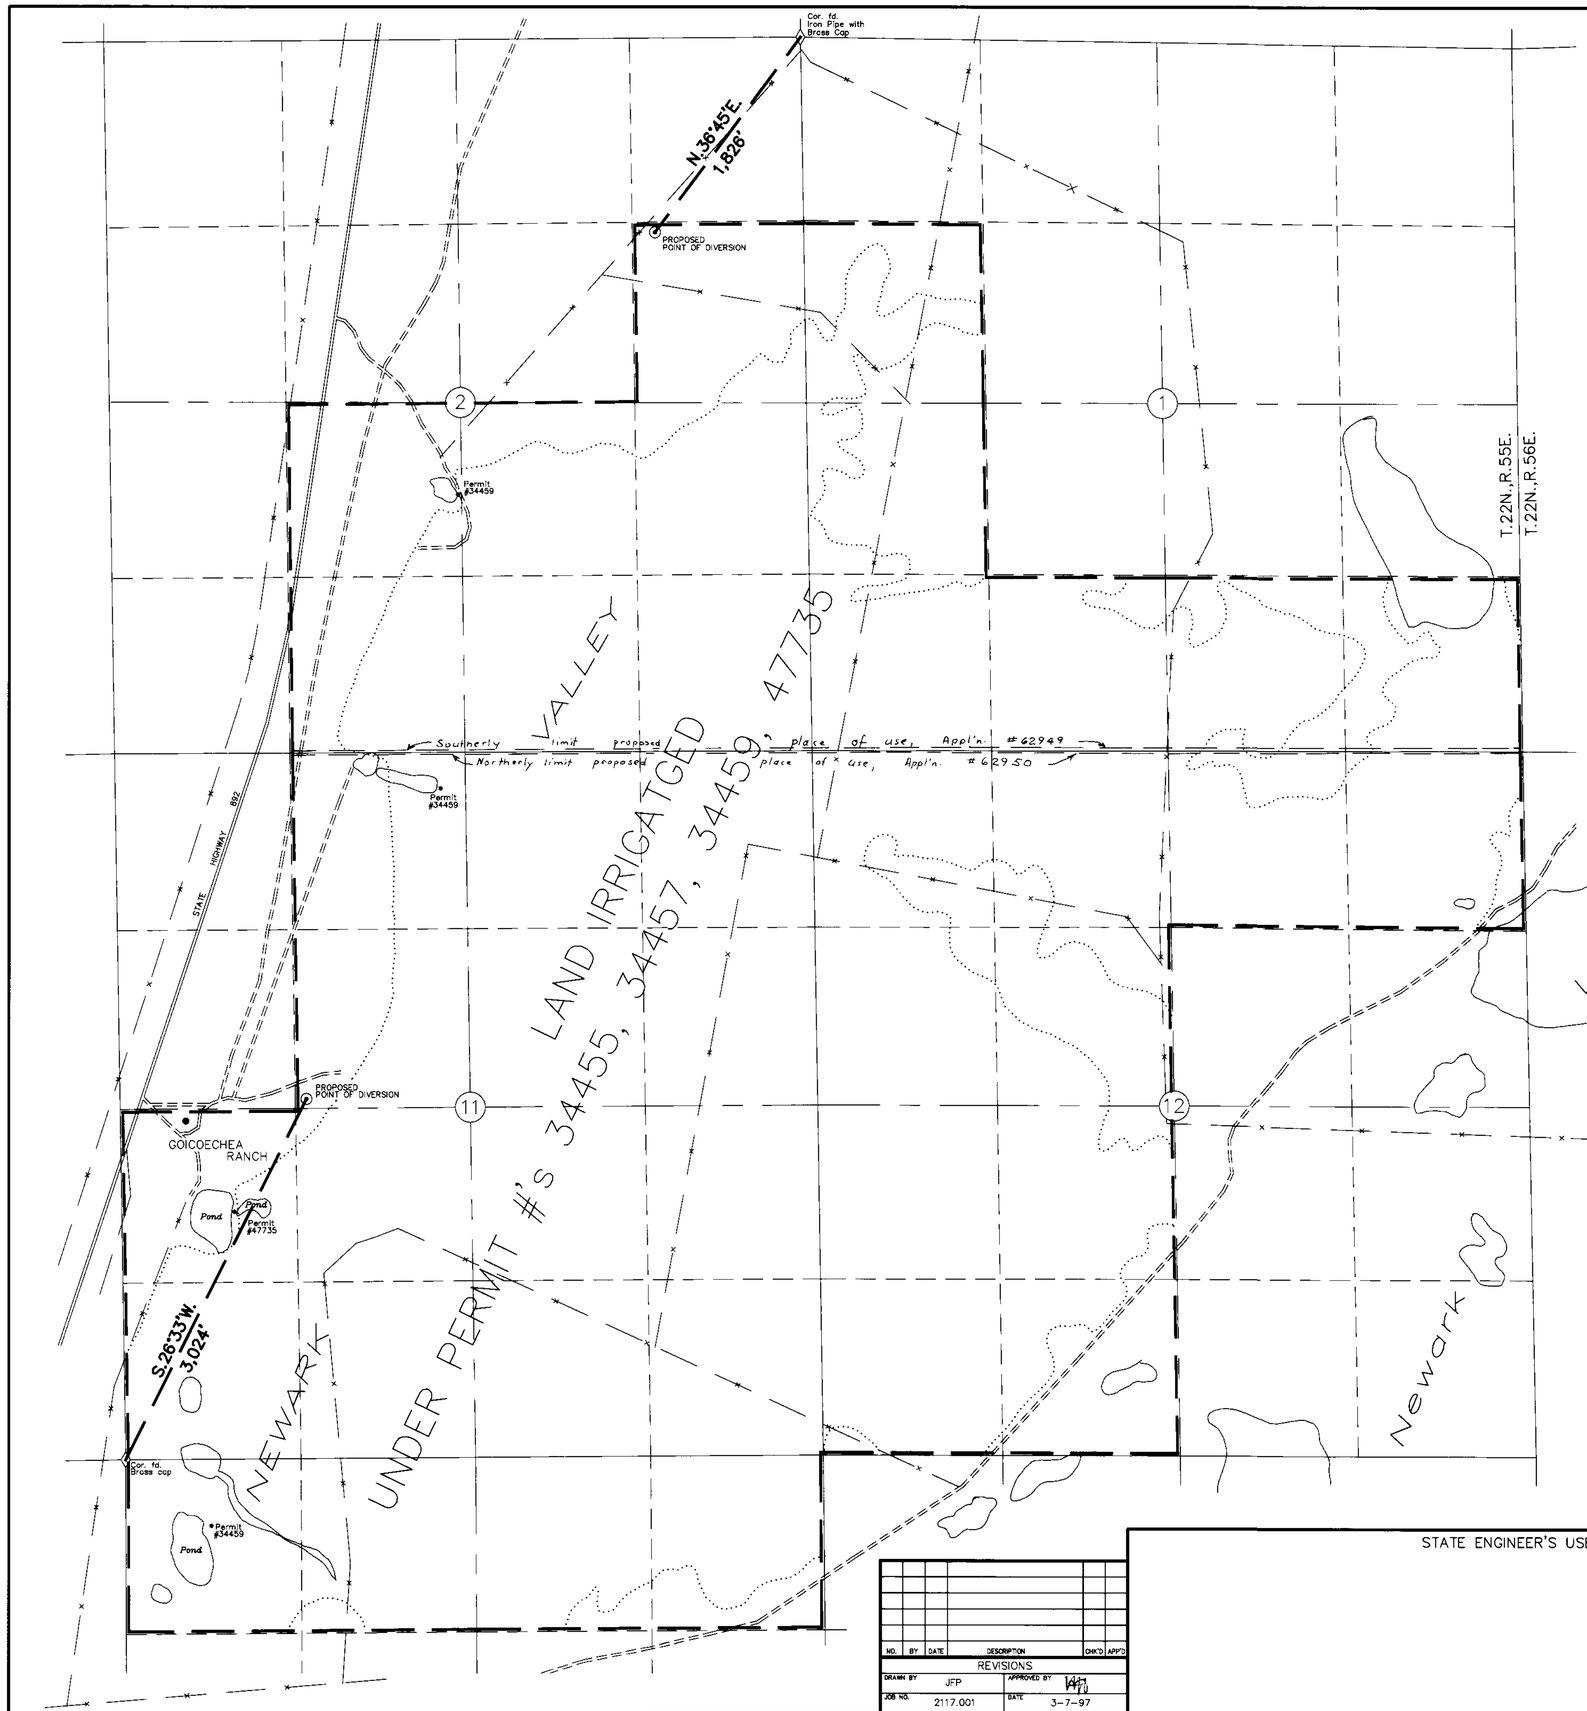

N

T.22N.,R.55E.
M.D.M.

STATE OF NEVADA }
COUNTY OF ELKO } S.S.

I, William A. Nisbet, being first duly sworn, depose and say that this map, consisting of one sheet, has been correctly drawn to the designated scale from field notes of a survey made by me, or under my supervision and direction, on the 7th day of March, 1997; that it truly and correctly represents the proposed location and extent of the works used to divert water from UNDERGROUND SOURCES, in WHITE PINE COUNTY, by SILVER STATE RANCHES, for IRRIGATION ~~AND DOMESTIC~~ purposes. That the existing points of diversion, the approximate location and size of the diverting channel, all reservoirs or basins, the location and names of all other works which cross or connect with the existing works, and the boundary of all lands, showing by 40-acre subdivisions the areas irrigated, are fully and correctly designated thereon.

William A. Nisbet
STATE WATER RIGHT SURVEYOR NO. 448

REGISTERED LAND SURVEYOR, STATE OF NEVADA
WILLIAM A. NISBET
3/21/97
No. 3805

Subscribed and sworn to before me this 21 day of March 1997.
NOTARY PUBLIC in and for ELKO COUNTY, NEVADA by William A. Nisbet

Coralee Griswold

CORALEE GRISWOLD
NOTARY PUBLIC
STATE OF NEVADA
ELKO COUNTY
My Comm. Expires JUL 12, 1998

BASIS OF BEARINGS: MAGNETIC, Var. 17° E.

LEGEND:

- PROPOSED PLACE OF USE
- BOUNDARY, PLACE OF USE UNDER PERMIT #'s 34455, 34457, 34459, 47735
- SECTION CORNER
- PROPOSED WELL

0 600 1200 1800
SCALE: 1"=600'

NO.	BY	DATE	DESCRIPTION	CHK'D	APP'D

REVISIONS

DRAWN BY JFP	APPROVED BY WAN
JOB NO. 2117.001	DATE 3-7-97

CHILTON Engineering and Surveying, LTD
(702) 738-2121 421 Court Street Elko, Nevada 89801

W97008 1/1

STATE ENGINEER'S USE (T-) 94 62950

FILED
MAR 20 1997
STATE ENGINEER'S OFFICE

RECEIVED
MAR 20 1997
STATE ENGINEER'S OFFICE

MAP TO ACCOMPANY
APPLICATION TO APPROPRIATE WATER

FOR **IRRIGATION ~~AND DOMESTIC~~ PURPOSES**
BY **SILVER STATE RANCHES**
FROM AN UNDERGROUND SOURCE
IN WHITE PINE COUNTY

W97008

D:\2117001\W97008 Sat Mar 15 19:28:54 1997

62950 62949